


PLAN	SURVEYED	DATE
	NOTE BOOK NO.	BY
	ALIGNMENT CHECKED	
	RT. OF WAY CHECKED	

PROFILE	SURVEYED	DATE
	NOTE BOOK NO.	BY
	STRUCTURE NOTATIONS CHECKED	
	IS AS NOTED	

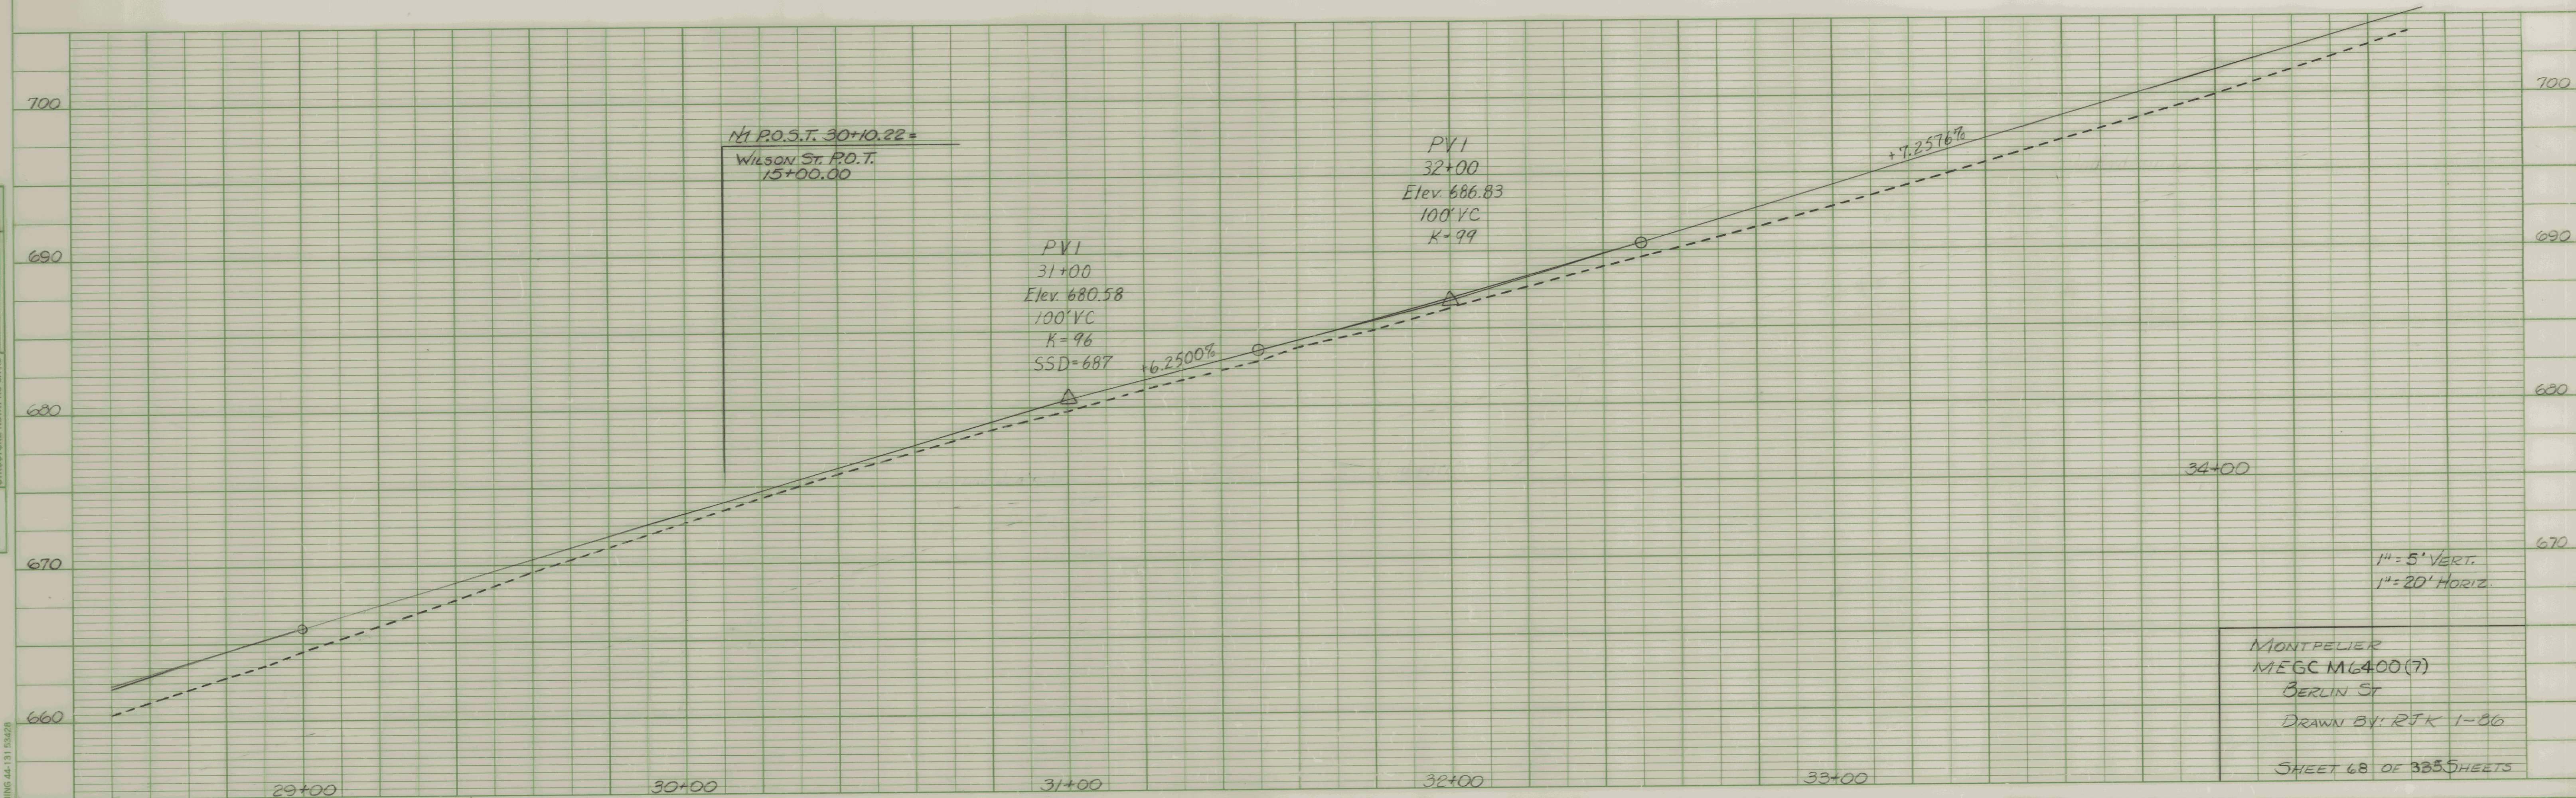

MONTPELIER
 M.E.G.C. M6400(7)
 BERLIN ST
 DRAWN BY: RTK 1-86
 SHEET 68 OF 325 SHEETS