


PLAN	NO.	NOTE BOOK	SURVEYED BY	DATE

PROFILE	NO.	NOTE BOOK	SURVEYED BY	DATE

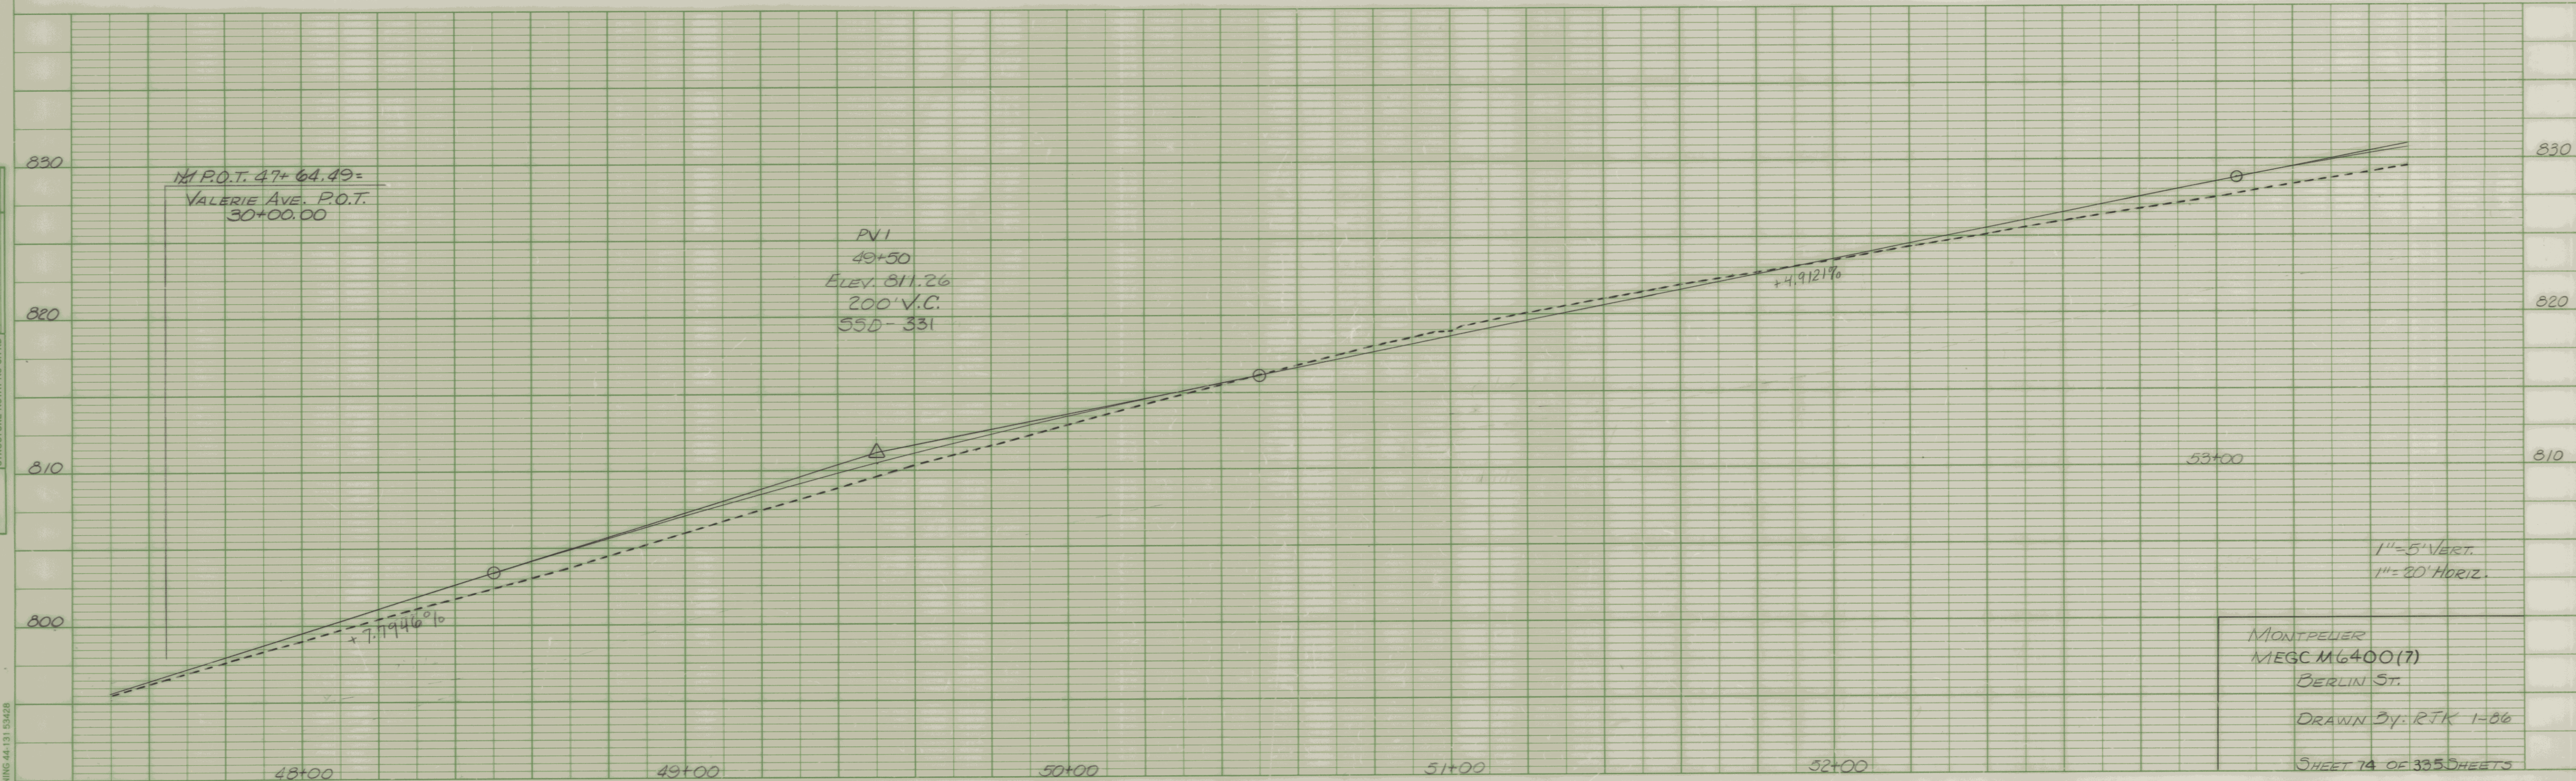

MONTPELIER  
 MEGC M6400(7)  
 BERLIN ST.  
 DRAWN BY: RJK 1-86  
 SHEET 74 OF 335 SHEETS