


PLAN	SURVEYED	DATE
NO. 100	ALIGNED	BY
	CHECKED	
	DATE	

PROFILE	SURVEYED	DATE
NO. 100	PLOTTED	BY
	CHECKED	
	DATE	

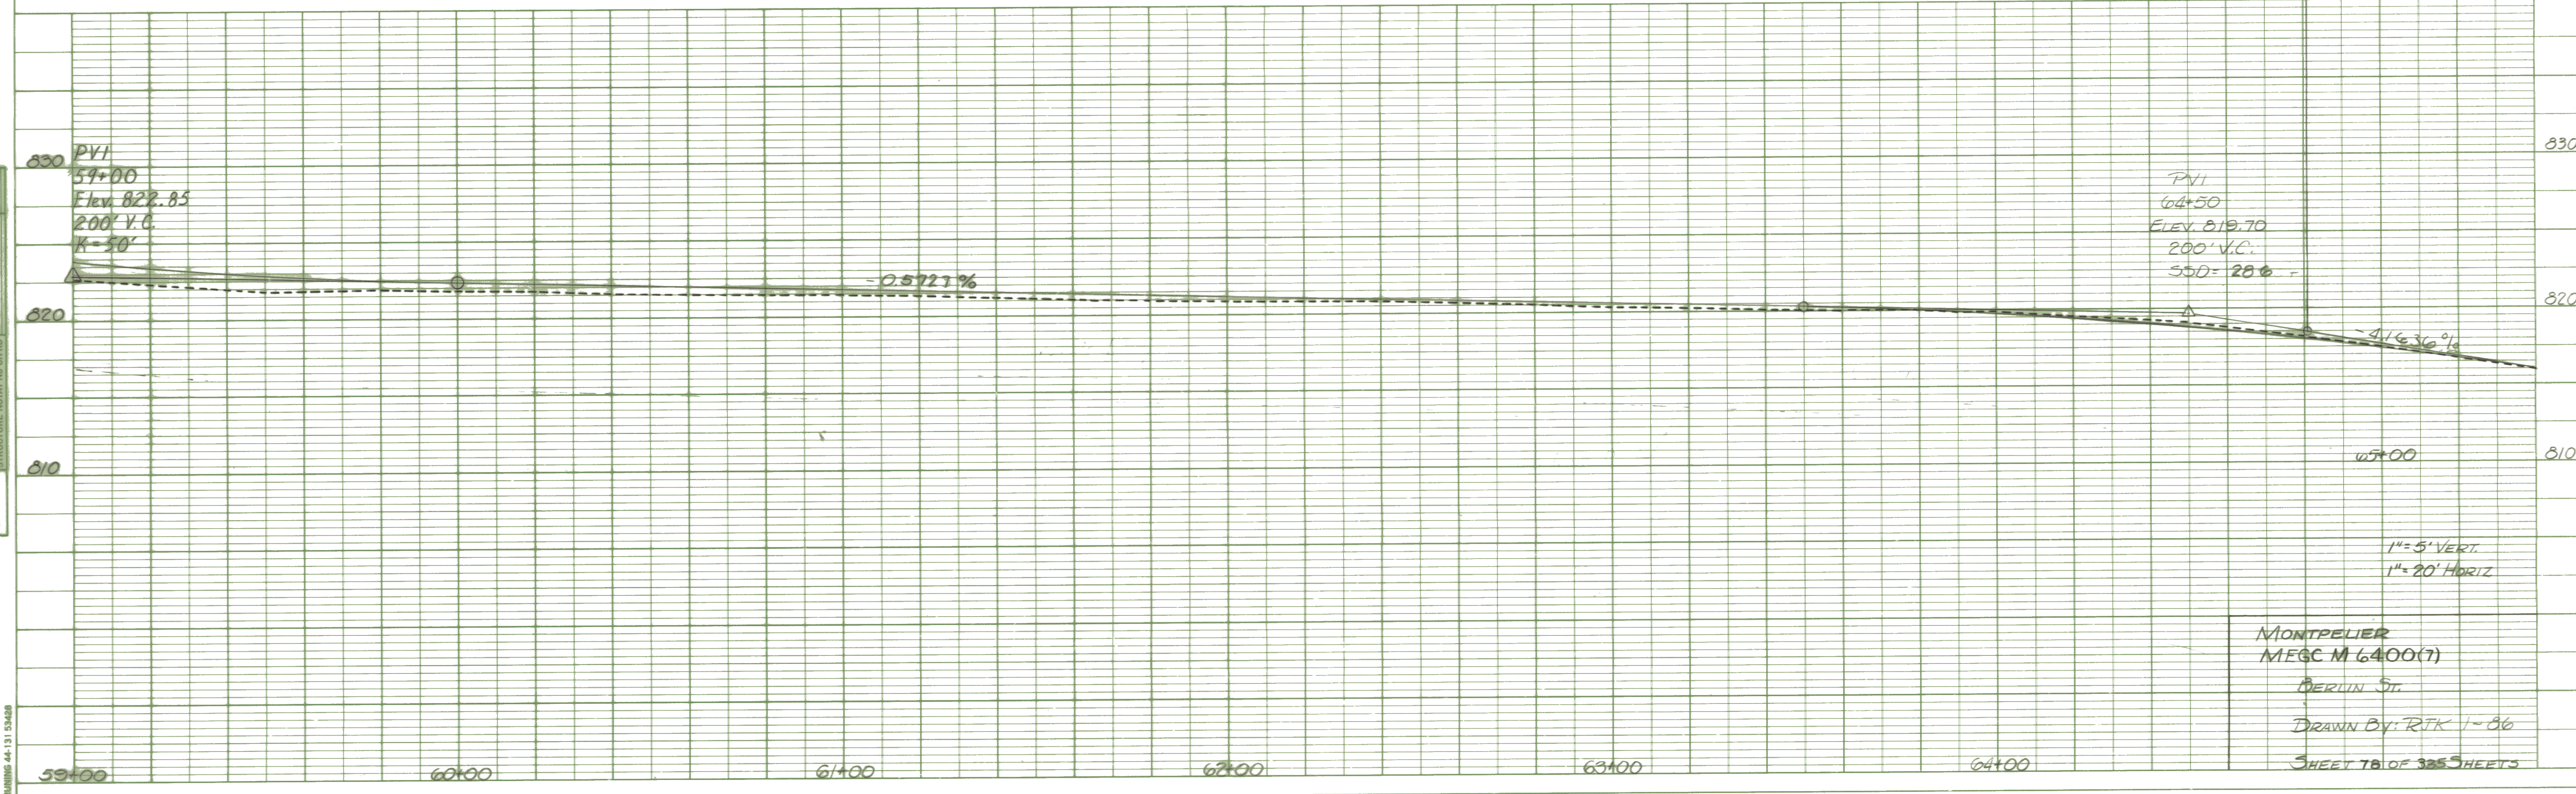

N.P.O.S.T. 64+80.85+  
 SHERWOOD DR. P.O.T.  
 40+00.00