


DATE	
BY	
SURVEYED	
PLOTTED	
ALIGNMENT CHECKED	
NOTED	
NO.	
PLAN	

DATE	
BY	
SURVEYED	
GRADES CHECKED	
B.M. NOTED	
STRUCTURE NOTED	
NO.	
PROFILE	

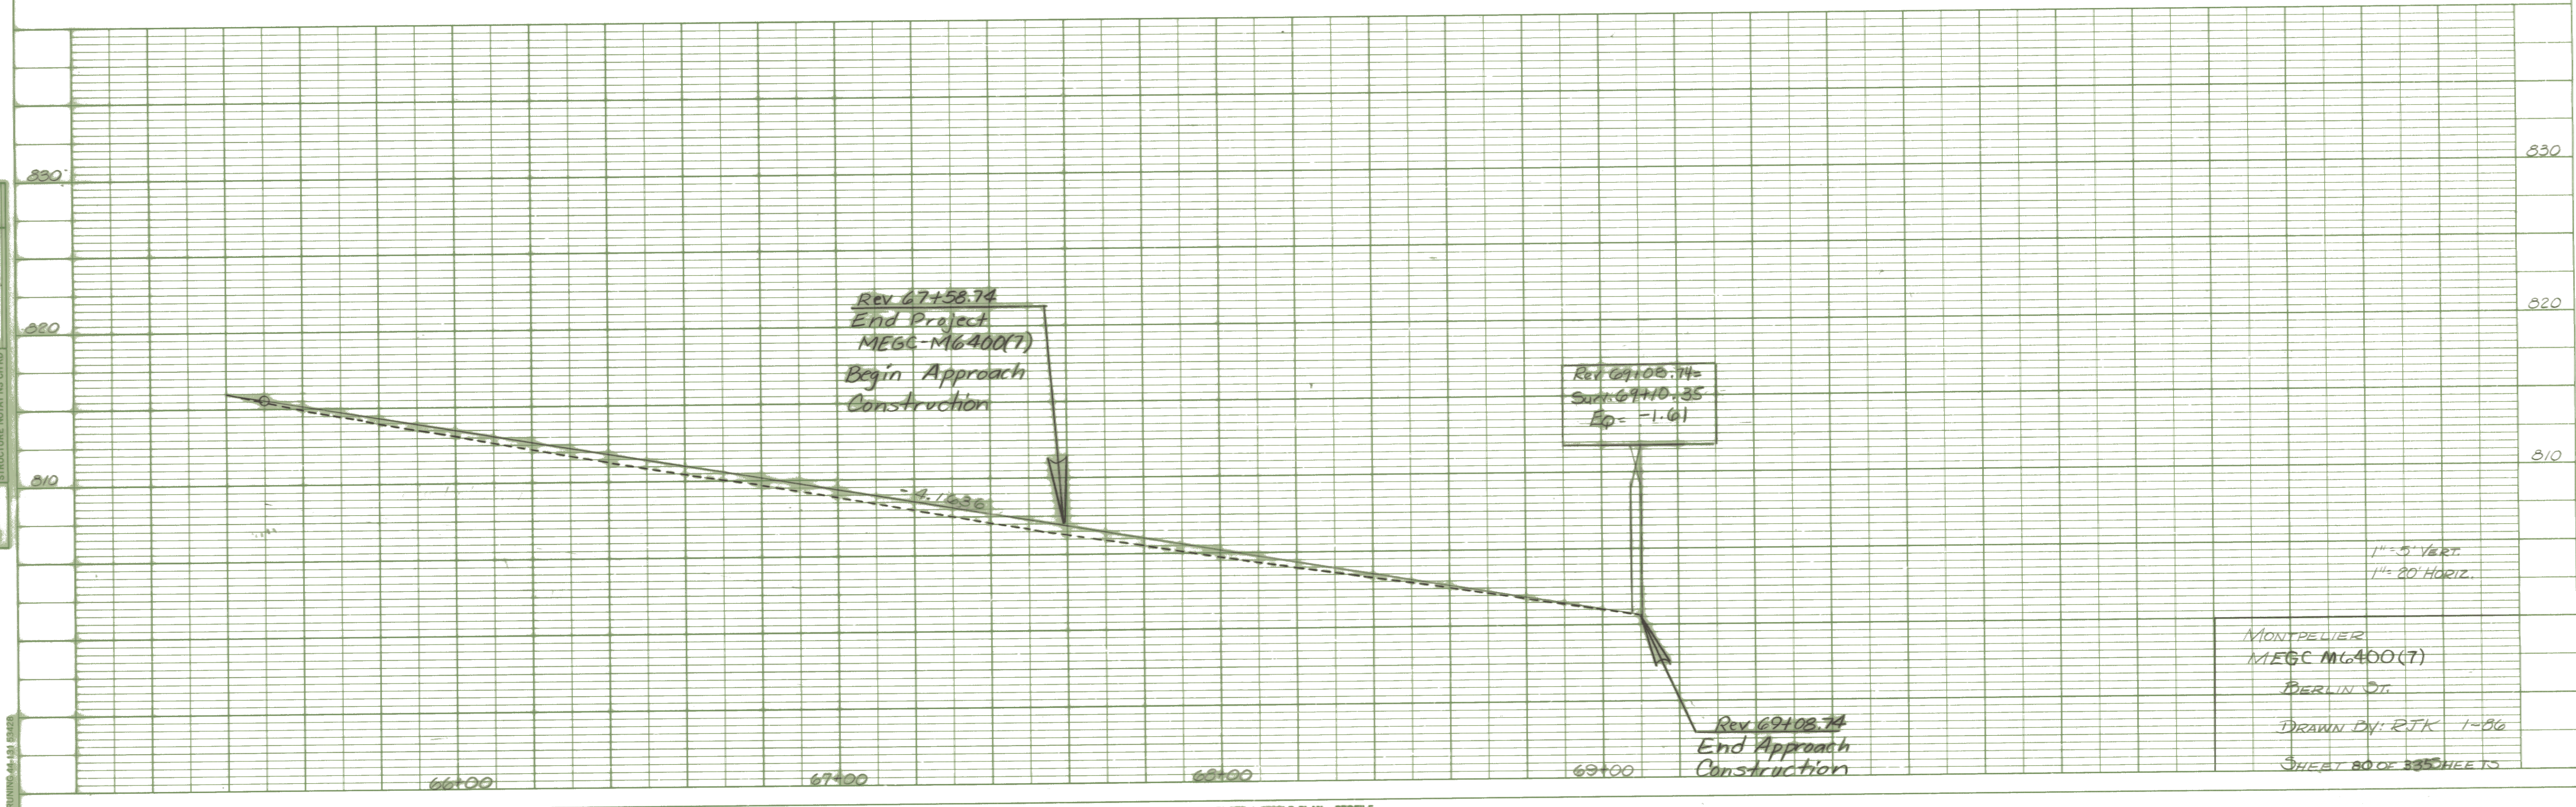

BRUNING 44-181-8828