
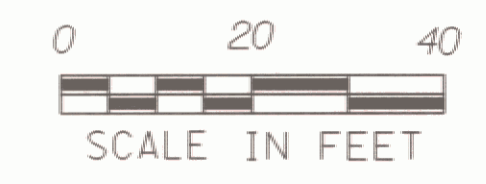
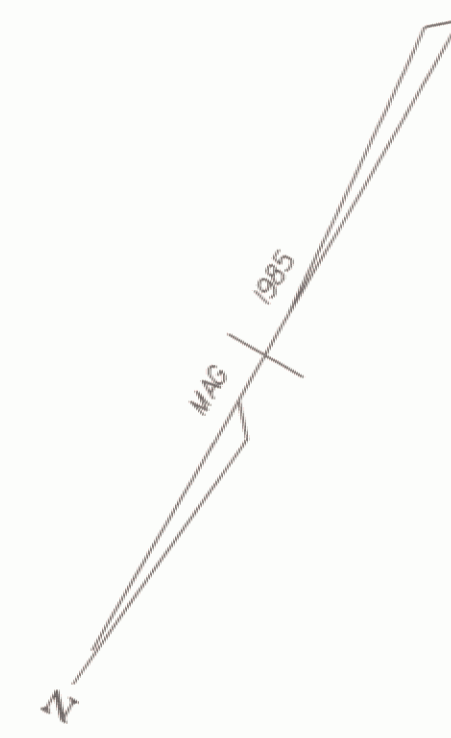


✓ CONSTRUCT DRIVE
 LEFT
 68+28 24' WIDE(GRAVEL)

✓ REV 69+08.74 =
 SURV. 69+10.35
 EQ=-1.61
 END APPROACH

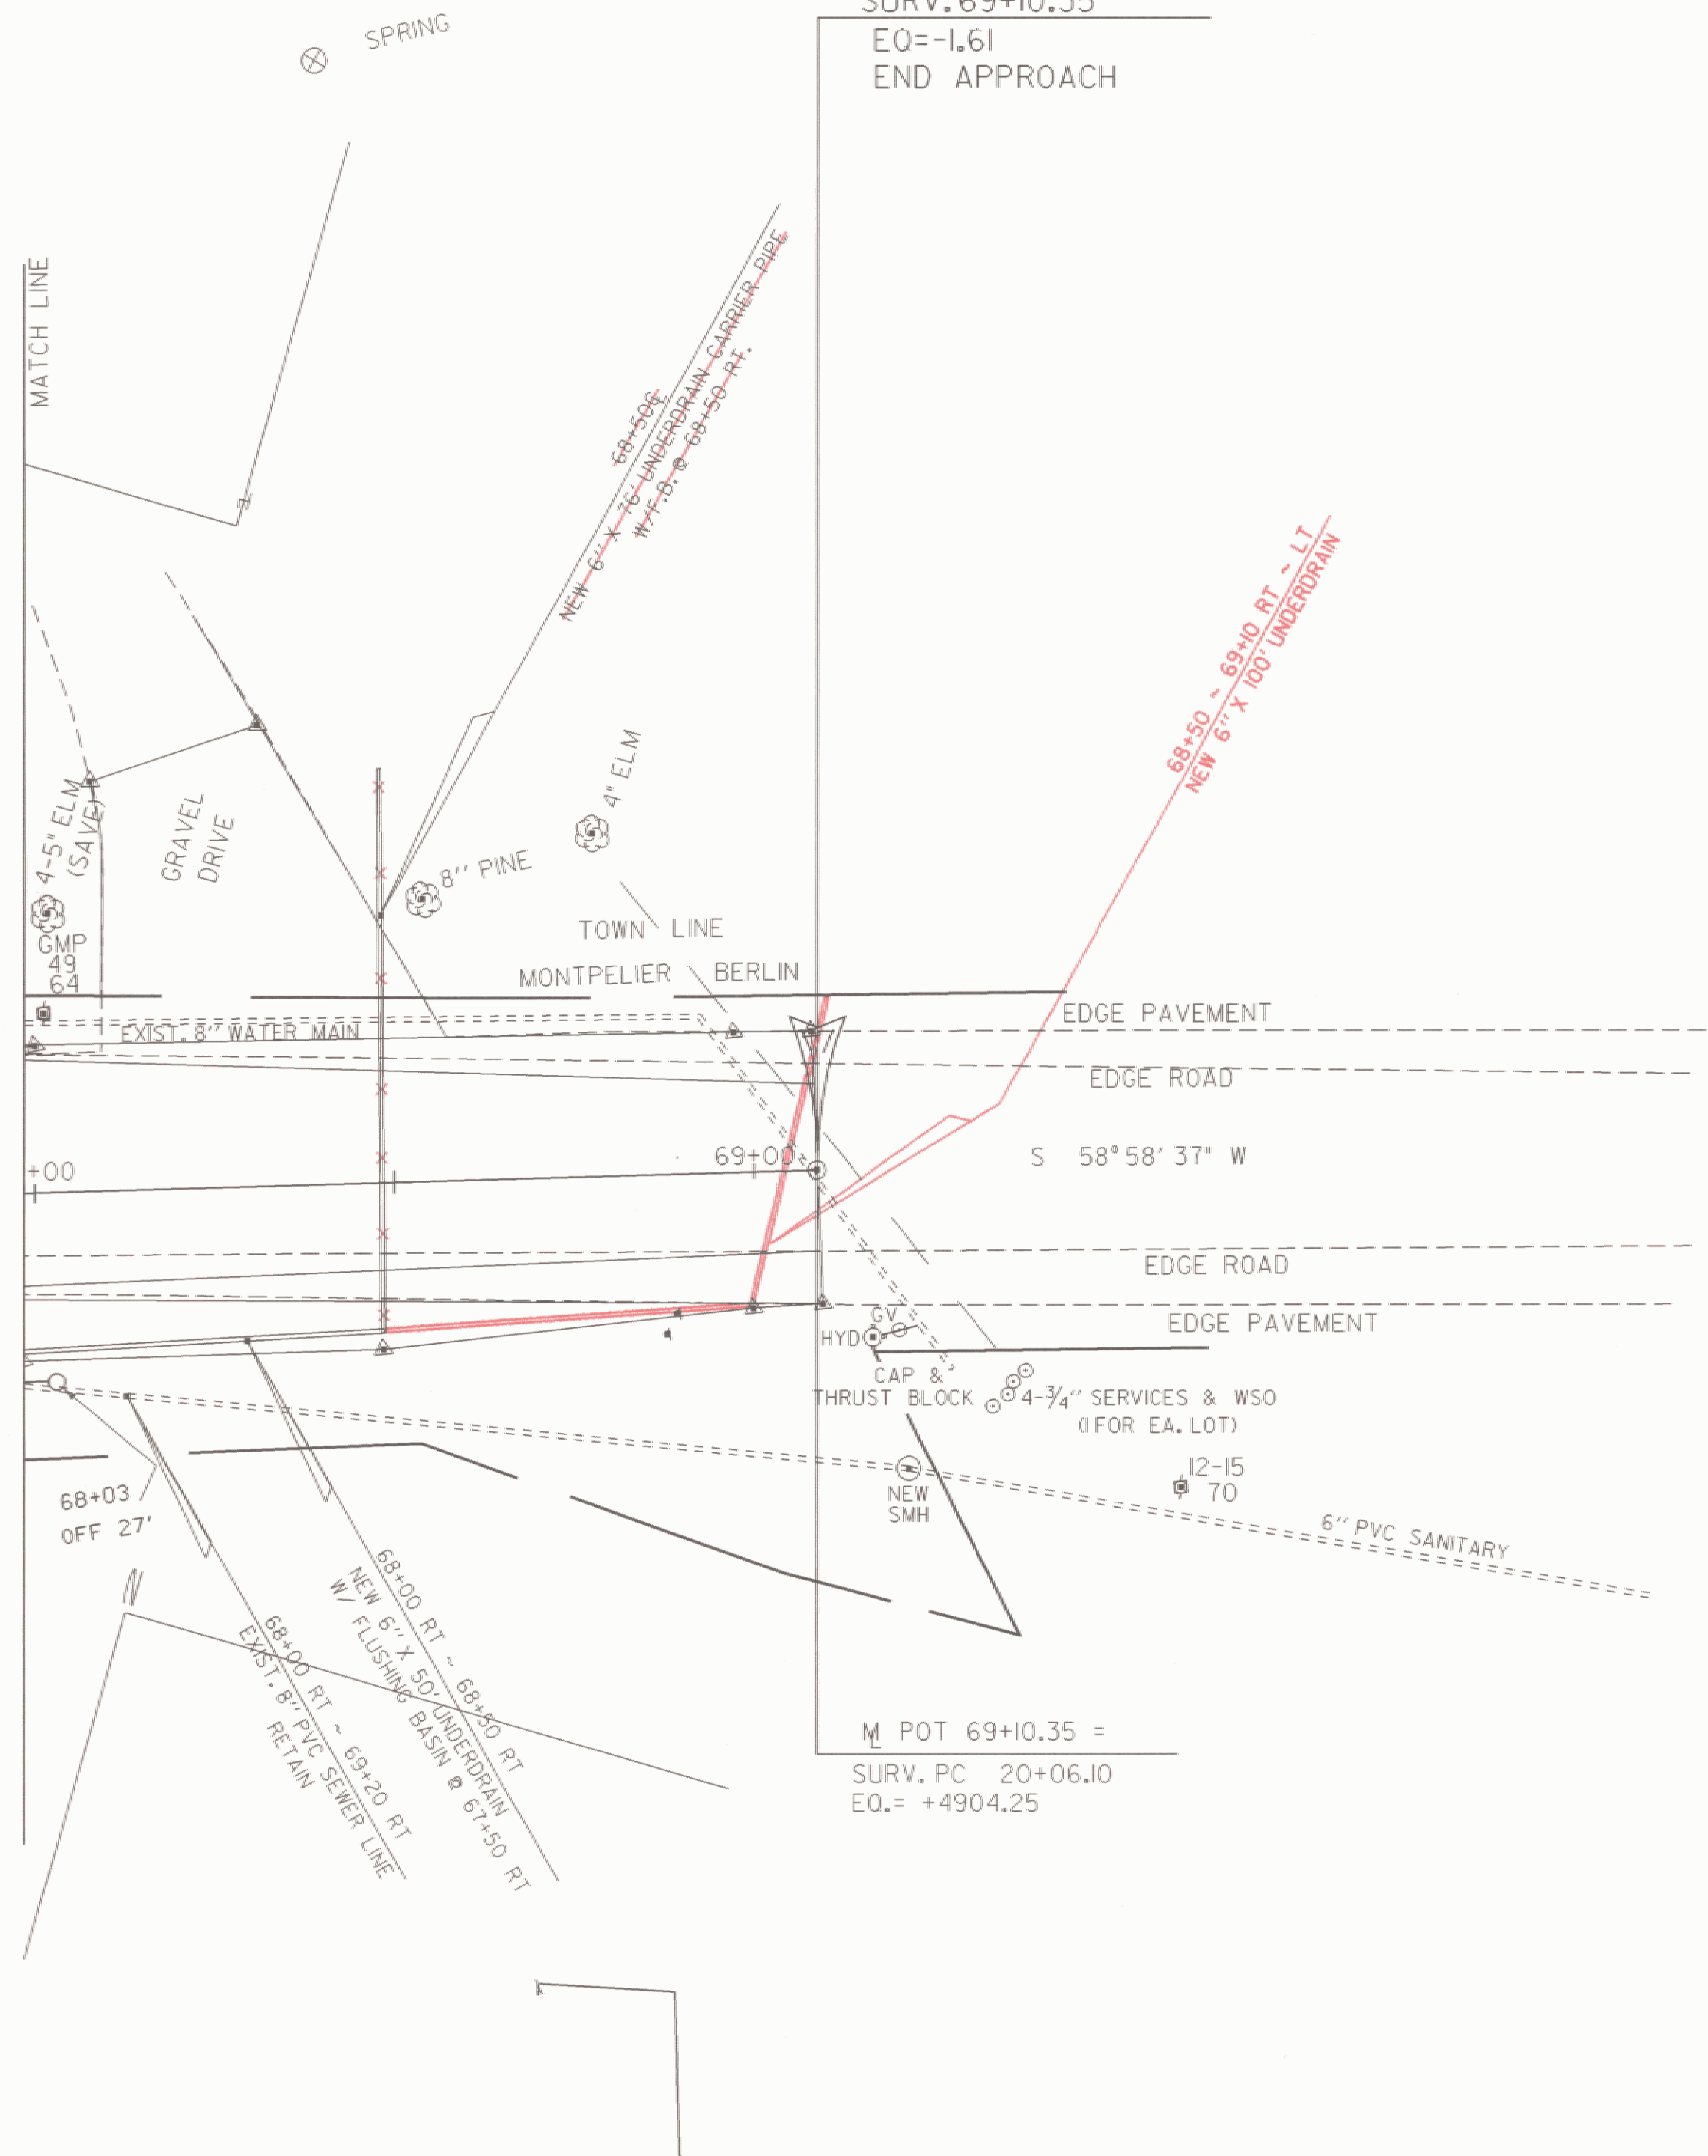

DATUM
 VERTICAL NGVD 1929
 HORIZONTAL N/A

**ARCHIVED
 ON CADD**

SURVEYED BY	MOREAU	DATE	7-85
DRAWN BY	COTA/NAI LOR	DATE	4-88
SQUAD LEADER	SHERIDAN		
DESIGN FILE NO.	ZGO:[50,116]PETED.DGN; 1		
IPARM FILE	PETED11.PRF	DATE PLOTTED	14-FEB-1996
PROJ. NAME	MONTPELIER		
PROJ. NO.	MEGC M 6400(7)		
SHEET	81	OF	355 SHEETS