

Rev.	Description	By	Date
1	VALVE/HYD. LOCATION	LBL	3/19/90

CITY OF MONTPELIER
 BERLIN STREET RESTORATION
 WATER MAIN INSTALLATION PLAN
 STA. 39+00 TO STA. 45+00

MONTPELIER, VERMONT

DH
 Dufresne-Henry Inc.
 58 East State Street
 Montpelier, VT 05602

Client No. 616040
 Proj. Manager T. NESBITT
 Proj. Designer L. BLACKLEY
 Drawn By K. FLANDERS
 Checked By T. NESBITT
 Scale 1" = 20'
 Approved *[Signature]*
 Date APRIL 11, 1989

Sheet 6 of 19
 D 616040-06

REV CURVE # 5
 $\Delta = 3^{\circ}24'07"$ LT.
 $D = 1^{\circ}00'00"$
 $R = 5729.58'$
 $T = 170.15'$
 $L = 340.21'$
 $E = 2.53'$


HYDRANT
 6" x 6" TEE, MJ
 6" x 6" D.I. CLASS 52
 6" GATE VALVE, MJ W/BOX
 6" NIPPLE, VARIABLE LENGTH
 HYDRANT

FUTURE CONNECTION
 6" x 6" TEE, MJ
 6" NIPPLE, VARIABLE LENGTH
 6" GATE VALVE, MJ W/BOX
 6" NIPPLE, VARIABLE LENGTH
 6" x 1/2" BEND, MJ
 55' LENGTH 8" D.I. CLASS 52
 MANUAL AIR RELEASE/CHLORINE
 INJECTION POINT
 6" CAP, MJ

WATER SERVICE (TYP.)
 COPPER WATER SERVICE,
 SHUT OFF WITH BOX SEE
 SHEET 18 OF 19 FOR DETAIL

**THIS SHEET FOR
 UTILITIES USE ONLY**

NOTE
 The Owner reserves the right to delete any or all of the above utility relocation work and perform the relocation work with their own forces. The contractor should confirm material and quantities prior to ordering.

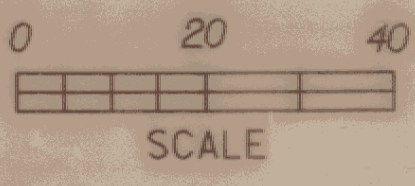

DATUM
 VERTICAL NGVD 1929
 HORIZONTAL N/A

15-FEB-1989

SURVEYED BY	MOREAU	DATE	7-85
DRAWN BY	DAYE/REDMOND	DATE	4-88
SQUAD LEADER	SHERIDAN		
DESIGN FILE NO.	768033	DATE PLOTTED	
PROJ. NAME	MONTPELIER		
PROJ. NO.	MEGC M6400(7)		
SHEET 90 OF 335 SHEETS			