



PROFILE
SCALE: HORIZ 1" = 20'
VERT 1" = 5'

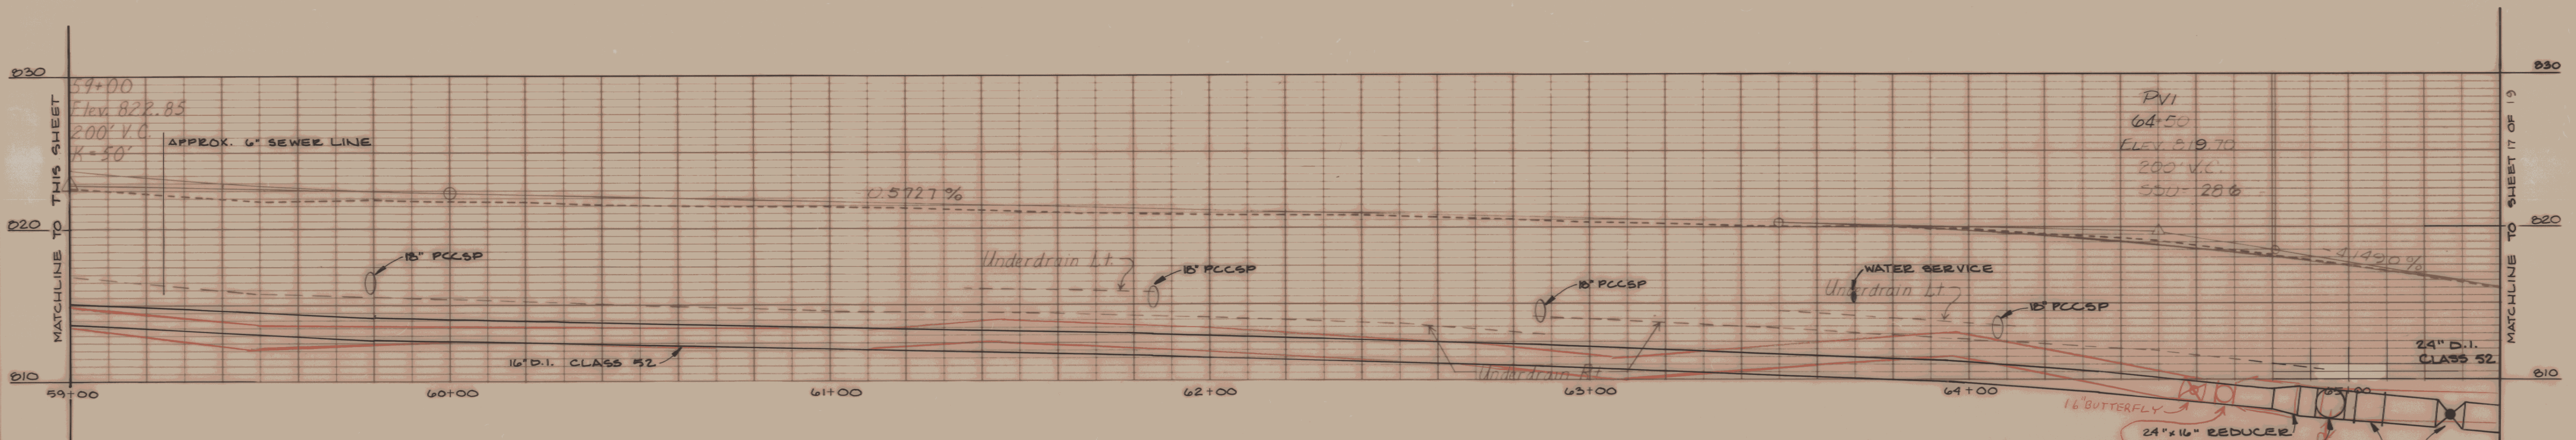

PROFILE
SCALE: HORIZ 1" = 20'
VERT 1" = 5'

THIS SHEET FOR
UTILITIES USE ONLY

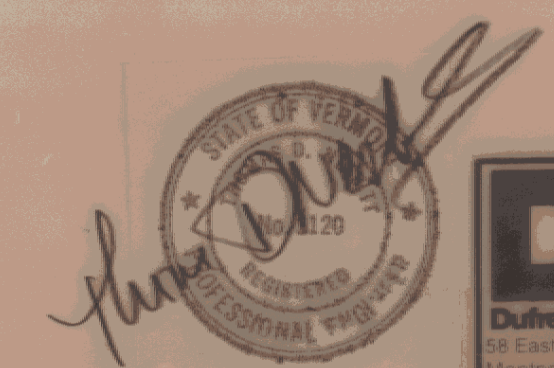

SHEET 95 OF 335
CITY OF MONTPELIER
BERLIN STREET RESTORATION
WATER MAIN PROFILE
MONTPELIER, VERMONT
Client No. 615040 Proj. Mgr. TDN Date 4.14.09 B No. 16