


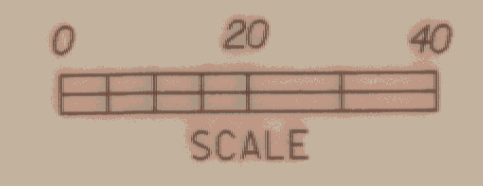
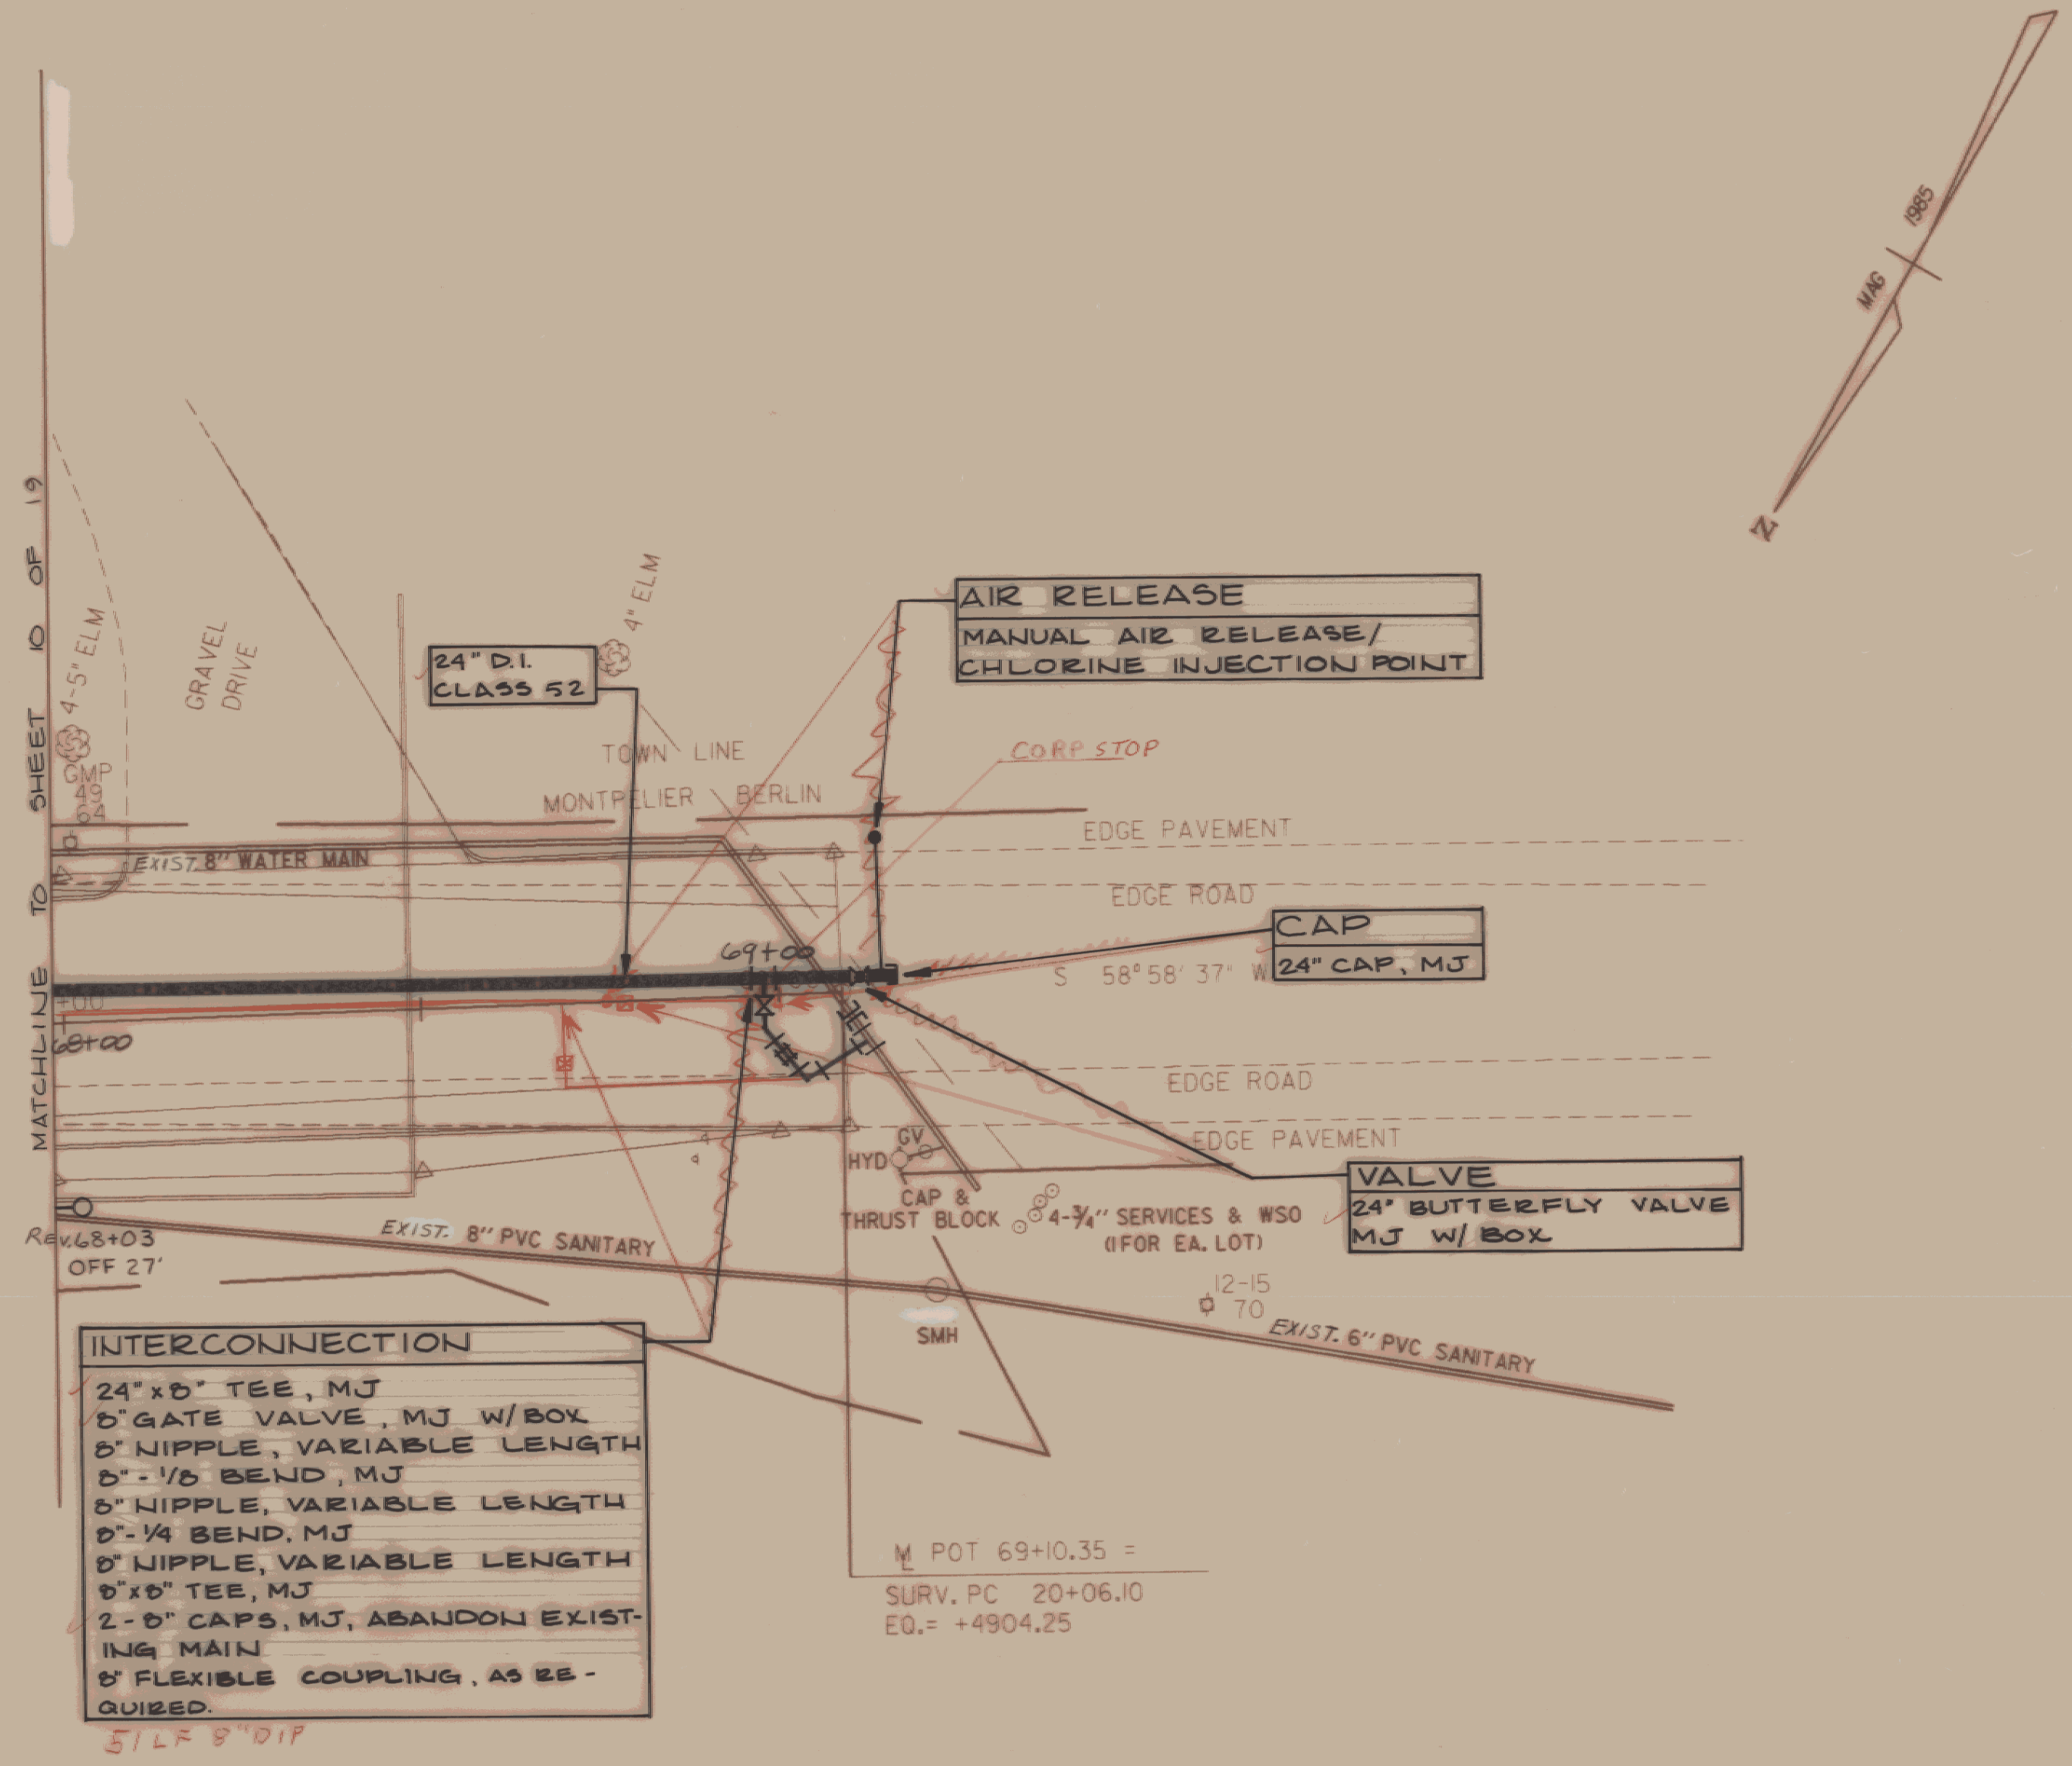
Rev.	Description	By	Date

CITY OF MONTPELIER  
**BERLIN STREET RESTORATION**  
**WATER MAIN INSTALLATION PLAN**  
 STA. 11+57 TO STA. 17+00

MONTPELIER, VERMONT

	Client No.	616040
	Proj. Manager	T. NESBITT
	Proj. Designer	L. BLACKKEY
	Drawn By	K. FLANDERS
	Checked By	T. NESBITT
Scale	1" = 30'	
Approved	<i>[Signature]</i>	
Date	APRIL 14, 1989	D 616040-11

Sheet 11 of 19



**THIS SHEET FOR  
 UTILITIES USE ONLY**

DATUM  
 VERTICAL NGVD 1929  
 HORIZONTAL N/A

**NOTE**  
 The Owner reserves the right to delete any or all of the above utility relocation work and perform the relocation work with their own forces. The contractor should confirm material and quantities prior to ordering.

15-FEB-1989

SURVEYED BY	MOREAU	DATE	7-85
DRAWN BY	DAYE/REDMOND	DATE	4-88
SQUAD LEADER	SHERIDAN		
DESIGN FILE NO.	768033	DATE PLOTTED	
PROJ. NAME	MONTPELIER		
PROJ. NO.	MEGC 6400(7)		
SHEET	97 OF 335	SHEETS	