

SERVICE CONNECTION SCHED			
HOUSE #	GMP	NET	CATV
145	3" @ 30 L.F.	1" @ 5 L.F.	1" @ 5 L.F.
147	3" @ 25 L.F.	1" @ 25 L.F.	1" @ 25 L.F.
149	3" @ 20 L.F.	1" @ 20 L.F.	1" @ 20 L.F.
153	3" @ 50 L.F.	4" @ 30 L.F.	2" @ 50 L.F.
155	3" @ 10 L.F.	4" @ 40 L.F.	2" @ 45 L.F.
157	3" @ 15 L.F.	1" @ 15 L.F.	1" @ 15 L.F.
159	3" @ 40 L.F.	-	-
162	3" @ 90 L.F.	1" @ 25 L.F.	-

Rev.	Description	By	Date
1	NEW GMP/NET/CATV TERMINATION	JTM	4/10/92
2	NET SERVICES TO 4"	JTM	6/18/92
3	MOVE POLE TO STA 11+71	JTM	6/18/92
4	FEED #149, 153 & 155 FROM UPPER NET VAULT	JTM	6/18/92
5	SWITCH GMP/NET FEED #147 & 149	JTM	6/18/92
6	MOVE GMP FEED #155	JTM	6/18/92
7	ADD LVPP @ 14 STA 13+00	JTM	6/18/92
8	ADD 2" PE VAULT DRAIN	JTM	6/18/92
9	ADD SERVICE CONNECTION SCHED	JTM	6/18/92

CITY OF MONTPELIER

BERLIN STREET RESTORATION PROJECT

UNDERGROUND UTILITIES RELOCATION PLAN

MONTPELIER, VERMONT

Client No. 618040

Proj. Manager A. TUSCANY

Proj. Designer J. MYERS

Drawn By J. SHATNEY

Checked By L. LACKEY


Scale 1" = 20'

Approved _____

Date 27 NOV. 1990


Sheet 1 of 7

D 618040-01

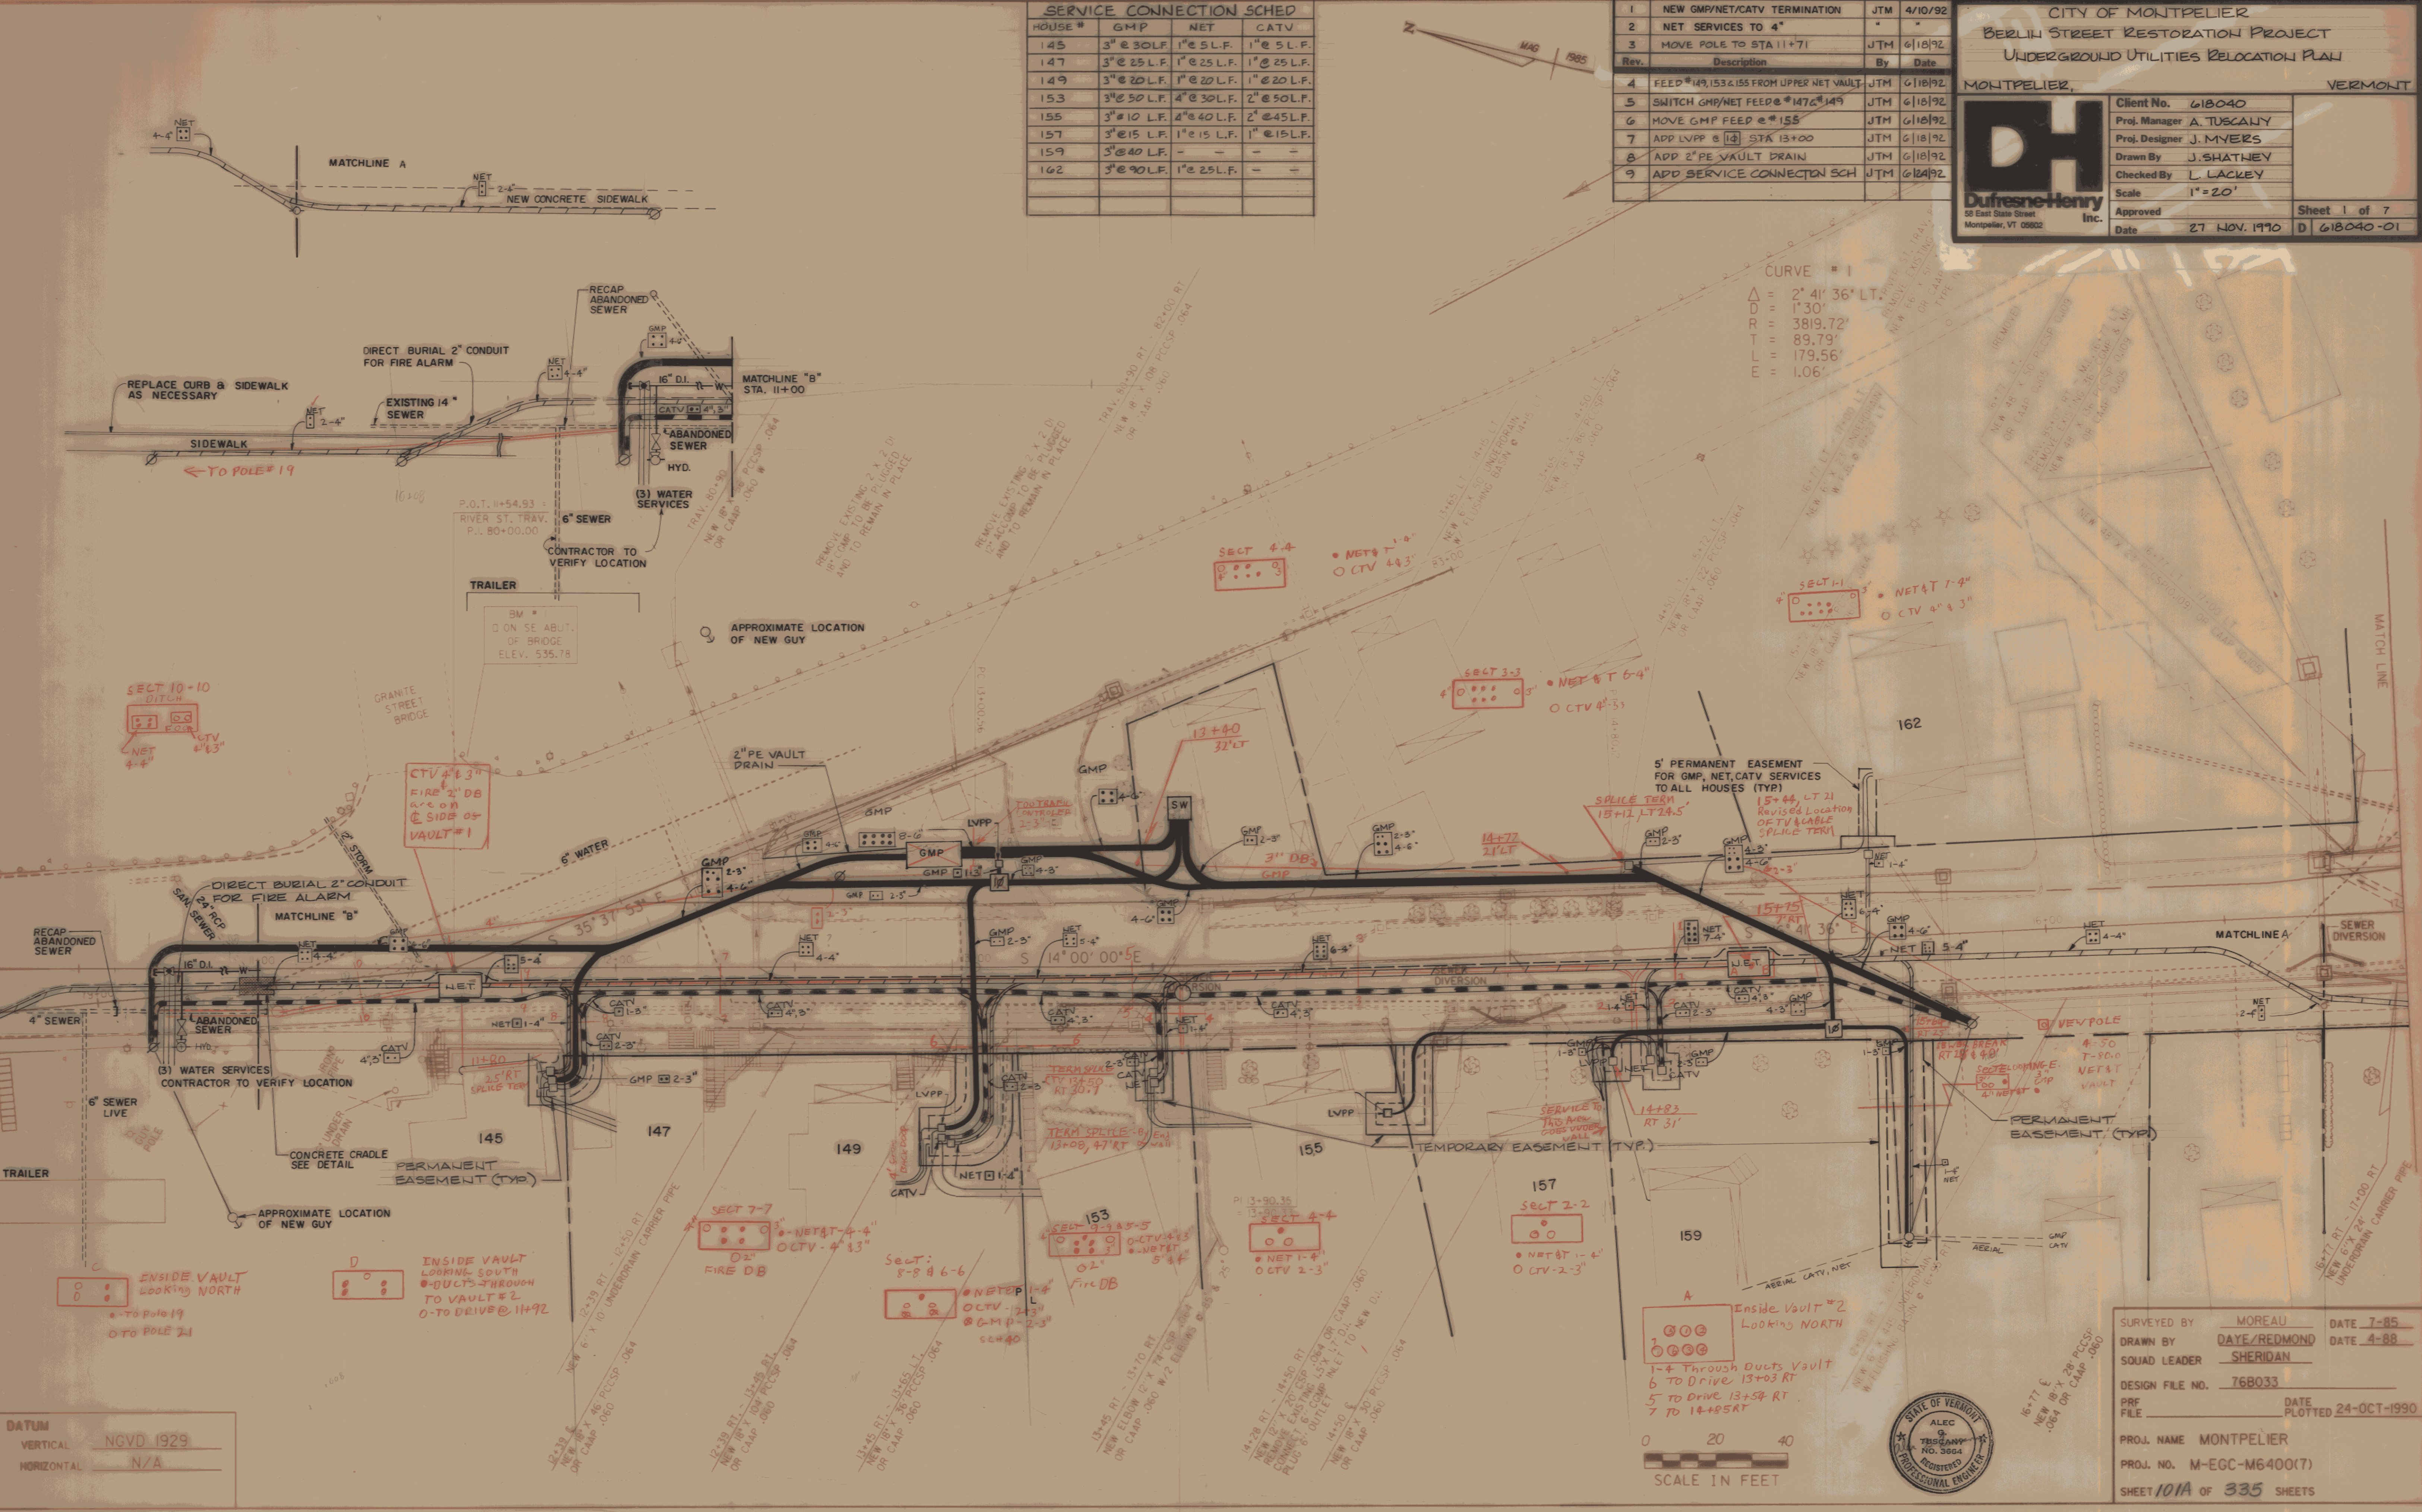

DATUM
VERTICAL NGVD 1929
HORIZONTAL N/A

0 20 40
SCALE IN FEET

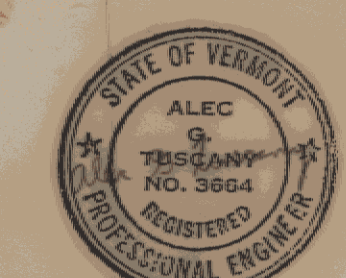

SURVEYED BY	MOREAU	DATE	7-85
DRAWN BY	DAYE/REDMOND	DATE	4-88
SQUAD LEADER	SHERIDAN		
DESIGN FILE NO.	76B033		
PRF FILE		DATE PLOTTED	24-OCT-1990
PROJ. NAME	MONTPELIER		
PROJ. NO.	M-EGC-M6400(7)		
SHEET	101A	OF	335 SHEETS