



NET PROFILE ②

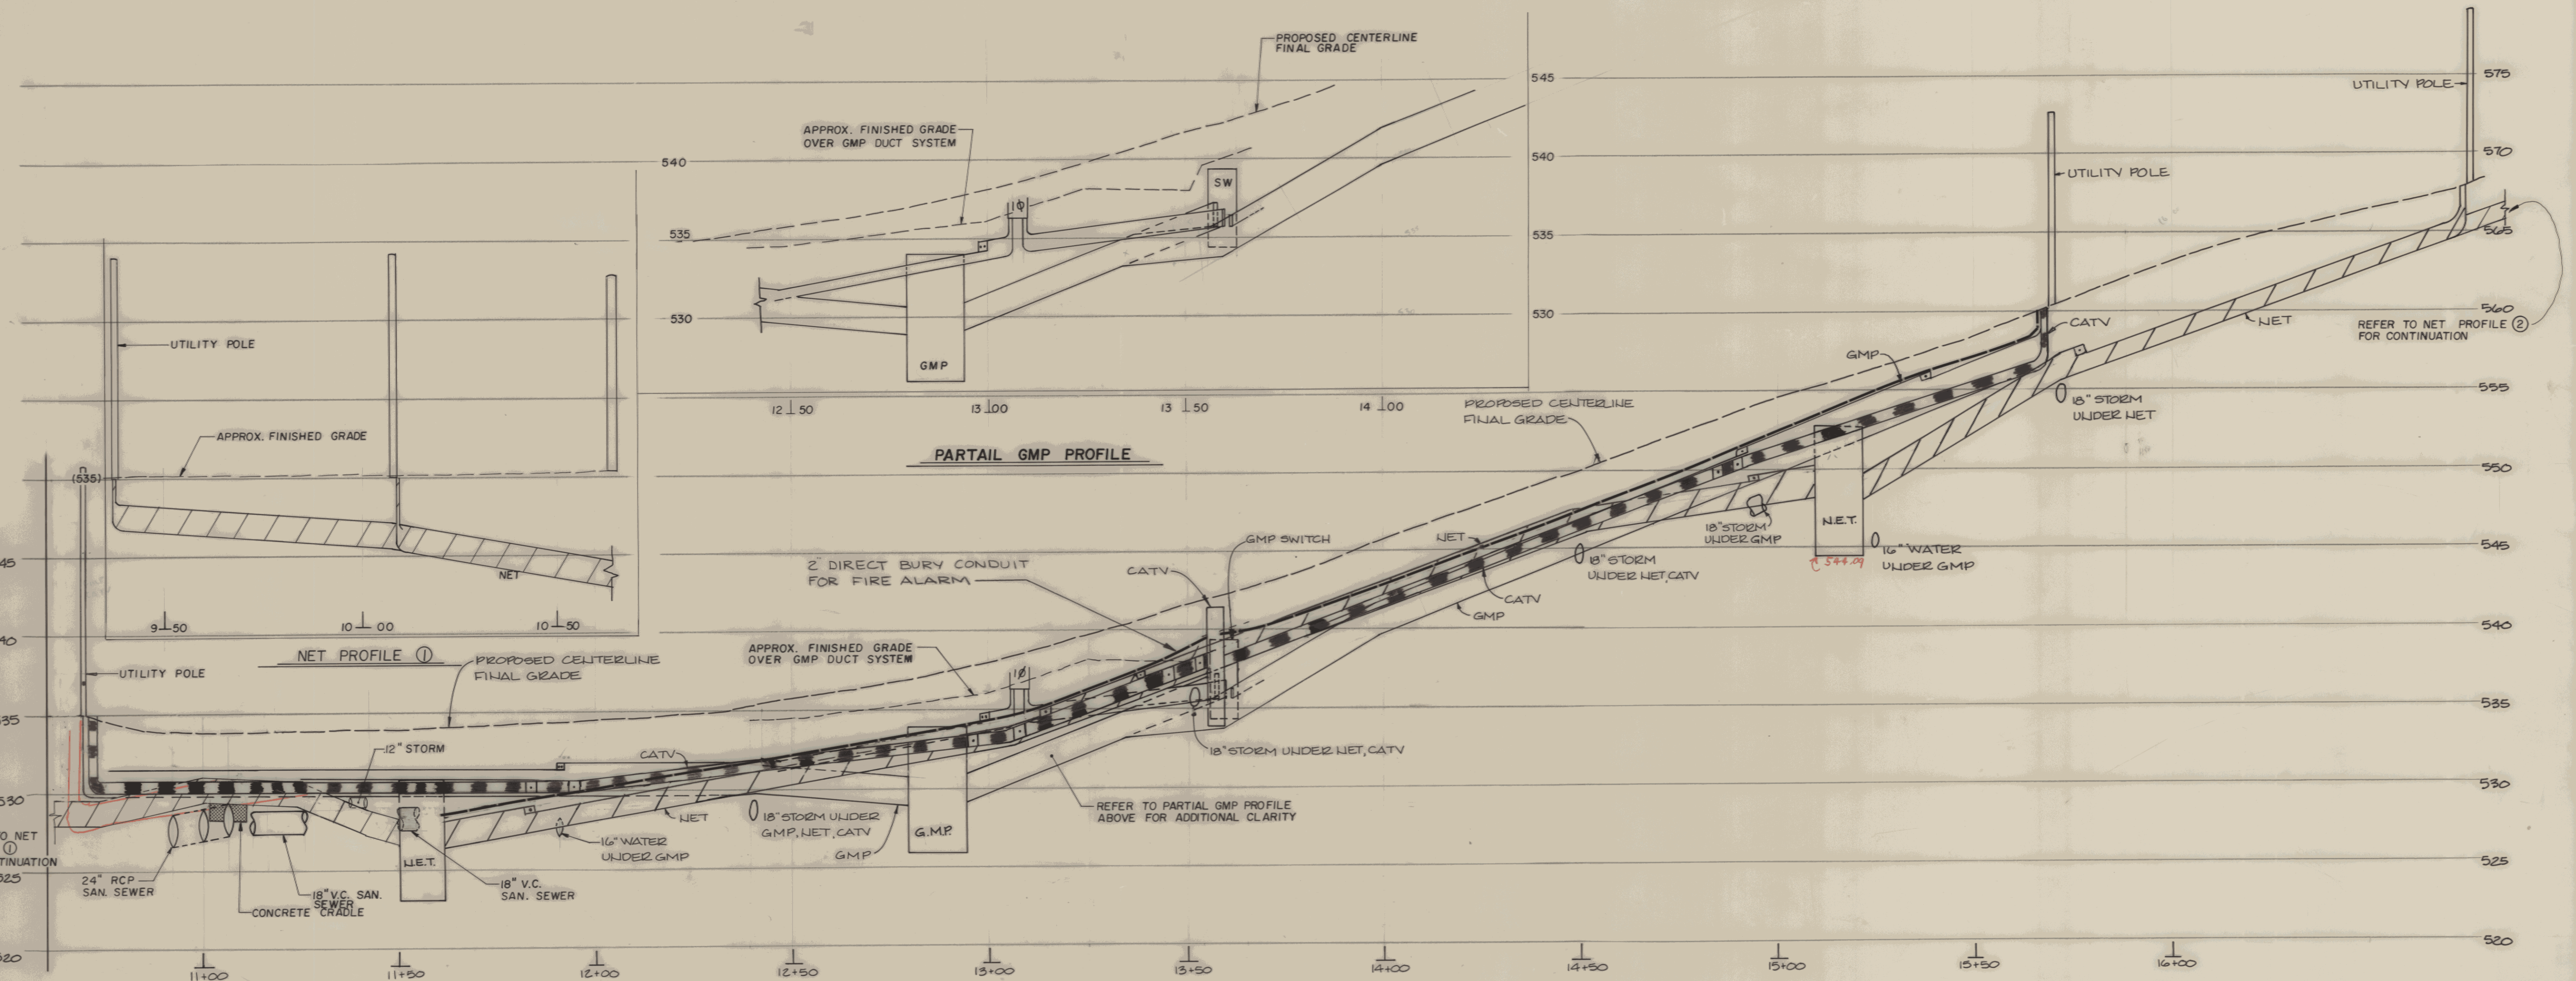

PARTIAL GMP PROFILE

UTILITIES PROFILE
SCALE: HORIZ. 1" = 20'
VERT. 1" = 5'

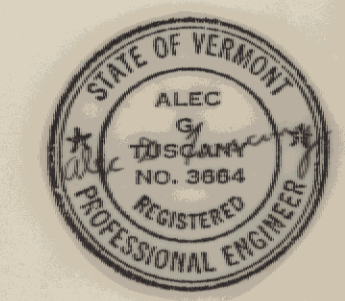

CITY OF MONTPELIER
BERLIN STREET RESTORATION PROJECT
UTILITIES PROFILE

MONTPELIER, VERMONT

Client No.	618040
Proj. Manager	A. TUSCALY
Proj. Designer	J. MYERS
Drawn By	J. SHATNEY
Checked By	L. LACKEY
Scale	AS SHOWN
Approved	
Date	27 NOV. 1990

DH
Dufresne-Henry Inc.
108 East State Street
Montpelier, VT 05602

Sheet 101B of 335
Sheet 2 of 7
D 618040-02

Rev.	Description	By	Date
1	REV. PROFILE (ADD PARTIAL)	JTM	4/28/92
2	RELOCATE UTILITY POLE	JTM	6/18/92
3	REVISE NET PROFILE	JTM	6/18/92

BRUNING 453373