

CONSTRUCT RETAINING WALL WITH METAL HANDRAIL

LT
18+42 ~ 18+95
19+00 ~ 19+20

CONSTRUCT CONCRETE STAIRWAY WITH METAL HANDRAIL

LT
18+97.5 (5' WIDE)
19+81 (4' WIDE)
20+59 (4' WIDE)

CONSTRUCT SIDEWALK RAMP

LT RT
18+84 (TYPE 6) 18+84 (TYPE 6)

PORTLAND CEMENT CONCRETE SIDEWALK-5"

17+00 RT ~ 19+09 RT (5' WIDE)
18+75 LT ~ 19+37 LT (3.5' WIDE)
19+37 LT ~ 21+00 LT (5' WIDE)
19+82 LT (4' WIDE PVT. WALK)
20+59 LT (2' WIDE PVT. WALK)

TRANSPLANTING TREES

19+01 ~ 19+04 RT (LILACS) (EST. 5)
TREES TO BE PLANTED IN A LOCATION MUTUALLY AGREEABLE WITH THE PROPERTY OWNER AND RESIDENT ENGINEER.

EVERGREEN TREES

18+42 ~ 19+20 LT (3'~4' CEDAR HEDGE) (EST. 40)
TREES TO BE PLANTED IN A LOCATION MUTUALLY AGREEABLE WITH THE PROPERTY OWNER AND RESIDENT ENGINEER.

DECIDUOUS TREES

19+50 ~ 20+00 LT. (2-1 1/2" SUGAR MAPLES)
(SUGAR MAPLES TO BE PLANTED OUTSIDE OF R.O.W. IN A LOCATION MUTUALLY AGREEABLE WITH THE PROPERTY OWNER AND THE RESIDENT ENGINEER.

DURABLE CROSSWALK W/DIAGONAL LINES (8')

18+80~18+88, 17' LT TO 17' RT (33')

TEMPORARY CROSSWALK W/DIAGONAL LINES (8')

18+80-18+88, 17' LT TO 17' RT

4" YELLOW LINE

REMOVING SIGNS

4 -2 EACH

17+00-18+80, 3' RT (DBL)
18+88-19+15, 3' RT (DBL)
19+55-21+00, 3' RT (DBL)
5+28-5+52 C (DBL)


TEMPORARY 4" YELLOW LINE

17+00-18+80, 3' RT (DBL)
18+88-19+15, 3' RT (DBL)
19+55-21+00, 3' RT (DBL)

DURABLE 24" STOP BAR

5+26-5+28, C TO 19' LT (25')

DURABLE LETTER OR SYMBOL
17+95 LT (ARROW)

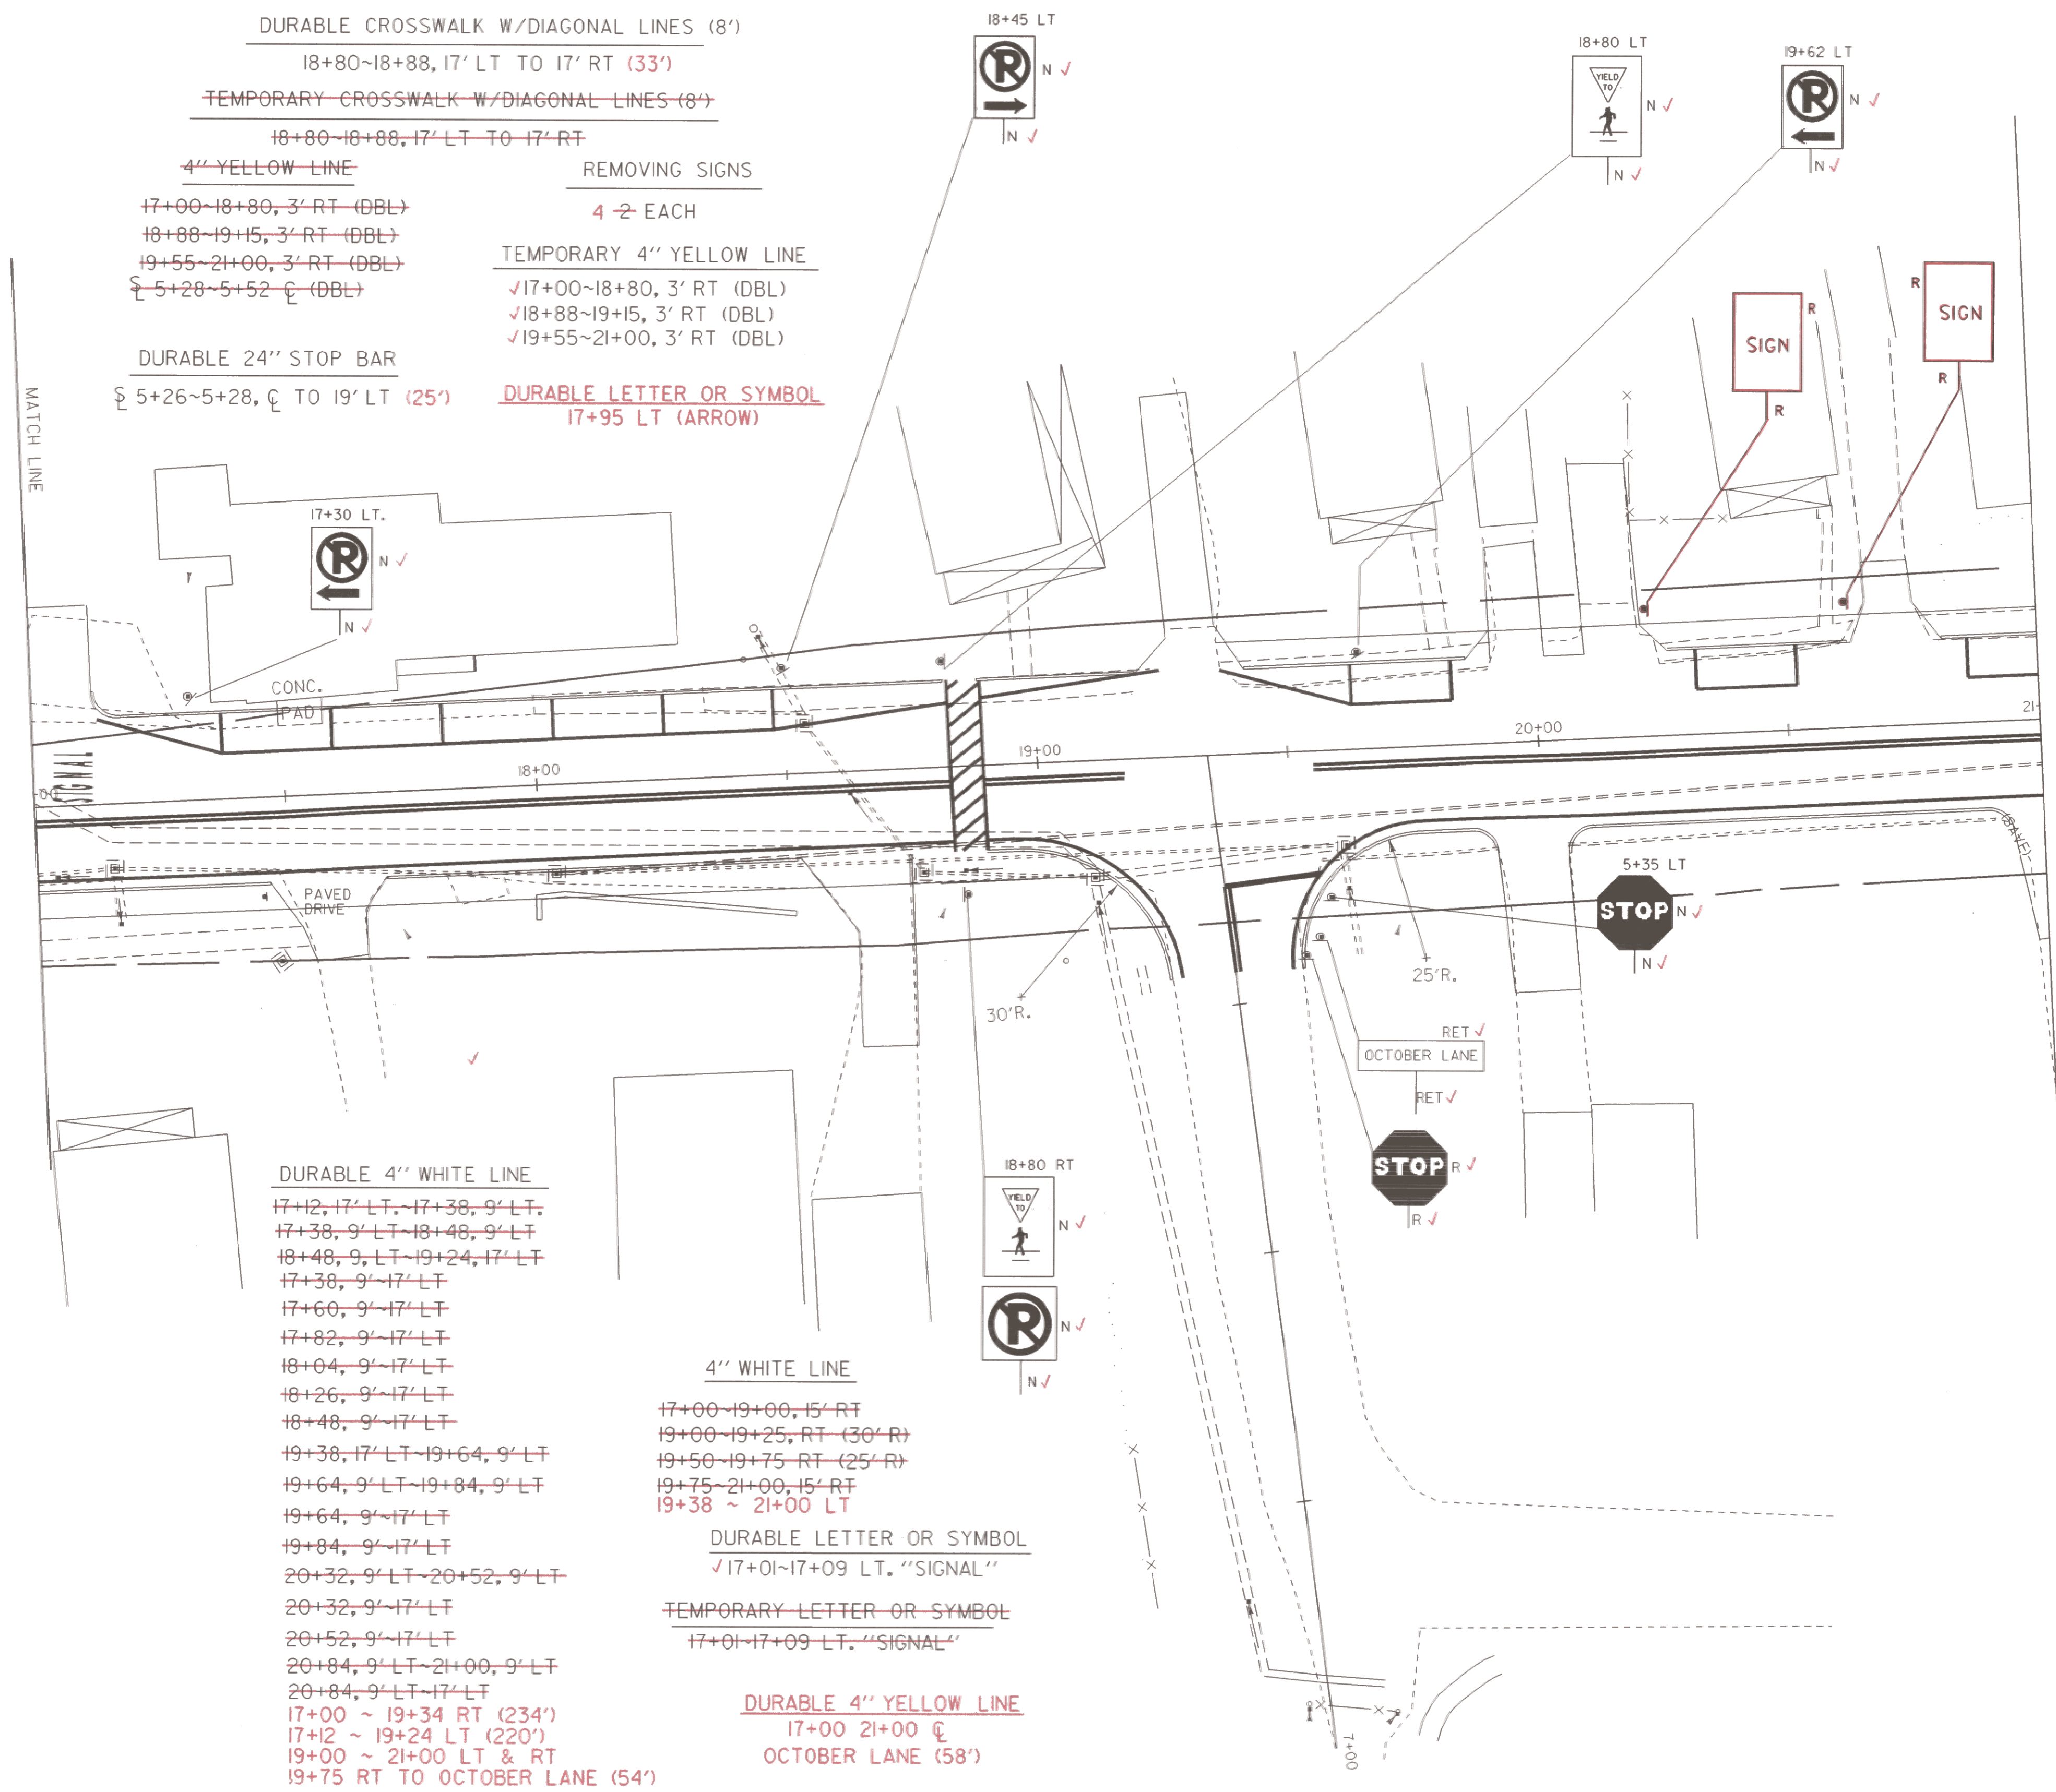

DURABLE 4" WHITE LINE

17+12, 17' LT ~ 17+38, 9' LT
17+38, 9' LT ~ 18+48, 9' LT
18+48, 9' LT ~ 19+24, 17' LT
17+38, 9' ~ 17' LT
17+60, 9' ~ 17' LT
17+82, 9' ~ 17' LT
18+04, 9' ~ 17' LT
18+26, 9' ~ 17' LT
18+48, 9' ~ 17' LT
19+38, 17' LT ~ 19+64, 9' LT
19+64, 9' LT ~ 19+84, 9' LT
19+64, 9' ~ 17' LT
19+84, 9' ~ 17' LT
20+32, 9' LT ~ 20+52, 9' LT
20+32, 9' ~ 17' LT
20+52, 9' ~ 17' LT
20+84, 9' LT ~ 21+00, 9' LT
20+84, 9' LT ~ 17' LT
17+00 ~ 19+34 RT (234')
17+12 ~ 19+24 LT (220')
19+00 ~ 21+00 LT & RT
19+75 RT TO OCTOBER LANE (54')

4" WHITE LINE

17+00-19+00, 15' RT
19+00-19+25, RT (30' R)
19+50-19+75 RT (25' R)
19+75-21+00, 15' RT
19+38 ~ 21+00 LT

DURABLE LETTER OR SYMBOL
17+01-17+09 LT. "SIGNAL"

TEMPORARY LETTER OR SYMBOL
17+01-17+09 LT. "SIGNAL"

DURABLE 4" YELLOW LINE
17+00 21+00 C
OCTOBER LANE (58')

TEMPORARY 4" YELLOW LINE
19+00 21+00 C

**ARCHIVED
ON CADD**

DATUM
VERTICAL NGVD 1929
HORIZONTAL N/A

SURVEYED BY MOREAU DATE 7-85
DRAWN BY COTA/NAILOS DATE 4-88
SQUAD LEADER SHERIDAN
DESIGN FILE NO. ZGO-[50, 116]PETED.DGN; 1
IPARM FILE PETEDS2.PRF DATE PLOTTED 16-FEB-1996
PROJ. NAME MONTPELIER
PROJ. NO. MEGC M 6400(7)
SHEET 114 OF 355 SHEETS