

DURABLE LETTER OR SYMBOL
 22+35 (I)
 26+62 (I)

TEMPORARY STOP BAR
 PHELPS ST. (15')

TEMPORARY 4" YELLOW LINE
 21+00~25+64, 3' RT (DBL)
 26+04~27+00, 3' RT (DBL)
 21+00 ~ 27+00 C

4" YELLOW LINE
 21+00~25+64, 3' RT (DBL)
 26+04~27+00, 3' RT (DBL)
 10+33~10+55 C (DBL)

DURABLE 24" STOP BAR
 10+31~10+33 C TO 19' LT









REMOVING SIGNS
 2+ EACH

REMOVING SIGNS (MOD)
 1 EACH

4" WHITE LINE
 21+00~27+00, 15' RT
 21+00~24+35 LT
 PHELPS ST. PARKING

DURABLE CROSSWALK W/DIAGONAL LINES (6')
 25+42~26+03, 17' RT TO 23' LT (6')

TEMPORARY CROSSWALK W/DIAGONAL LINES
 PHELPS ST. (44')

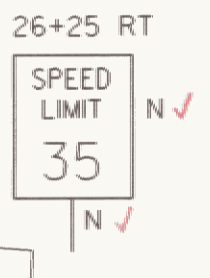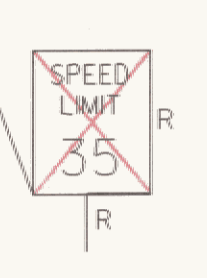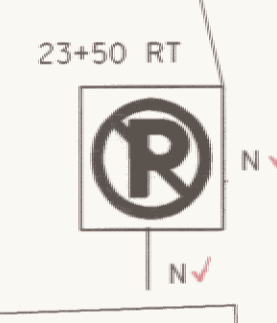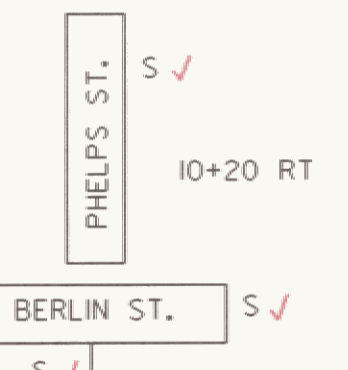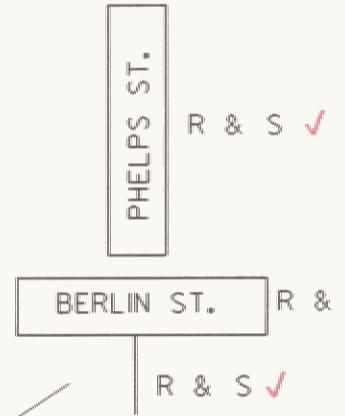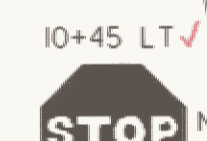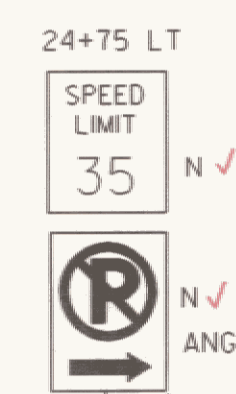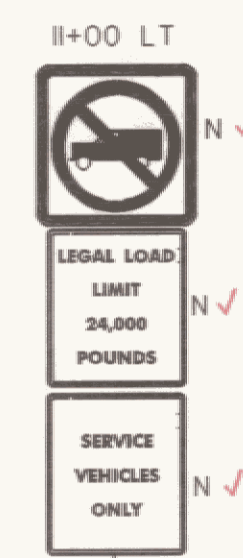

DURABLE 4" WHITE LINE
 21+00, 9' LT~21+04, 9' LT
 21+04, 9' LT~17' LT
 21+40, 9' LT~21+62, 9' LT
 21+40, 9' LT~17' LT
 21+62, 9' LT~17' LT
 22+02, 9' LT~22+86, 9' LT
 22+02, 9' LT~17' LT
 22+22, 9' LT~17' LT
 22+44, 9' LT~17' LT
 22+66, 9' LT~17' LT
 22+86, 9' LT~17' LT
 23+23, 9' LT~23+43, 9' LT
 23+23, 9' LT~17' LT
 23+43, 9' LT~17' LT
 21+00 ~ 27+00 LT & RT

DURABLE 4" YELLOW LINE
 21+00 ~ 27+00 C
 PHELPS STREET (40')

DR. PAMELA MILOSEVICH CHIROPRACTOR
 DR. PAMELA MILOSEVICH CHIROPRACTOR
 ✓ TO BE REMOVED & RESET PER R. O. W. AGREEMENT

DATUM
 VERTICAL NGVD 1929
 HORIZONTAL N/A

SURVEYED BY MOREAU DATE 7-85
 DRAWN BY COTA/NAIOLR DATE 4-88
 SQUAD LEADER SHERIDAN
 DESIGN FILE NO. ZGO: [50, 116] PETED, DGN; 1
 IPARM FILE PETEDs3, PRF DATE PLOTTED 16-FEB-1996
 PROJ. NAME MONTPELIER
 PROJ. NO. MEGC M 6400(7)
 SHEET 115 OF 355 SHEETS