

DURABLE 4" YELLOW LINE
27+00 ~ 33+00 ☒
WILSON ST. (134')

DURABLE 24" STOP BAR
☒ 15+34-15+36 ☒ TO 18' LT

TEMPORARY 4" YELLOW LINE
27+00~29+90, 3' RT (DBL)
30+30~33+00, 3' RT (DBL)
27+00 ~ 33+00 ☒

4" YELLOW LINE
27+00~29+90, 3' RT (DBL)
30+30~33+00, 3' RT (DBL)
☒ 15+36~15+41 ☒ (DBL)


4" WHITE LINE
27+00~29+70, 15' RT
29+70~29+94 RT (25' R)
30+10~30+50 RT (25' R)
30+50~33+00, 15' RT
WILSON ST. RADIUS (183')
WILSON ST. PARKING

REMOVING SIGNS
✓ IEA

REMOVING SIGNS (MOD.)
✓ IEA

TEMPORARY 24" STOP BAR
WILSON ST (15')

DURABLE LETTER OR SYMBOL
31+14 (I)

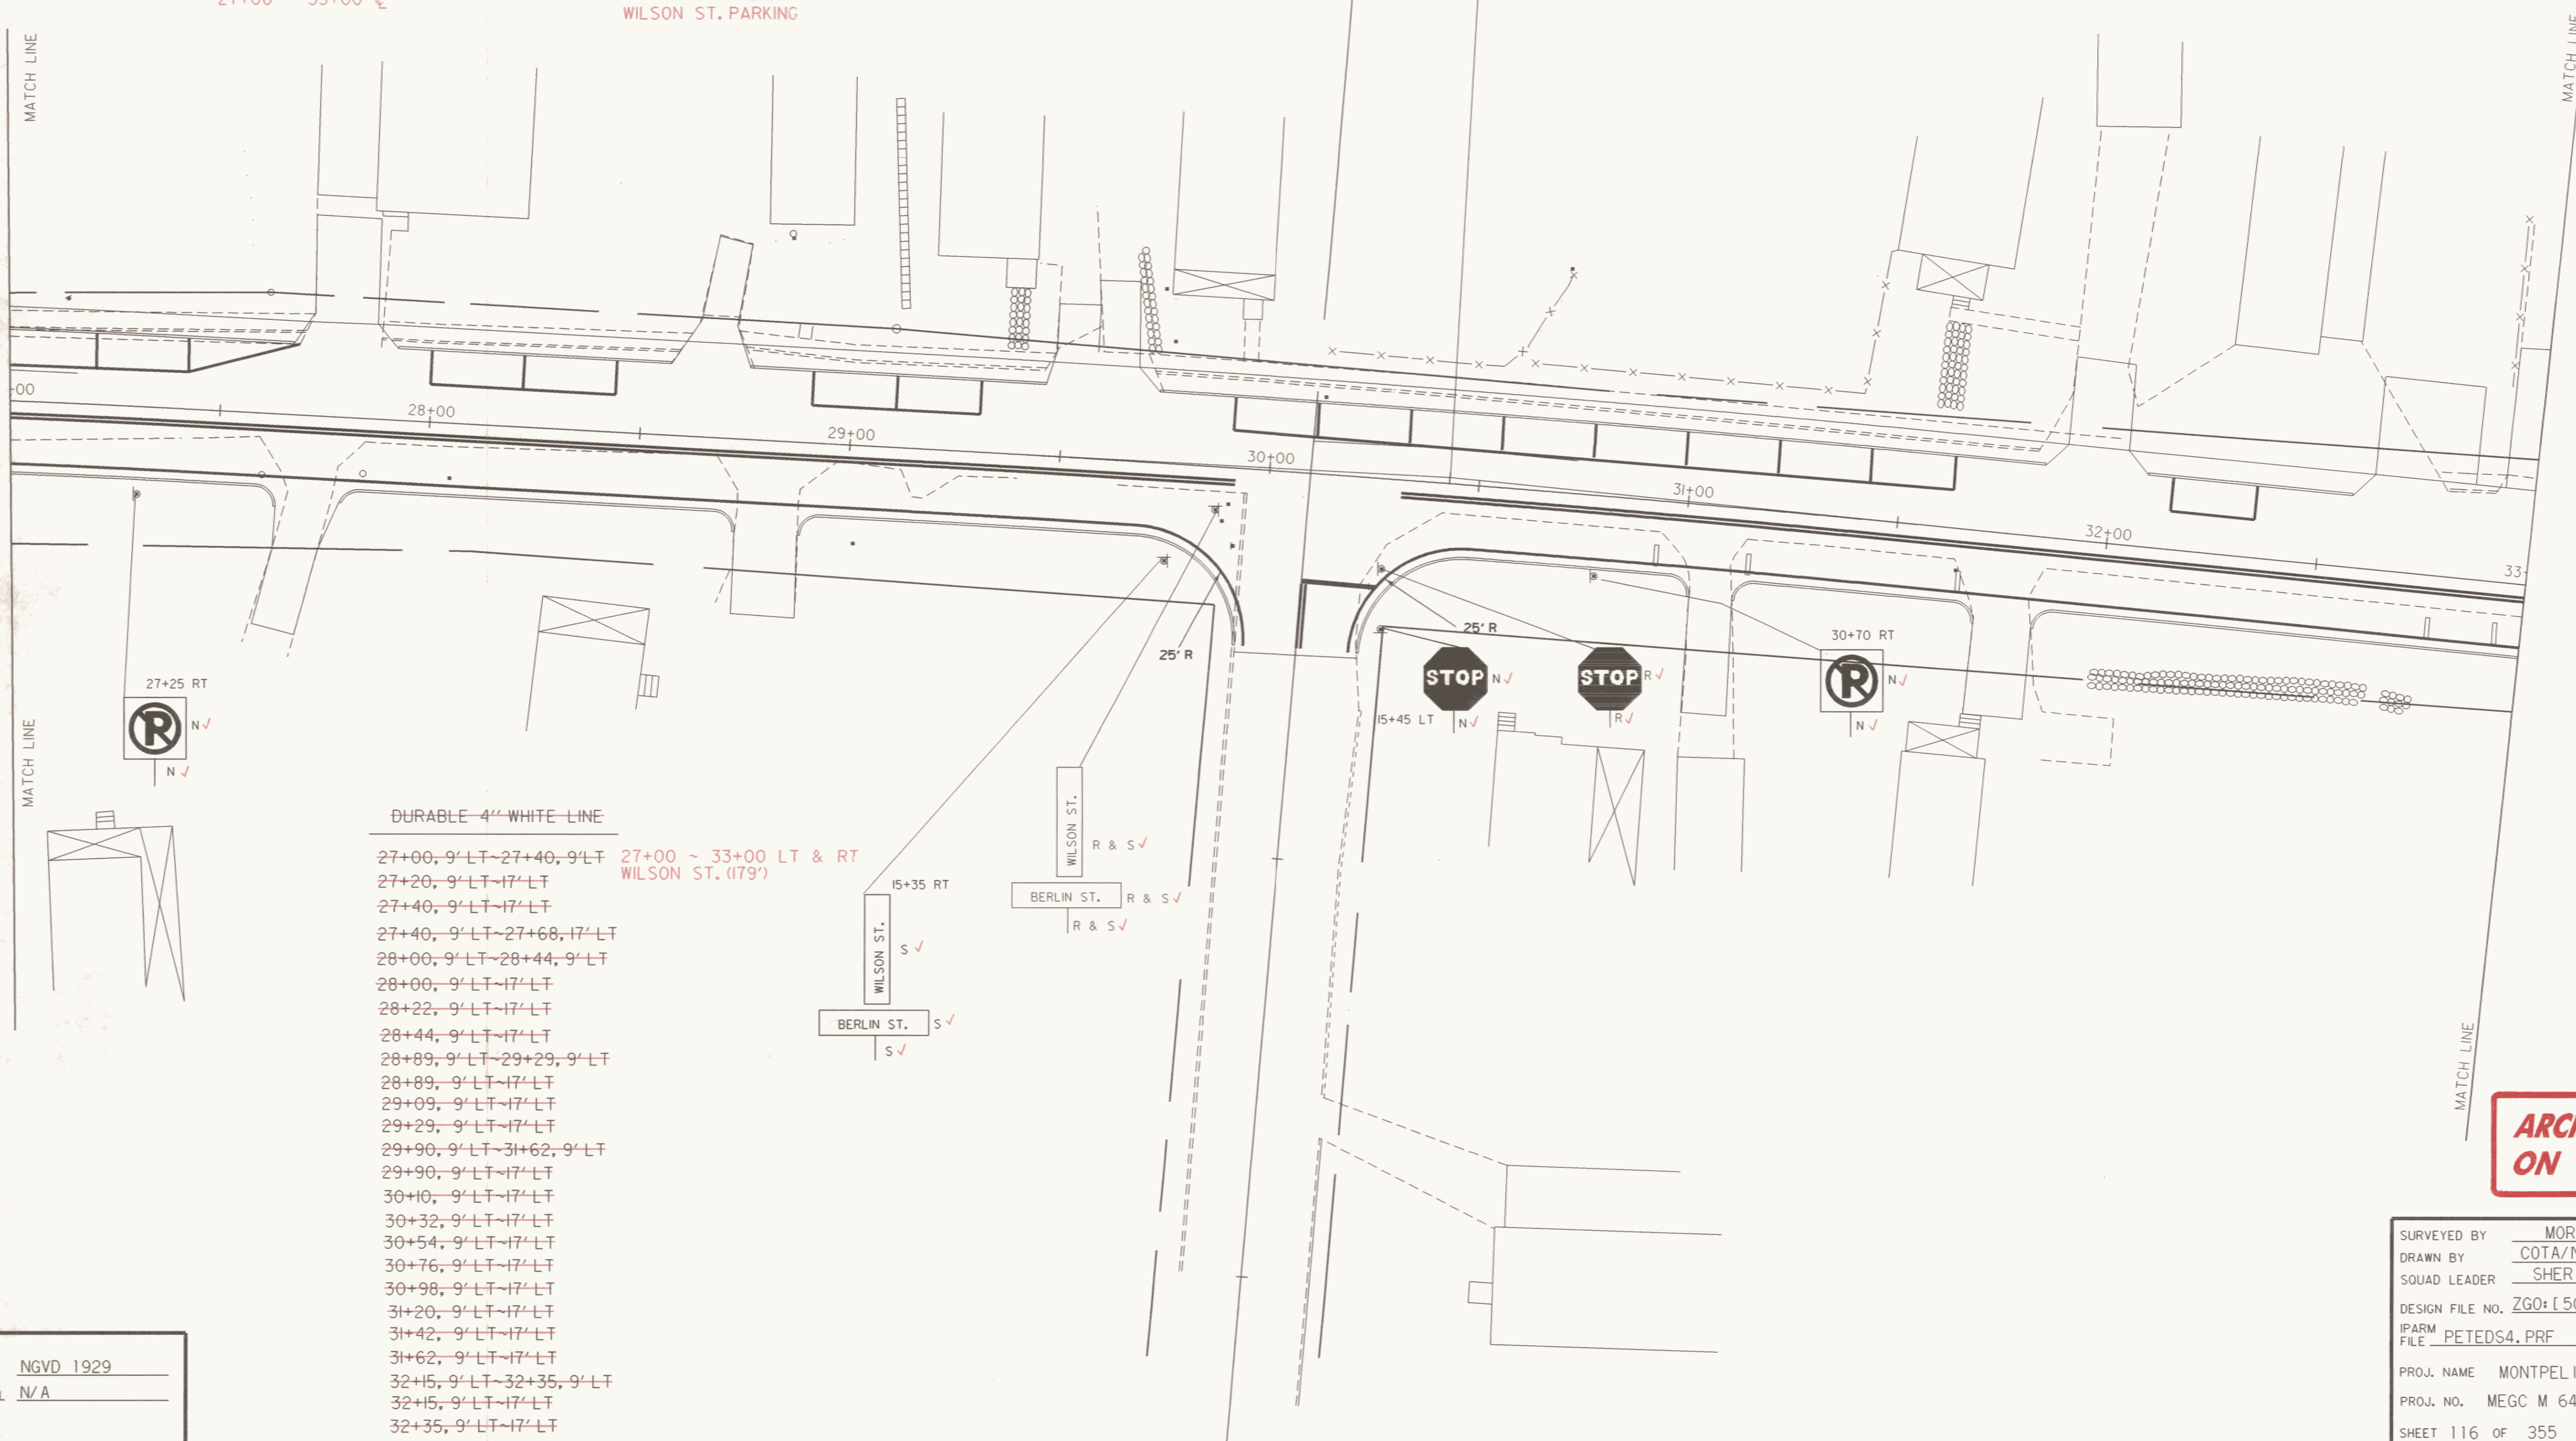

DURABLE 4" WHITE LINE

27+00, 9' LT-27+40, 9' LT
27+20, 9' LT-17' LT
27+40, 9' LT-17' LT
27+40, 9' LT-27+68, 17' LT
28+00, 9' LT-28+44, 9' LT
28+00, 9' LT-17' LT
28+22, 9' LT-17' LT
28+44, 9' LT-17' LT
28+89, 9' LT-29+29, 9' LT
28+89, 9' LT-17' LT
29+09, 9' LT-17' LT
29+29, 9' LT-17' LT
29+90, 9' LT-31+62, 9' LT
29+90, 9' LT-17' LT
30+10, 9' LT-17' LT
30+32, 9' LT-17' LT
30+54, 9' LT-17' LT
30+76, 9' LT-17' LT
30+98, 9' LT-17' LT
31+20, 9' LT-17' LT
31+42, 9' LT-17' LT
31+62, 9' LT-17' LT
32+15, 9' LT-32+35, 9' LT
32+15, 9' LT-17' LT
32+35, 9' LT-17' LT

27+00 ~ 33+00 LT & RT
WILSON ST. (179')

DATUM
VERTICAL NGVD 1929
HORIZONTAL N/A

**ARCHIVED
ON CADD**

SURVEYED BY MOREAU DATE 7-85
DRAWN BY COTA/NAILOS DATE 4-88
SQUAD LEADER SHERIDAN
DESIGN FILE NO. ZG0-[50,116]PETED.DGN; 1
IPARM FILE PETEDS4.PRF DATE PLOTTED 16-FEB-1996
PROJ. NAME MONTPELIER
PROJ. NO. MEGC M 6400(7)
SHEET 116 OF 355 SHEETS