

MATCH LINE

~~4" YELLOW LINE~~
~~56+50-62+00 CL (DBL.)~~


REMOVING SIGNS
1-3 EA.

DURABLE 4" WHITE LINE
56+50 ~ 62+00 LT & RT

~~4" WHITE LINE~~
~~56+50-62+00, 11' LT.~~
~~56+50-62+00, 11' RT.~~

DURABLE 4" YELLOW LINE
56+50 ~ 62+00 CL

~~TEMPORARY 4" YELLOW LINE~~
~~56+50-62+00 CL (DBL.)~~

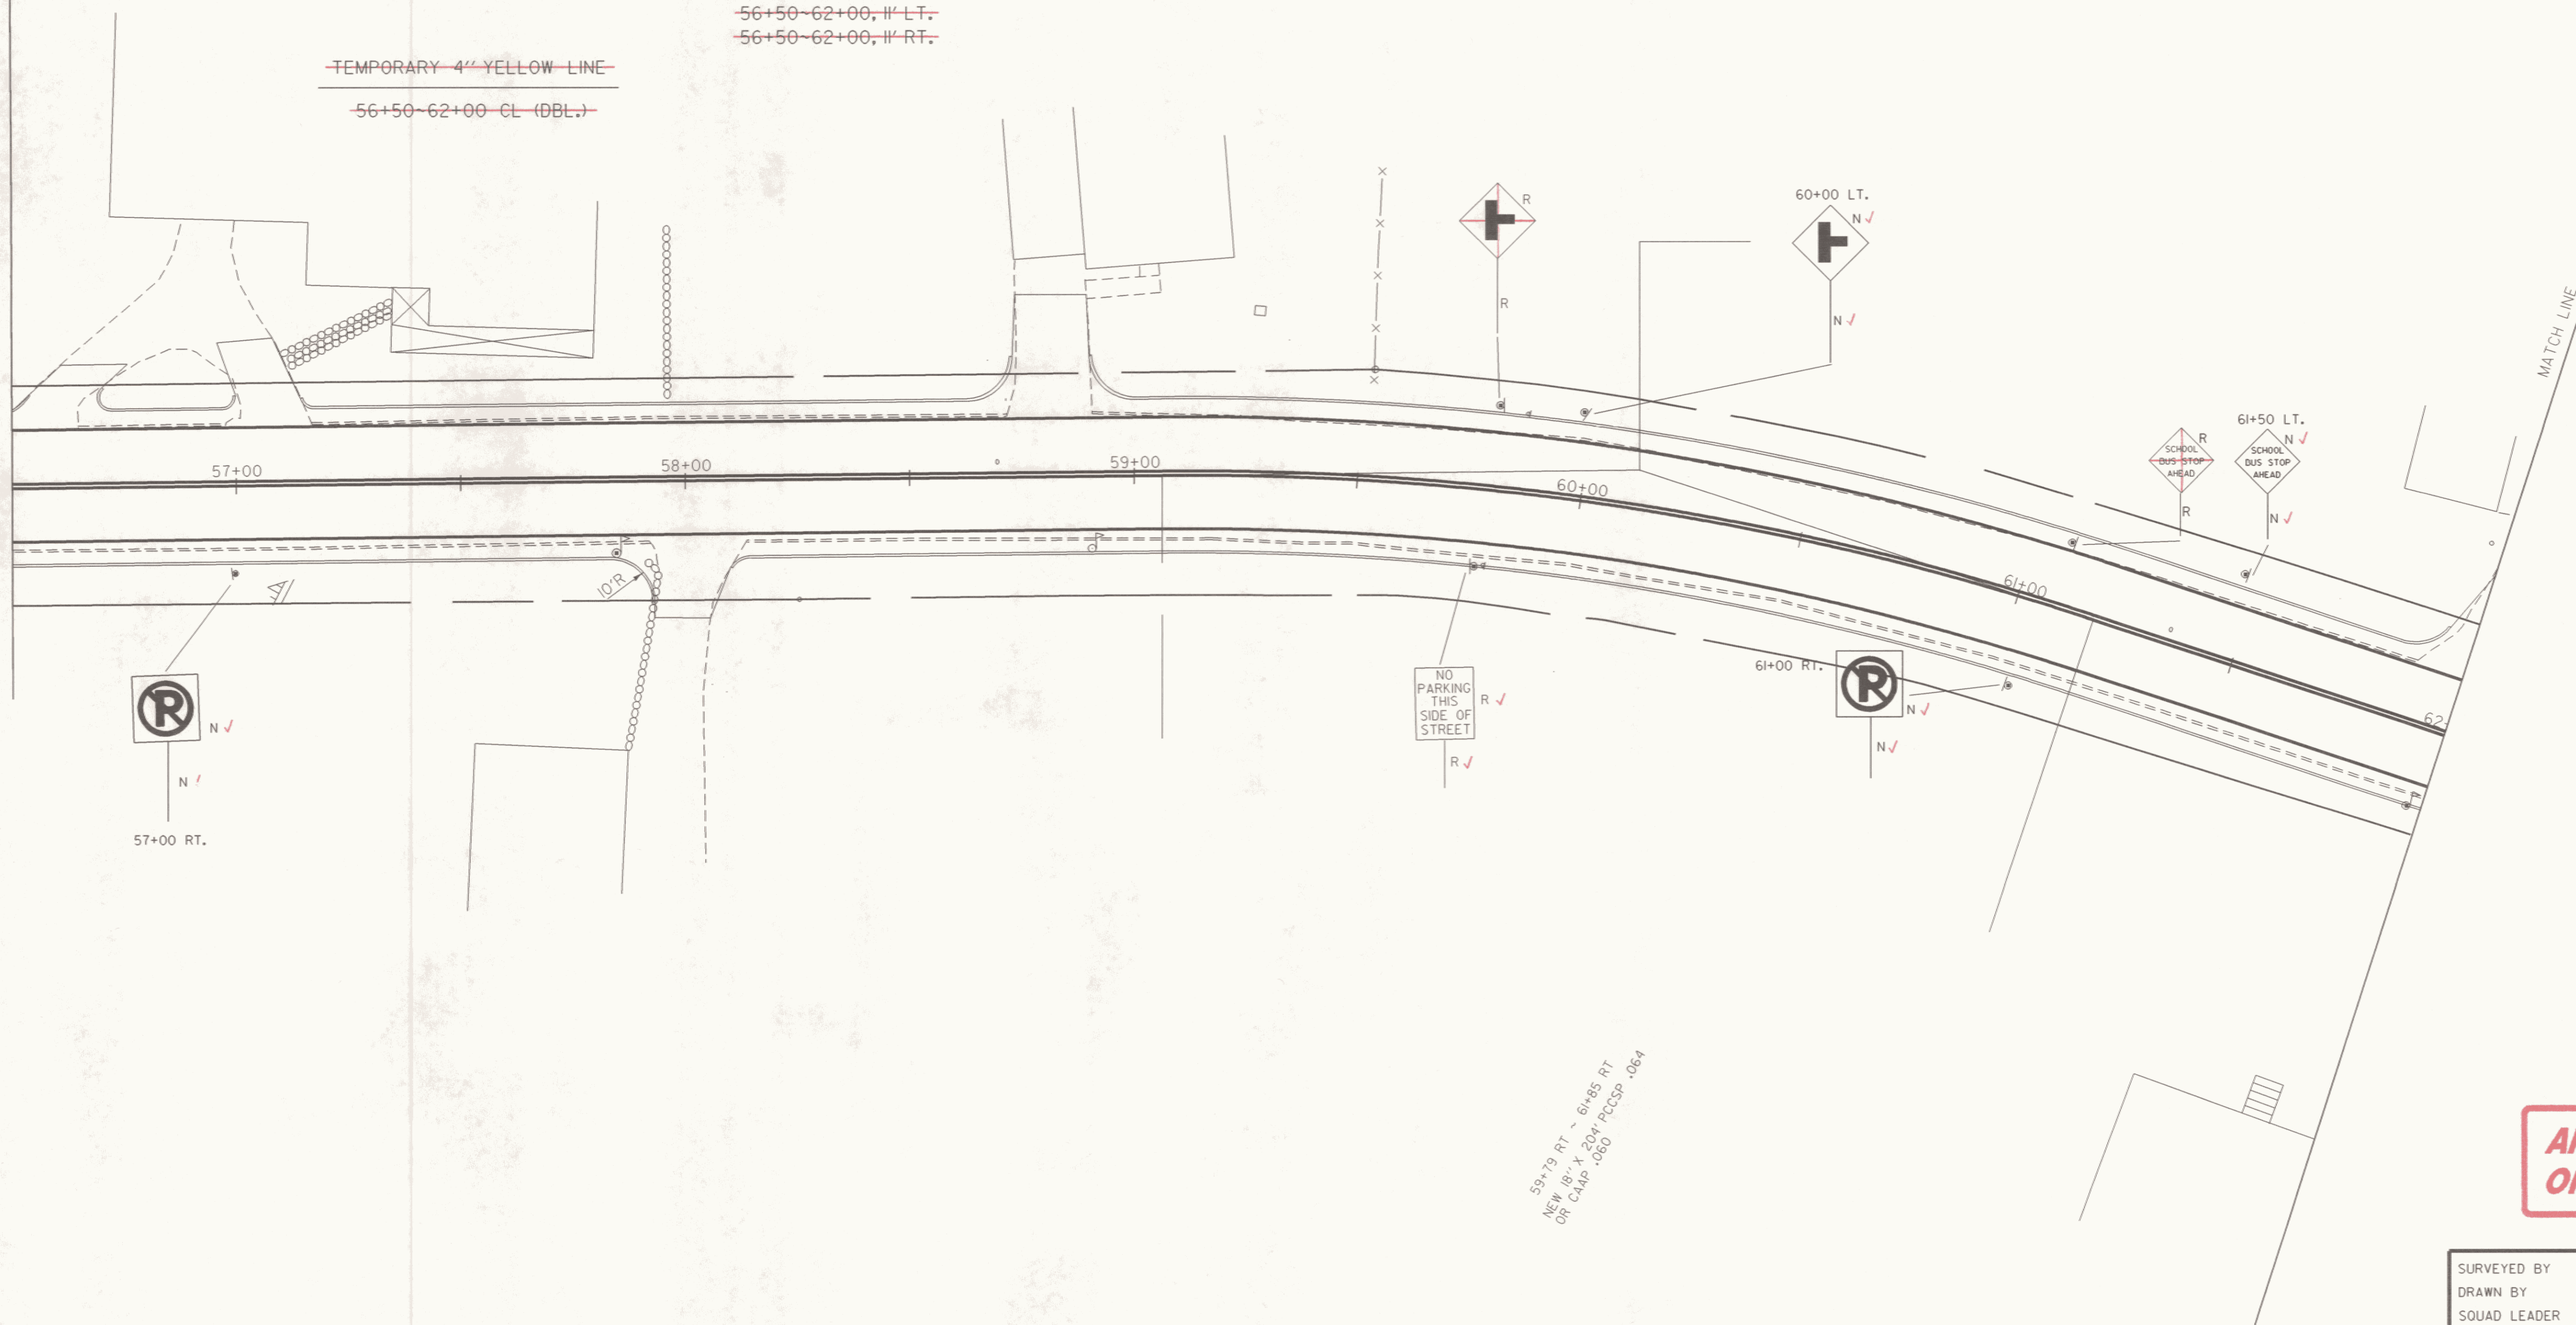

**ARCHIVED
ON CADD**

59+7.9 RT ~ 61+85 RT
NEW 18" X 20" PCCSP
OR CCAAP .0650 1064

DATUM	
VERTICAL	NGVD 1929
HORIZONTAL	N/A

SURVEYED BY	MOREAU	DATE	7-85
DRAWN BY	COTA/NAILOR	DATE	4-88
SQUAD LEADER	SHERIDAN		
DESIGN FILE NO.	ZGO: [50, 116] PETED. DGN: 1		
IPARM FILE	PETEDS9.PRF	DATE PLOTTED	20-FEB-1996
PROJ. NAME	MONTPELIER		
PROJ. NO.	MEGC M 6400(7)		
SHEET	121 OF 355	SHEETS	