
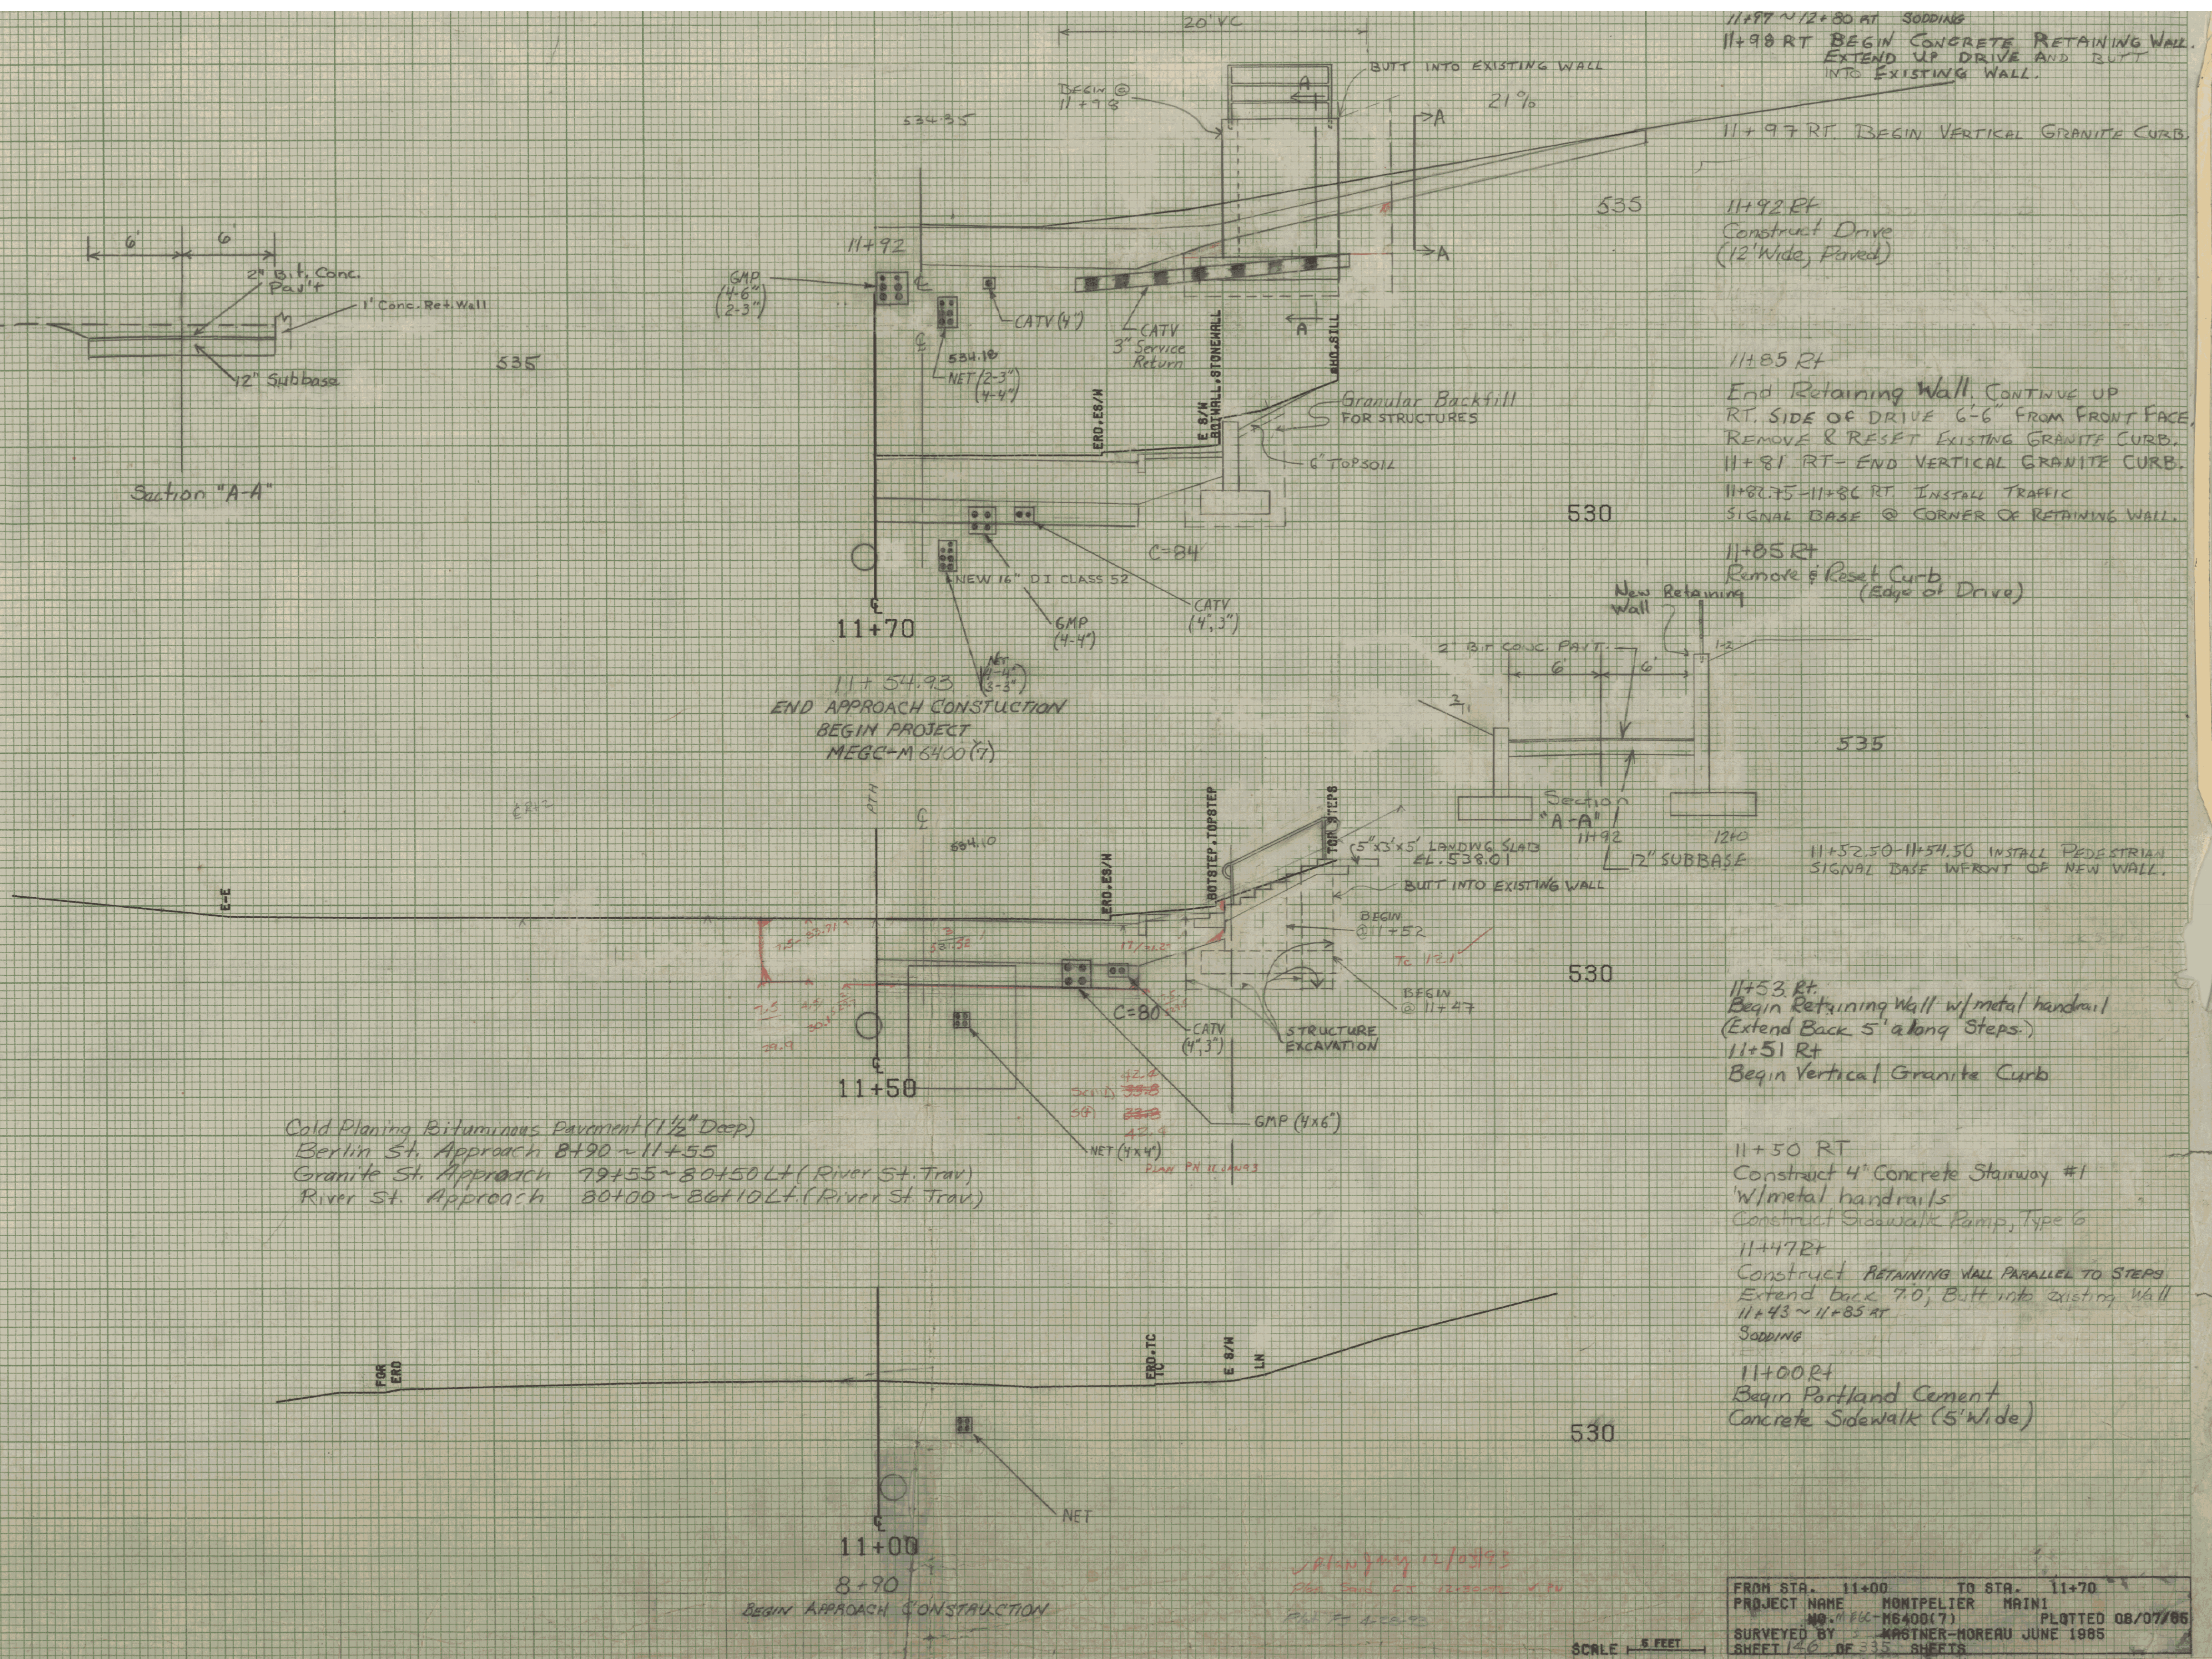


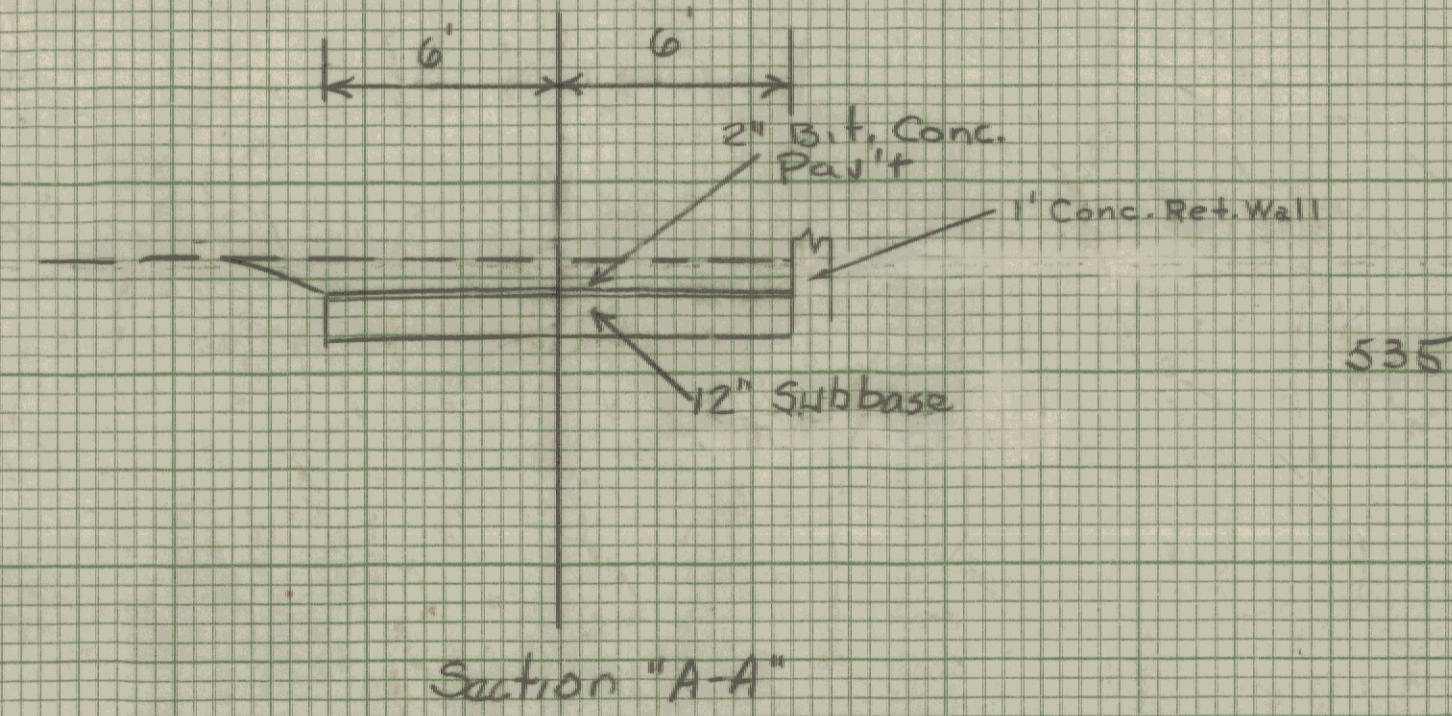

Cold Planing Bituminous Pavement (1 1/2" Deep)
 Berlin St. Approach 8+90 ~ 11+55
 Granite St. Approach 79+55 ~ 80+50 Lt. (River St. Trav)
 River St. Approach 80+00 ~ 86+10 Lt. (River St. Trav)

11+98 RT BEGIN CONCRETE RETAINING WALL. EXTEND UP DRIVE AND BUTT INTO EXISTING WALL.
 11+97 RT BEGIN VERTICAL GRANITE CURB.
 11+92 RT Construct Drive (12' Wide, Paved)
 11+85 RT End Retaining Wall. CONTINUE UP RT. SIDE OF DRIVE 6'-6" FROM FRONT FACE. REMOVE & RESET EXISTING GRANITE CURB.
 11+81 RT - END VERTICAL GRANITE CURB.
 11+80.75 ~ 11+80 RT. INSTALL TRAFFIC SIGNAL BASE @ CORNER OF RETAINING WALL.
 11+85 RT Remove & Reset Curb (Edge of Drive)
 11+52.50 ~ 11+54.50 INSTALL PEDESTRIAN SIGNAL BASE W/FRONT OF NEW WALL.
 11+53 RT Begin Retaining Wall w/metal handrail (Extend Back 5' along Steps)
 11+51 RT Begin Vertical Granite Curb
 11+50 RT Construct 4" Concrete Stairway #1 w/metal handrails
 Construct Sidewalk Ramp, Type 6
 11+47 RT Construct RETAINING WALL PARALLEL TO STEPS. Extend back 7.0'; Butt into existing Wall 11+43 ~ 11+85 RT
 Sodding
 11+00 RT Begin Portland Cement Concrete Sidewalk (5' wide)

FROM STA.	11+00	TO STA.	11+70
PROJECT NAME	MONTPELIER MAIN		
NO.	M-6400(7)		
SURVEYED BY	KAGNER-MOREAU JUNE 1985		
SHEET	140	OF	335 SHEETS

SCALE 5 FEET