


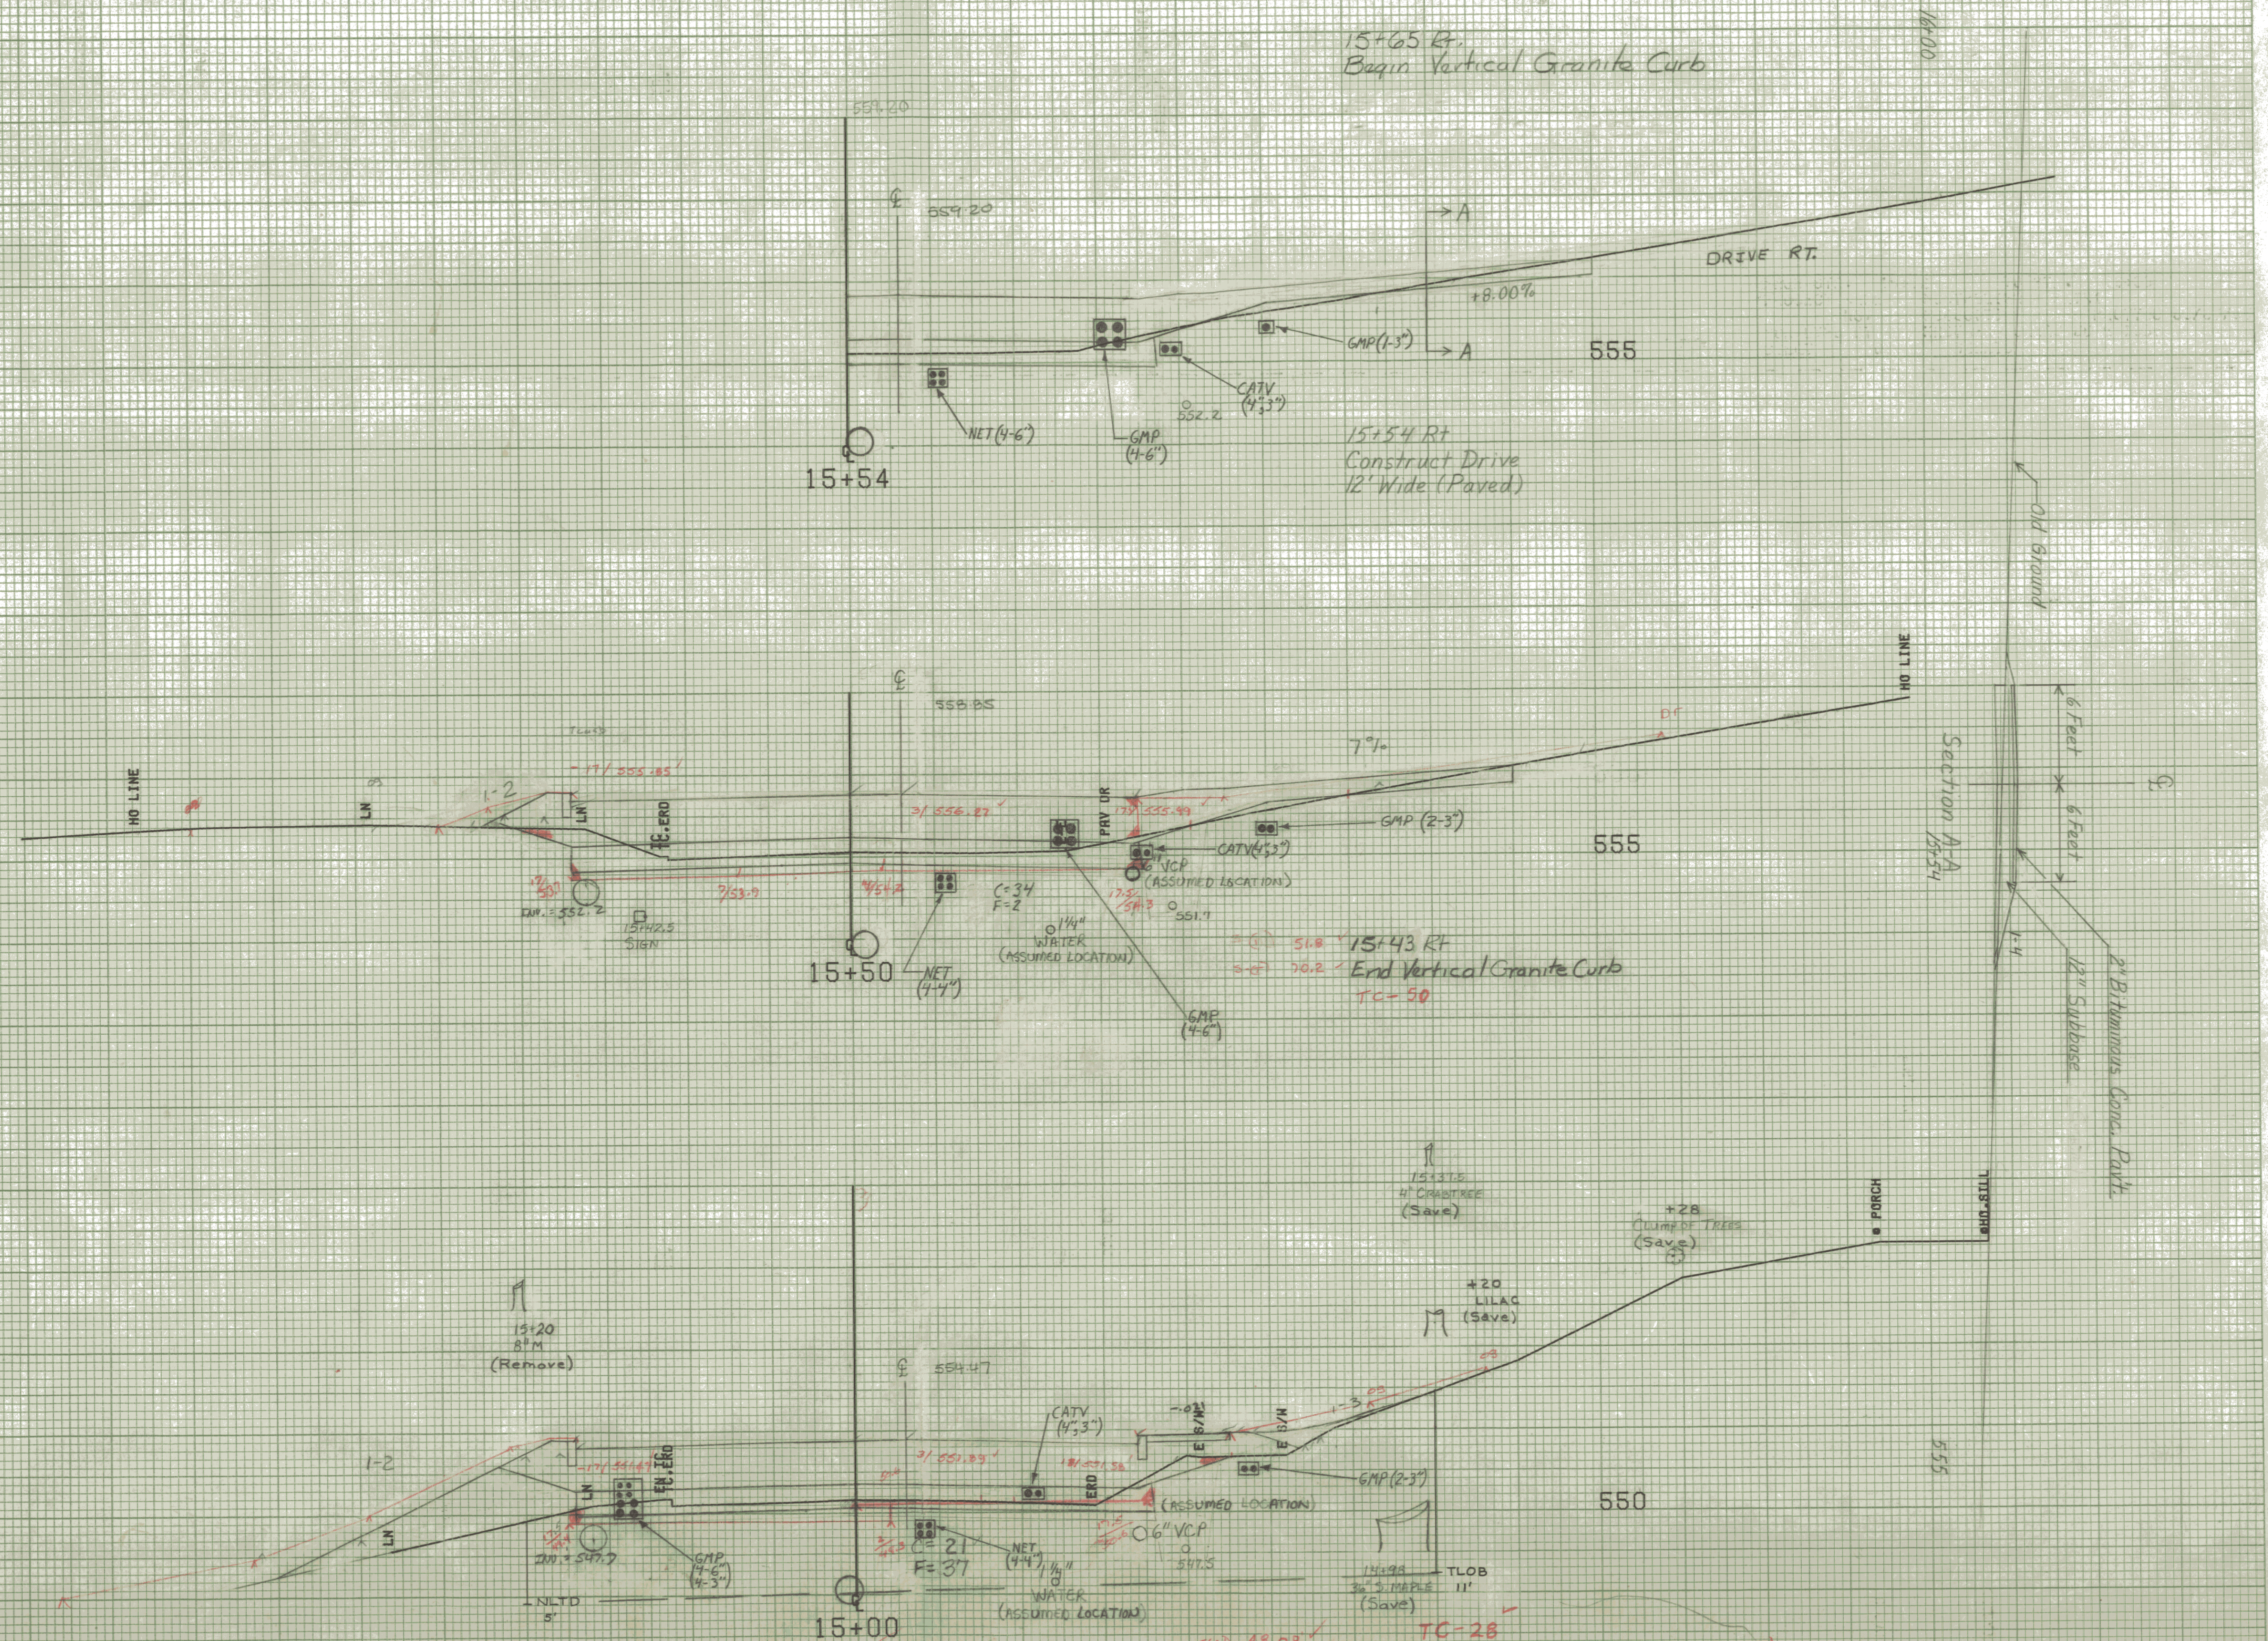

FROM STA. 15+00 TO STA. 15+54
 PROJECT NAME MONTPELIER MAIN1
 NO. M-16- M6400(7) PLOTTED 08/07/85
 SURVEYED BY KASTNER-MOREAU JUNE 1985
 SHEET 154 OF 335 SHEETS

SCALE 8 FEET
 PLAN 9 MAY 12 1985