


#60
ROSE BUSH
(save)

575

18+56RT
End Vertical Granite Curb

18+42~19+20 Lt. Evergreen Trees
3' to 4' High Cedar Hedge
(Est. 1 Tree Every 2')


Hedge to be located outside the R.O.W. Limits in a location which is mutually agreeable with the property owner and the resident engineer.

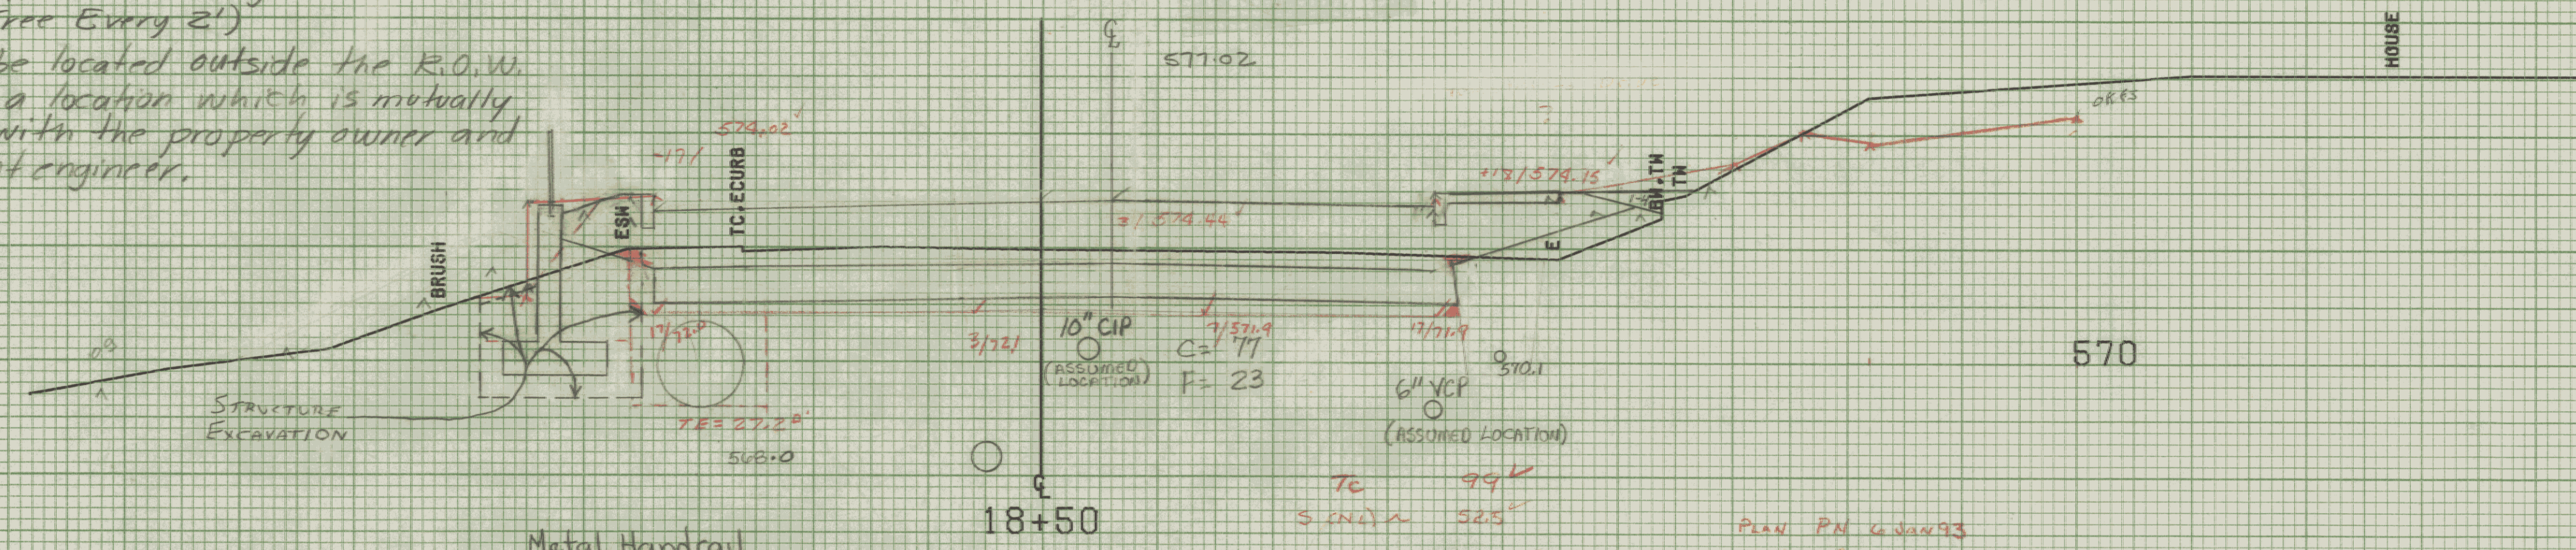

570

18+44 Lt ~ 18+54 Lt
Remove Existing 12" CMP
And RCDI @ 18+54 Lt

Metal Handrail
See Std. J-2 for Anchorage
Details

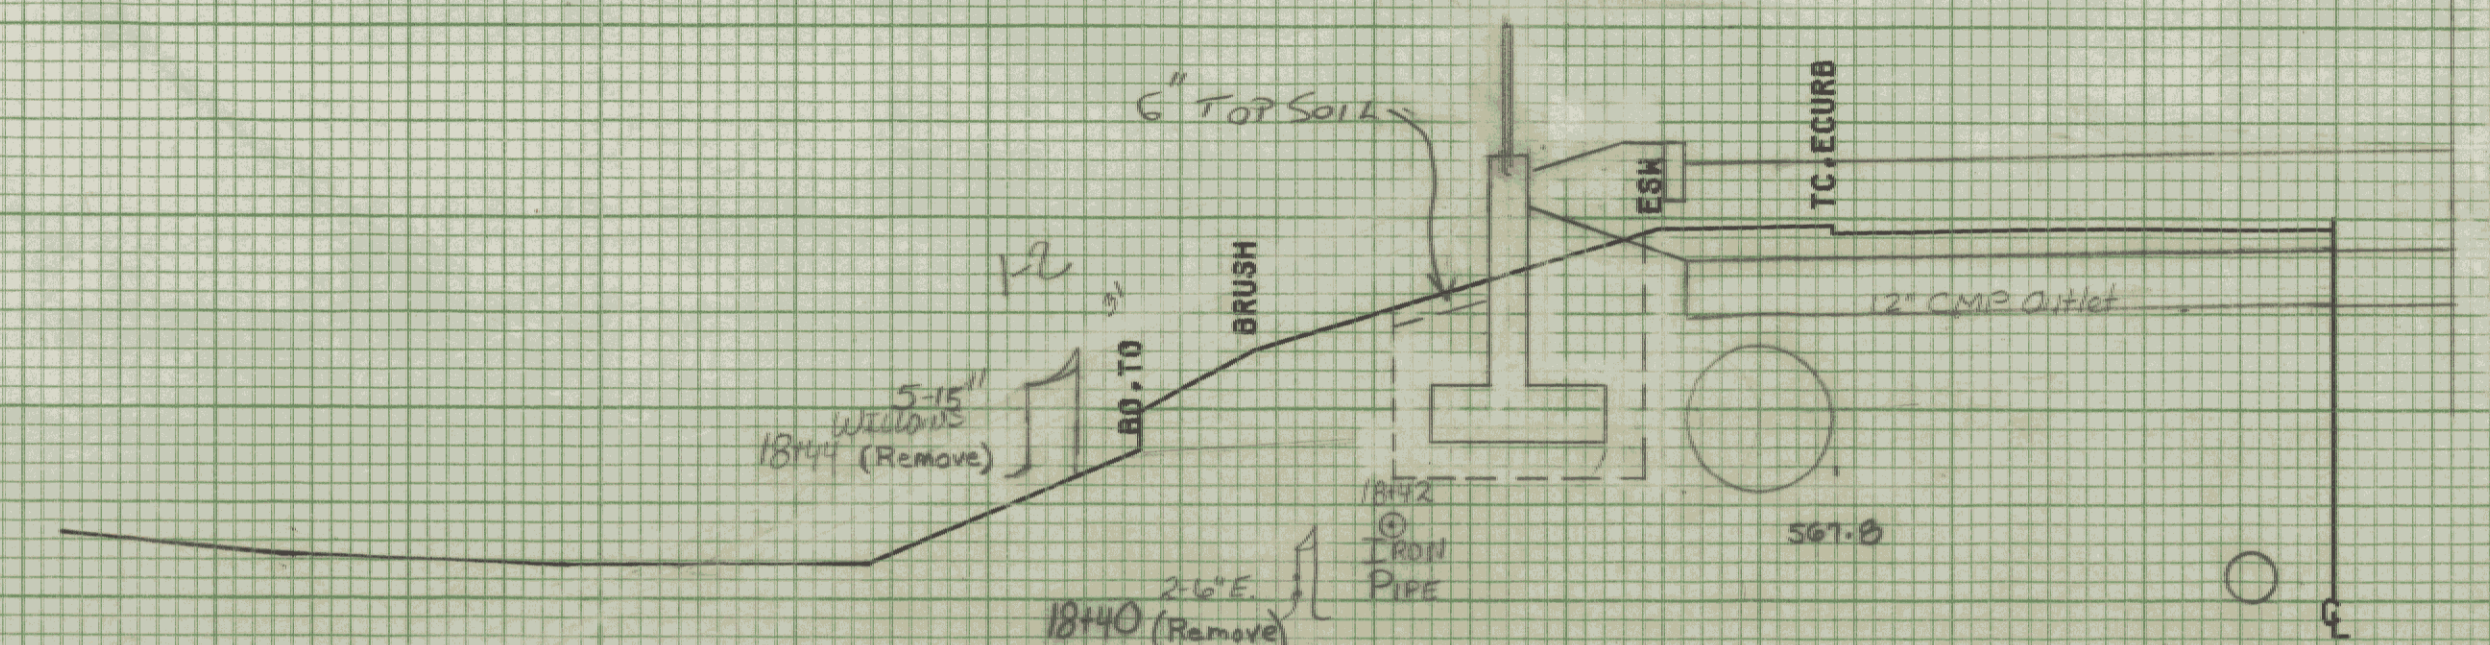

570

18+42 Lt. BEGIN CONCRETE RETAINING WALL w/ METAL HANDRAIL.
18+41 Lt. BEGIN STRUCTURAL EXCAVATION.
BEGIN GRANULAR BACKFILL FOR STRUCTURES.
BEGIN TOP SOIL.