



19+60 RT ~ 21+09 RT
REMOVE EXISTING 18" CMP

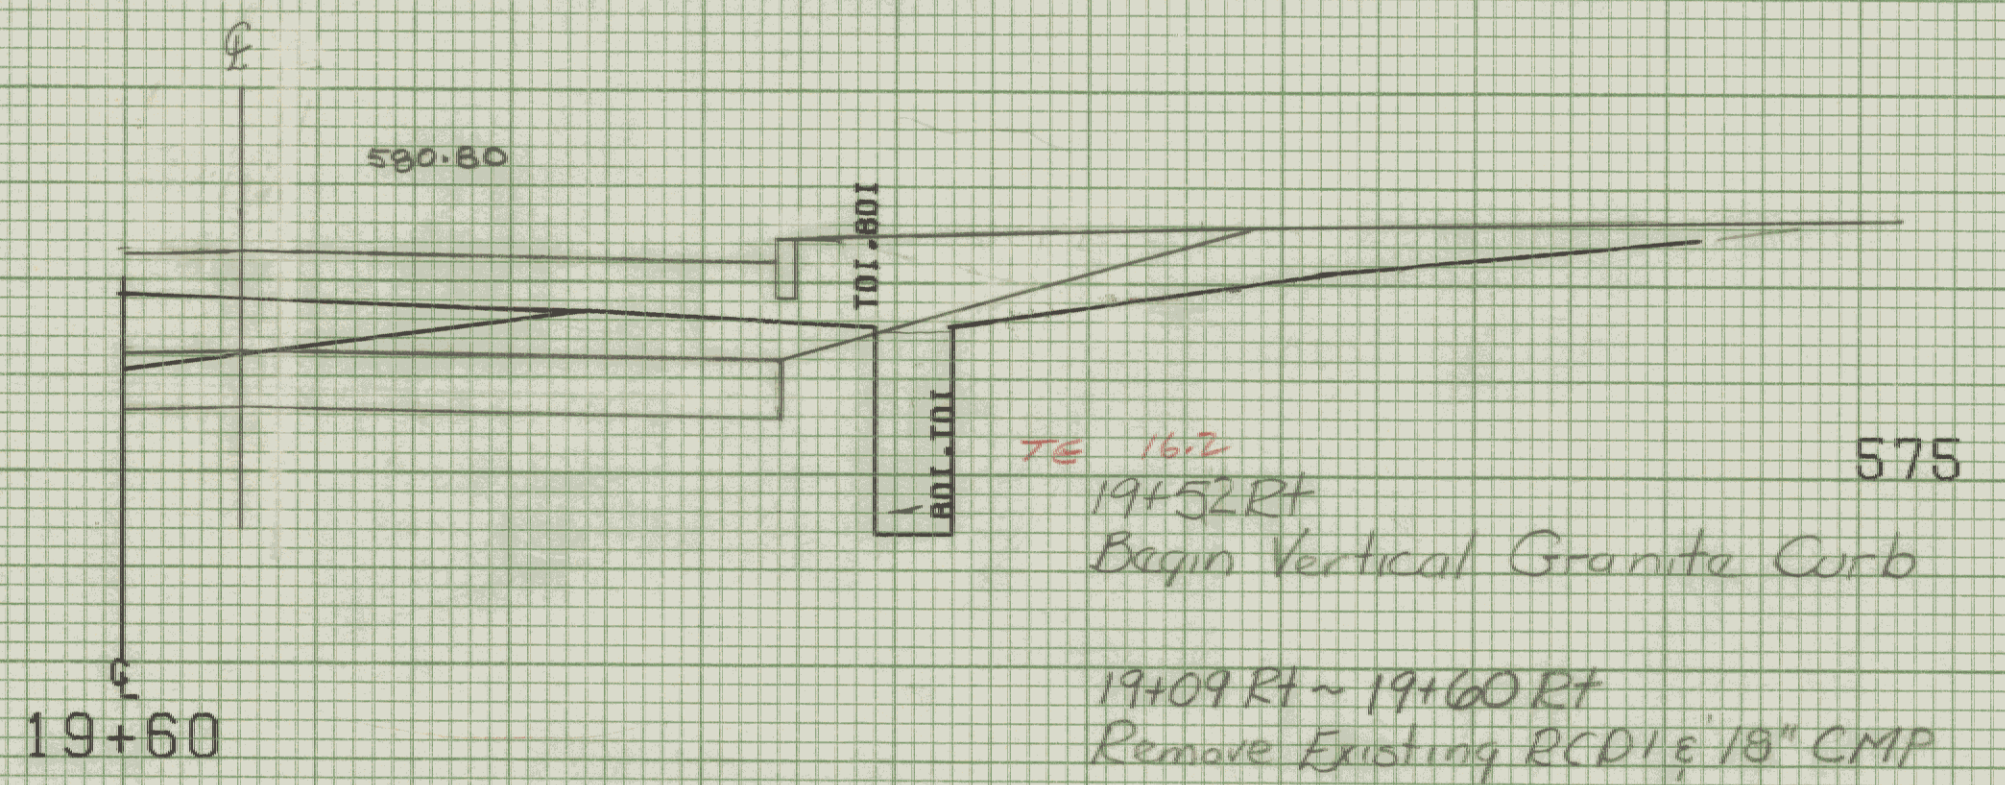

19+50 ~ 20+00 Lt. Deciduous Trees
2 - 1 1/2" Sugar Maples
Trees to be planted outside of R.O.W Limits in a location which is mutually agreeable with the property owner and resident engineer.

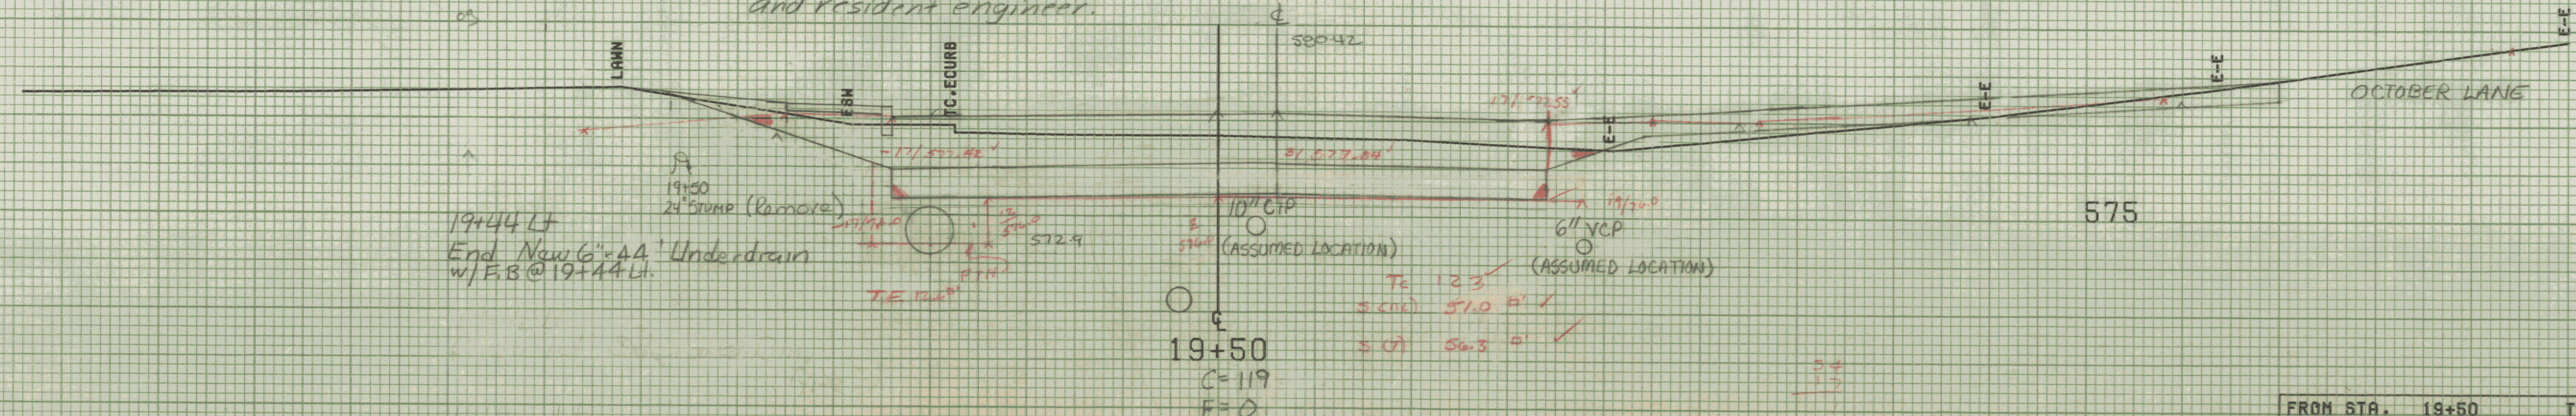

19+44 Lt
End New 6" AA Underdrain w/ F.B @ 19+44 Lt.

19+50
C=119
F=0

SCALE 5 FEET

FROM STA. 19+50	TO STA. 19+62
PROJECT NAME	MONTPELIER MAIN2
NO. M.E.N.	M6400(7)
SURVEYED BY	KASTNER-MOREAU JUNE 1985
SHEET 140	OF 335 SHEETS