
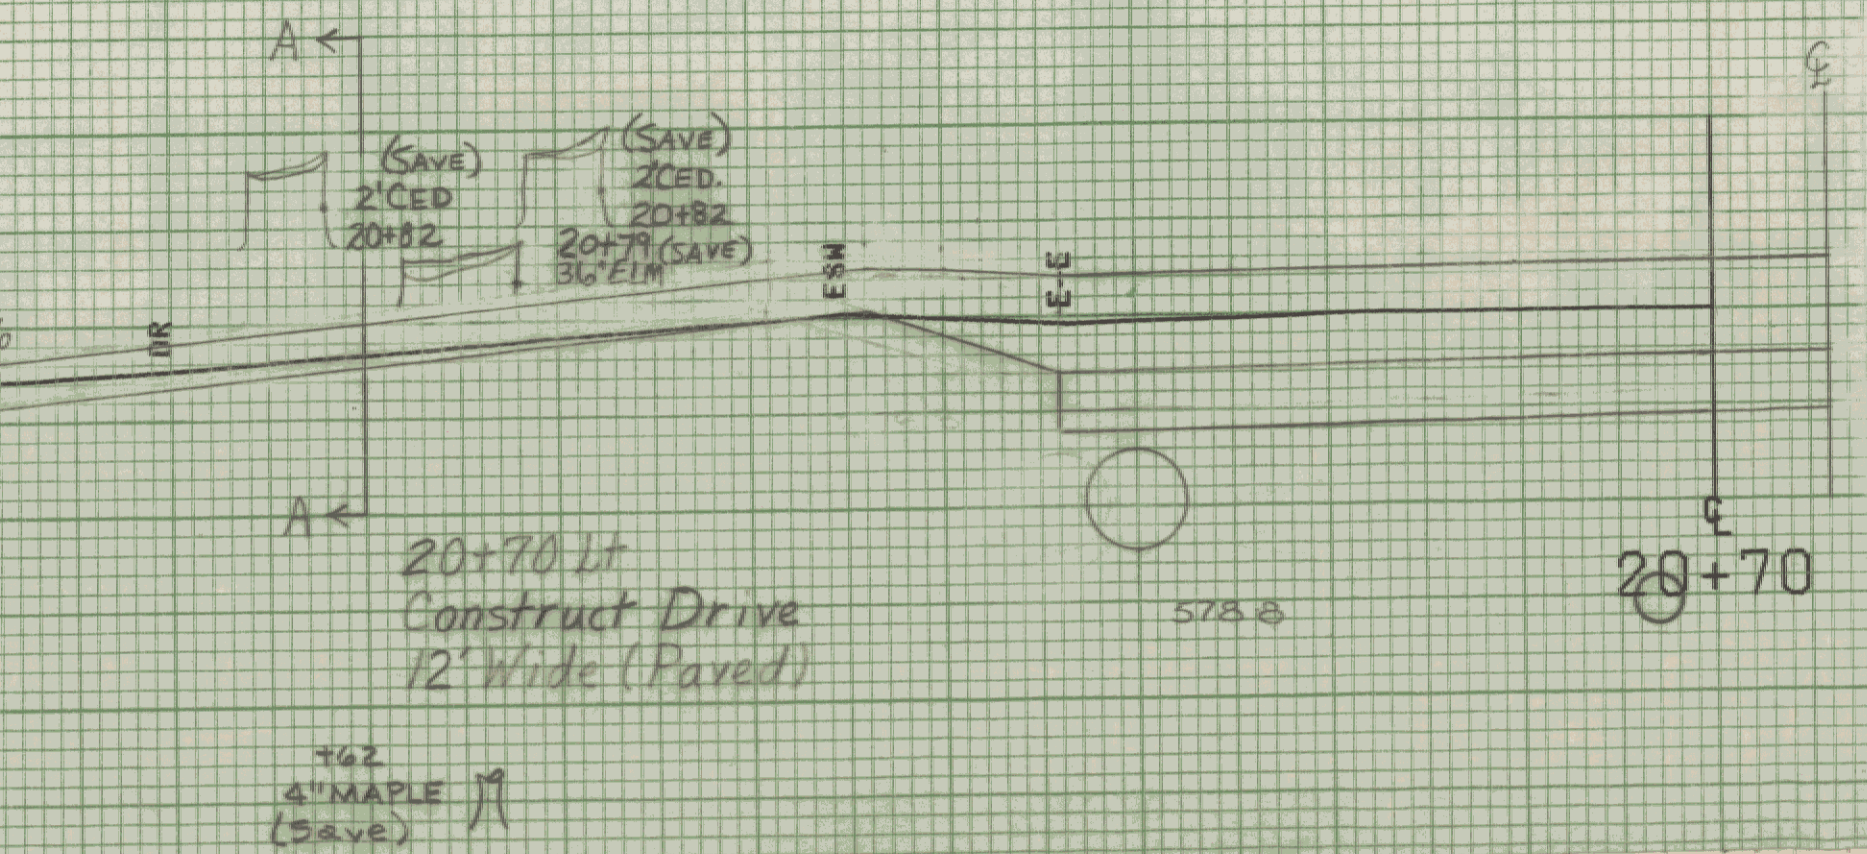
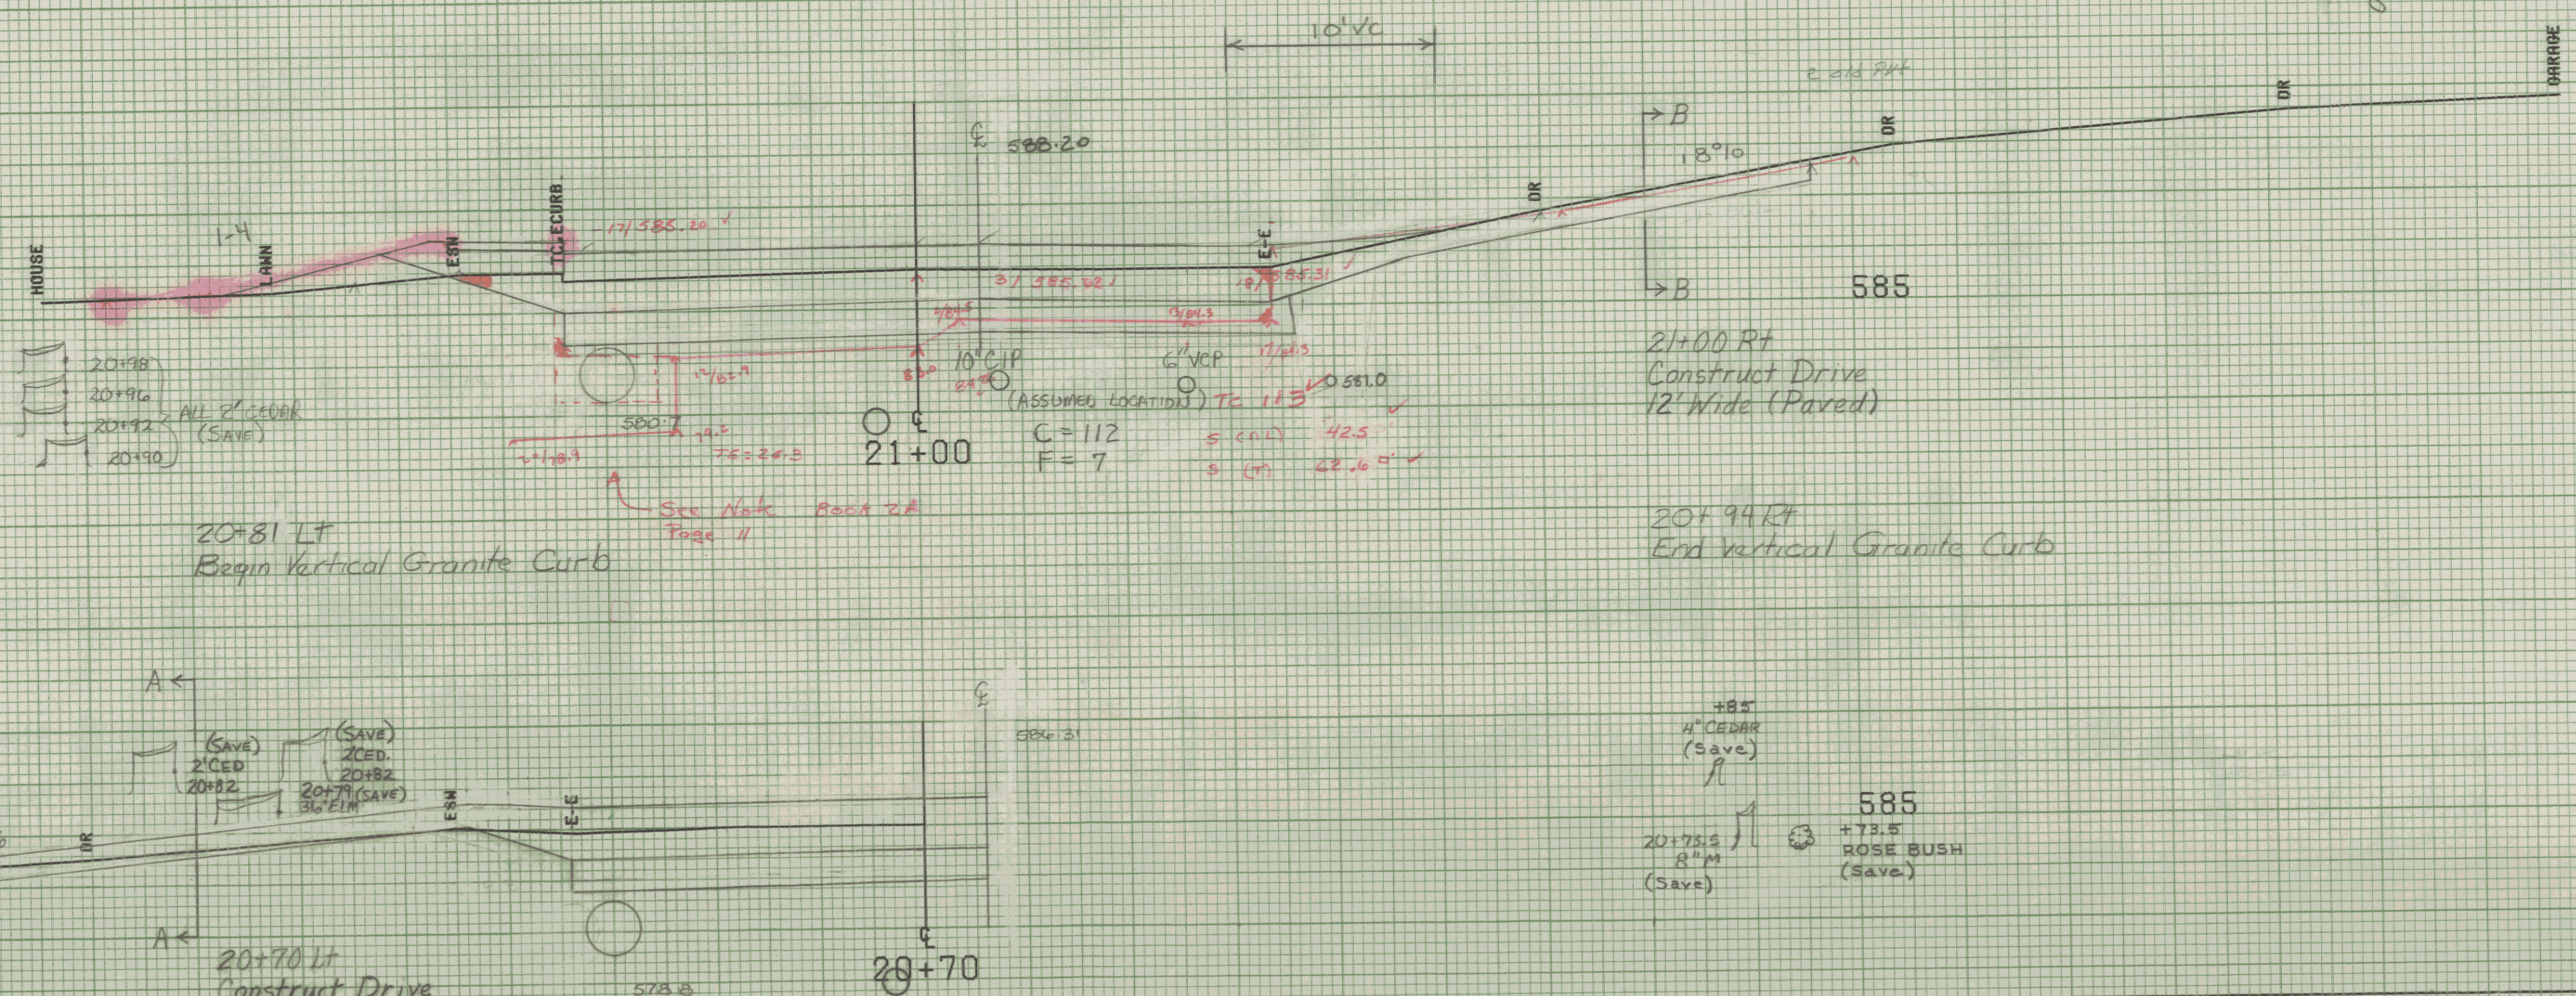
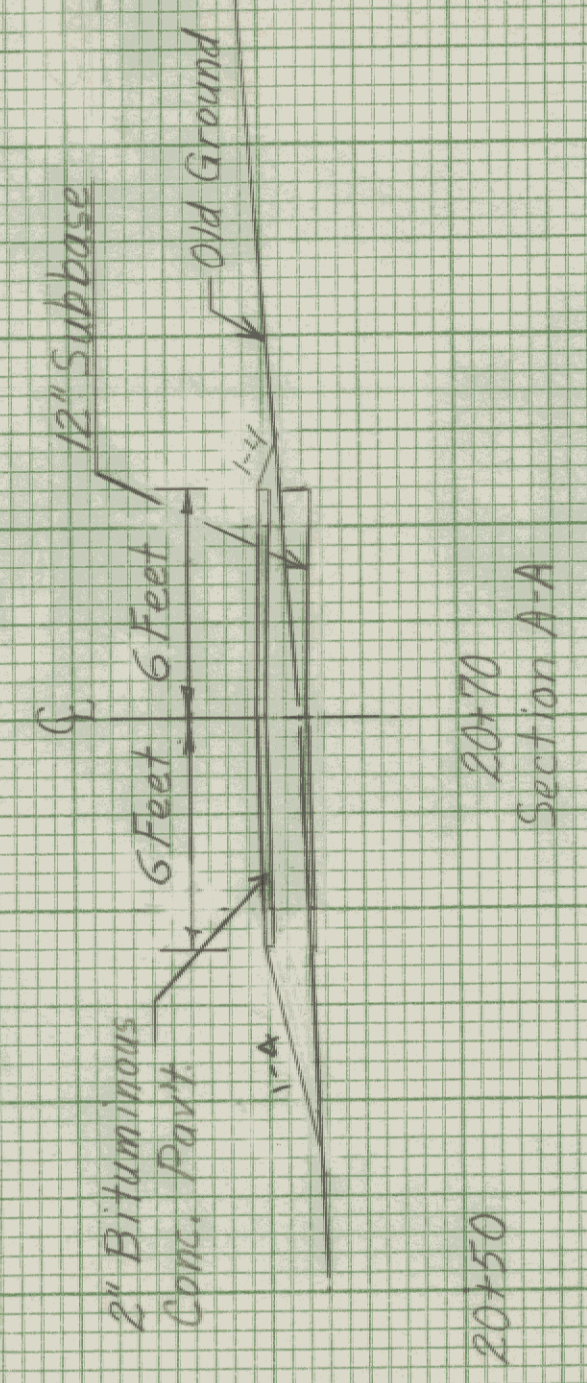


21+07 RT  
Begin Vertical Granite Curb

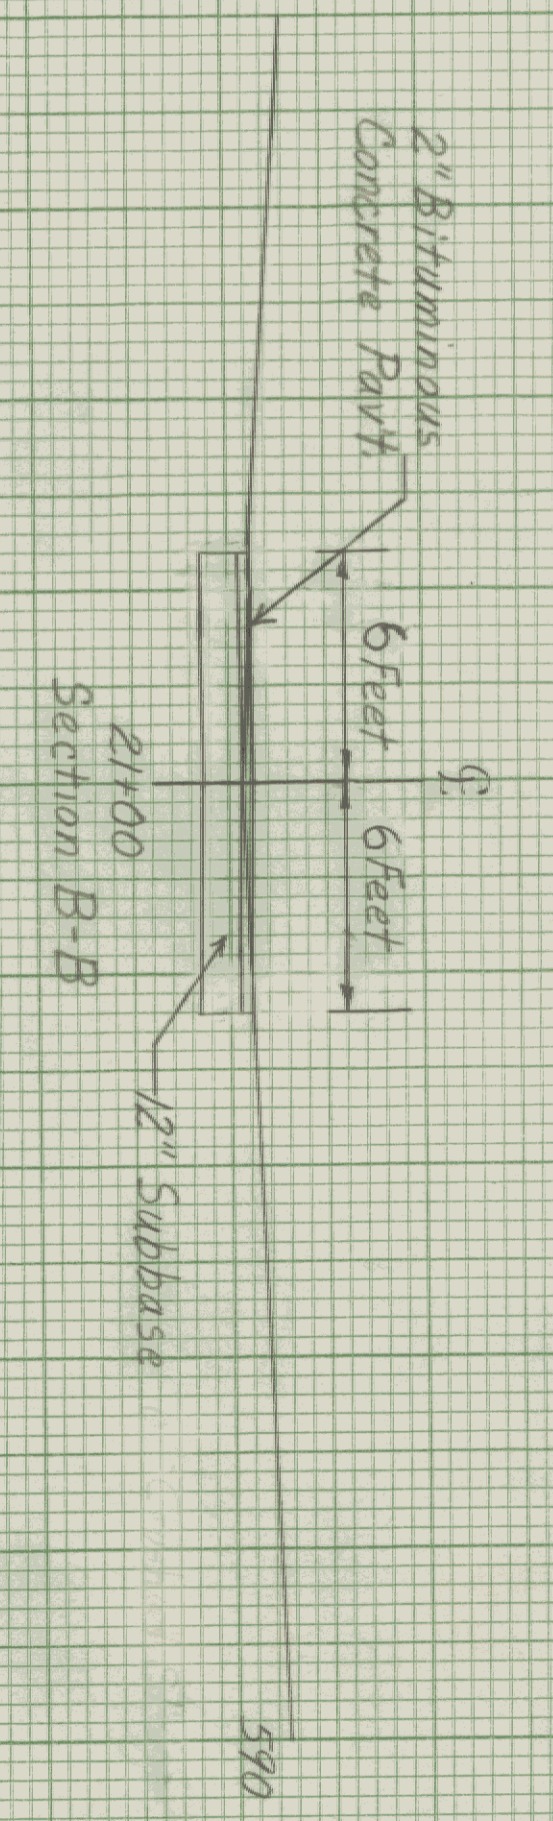

21+00 RT  
Construct Drive  
12' Wide (Paved)

20+94 LT  
End Vertical Granite Curb

- 785 4" CEDAR (Save)
- 773.5 ROSE BUSH (Save)
- 20+73.5 8" M (Save)

Plan F5 ✓ DW 6 JAN 93  
Plot F5 4-29-93

FROM STA.	20+70	TO STA.	21+05
PROJECT NAME	MONTPELIER MAIN2		
NO.	M EOC-16400(7)	PLOTTED	08/07/85
SURVEYED BY	KASTNER-MOREAU JUNE 1985		
SHEET	169	OF	335 SHEETS

SCALE 5 FEET