


22+03 Lt. Transplanting Shrub  
Mock Orange  
Shrub to be transplanted outside of the R.O.W. in a location which is mutually agreeable with the property owner and the resident engineer.

22+21 Rt  
Construct Drive  
12' Wide (Paved)  
22+12 Rt  
End Vertical Granite Curb

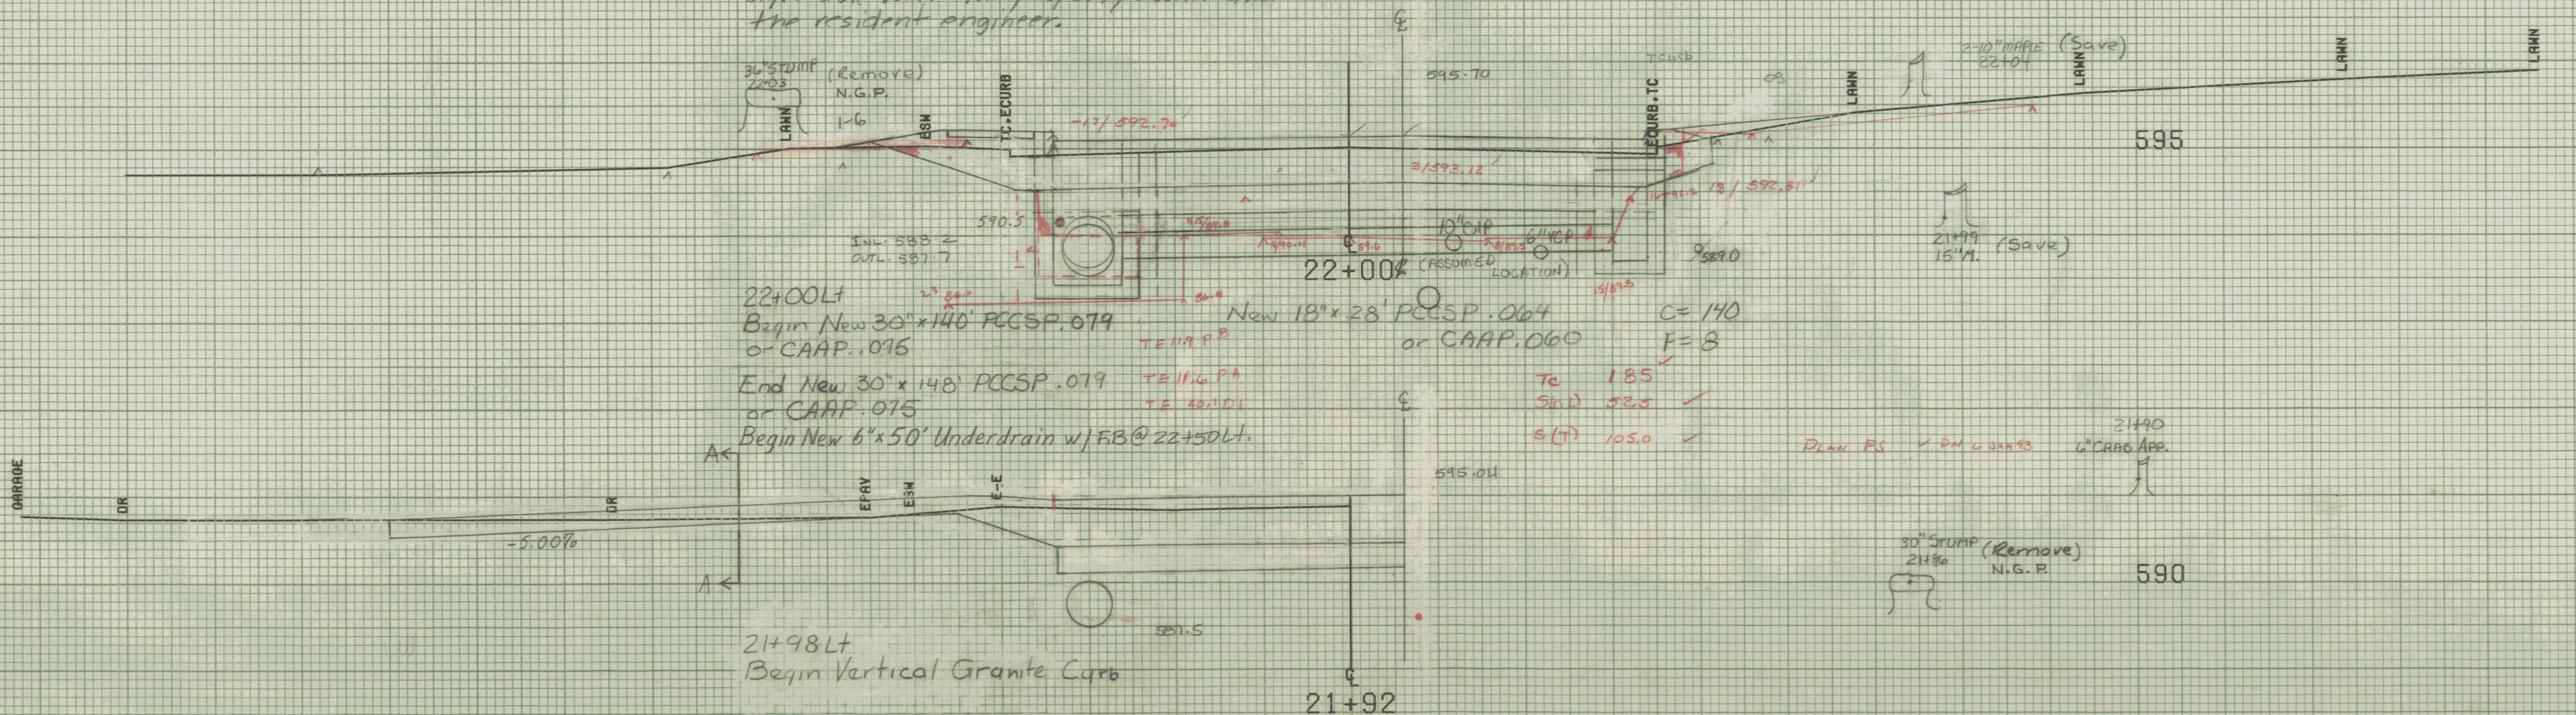

22+00 Lt  
Begin New 30" x 148' PCCSP. 079  
or C.A.P. 076  
End New 30" x 148' PCCSP. 079  
or C.A.P. 075  
Begin New 6" x 50' Underdrain w/ FB @ 22+50 Lt.

New 18" x 28' PCCSP. 064  
or C.A.P. 060  
C=140  
F=8  
Tc 185  
Skid 32.5 ✓  
S(1) 105.0 ✓

21+98 Lt  
Begin Vertical Granite Curb  
21+85 Lt  
Construct Drive  
15' Wide (Paved)