




3" P. 24130.5
 3" P. 24131
 4" P. 24131
 3" P. 24130.5
 3" P. 24130.5
 4" P. 24130.5

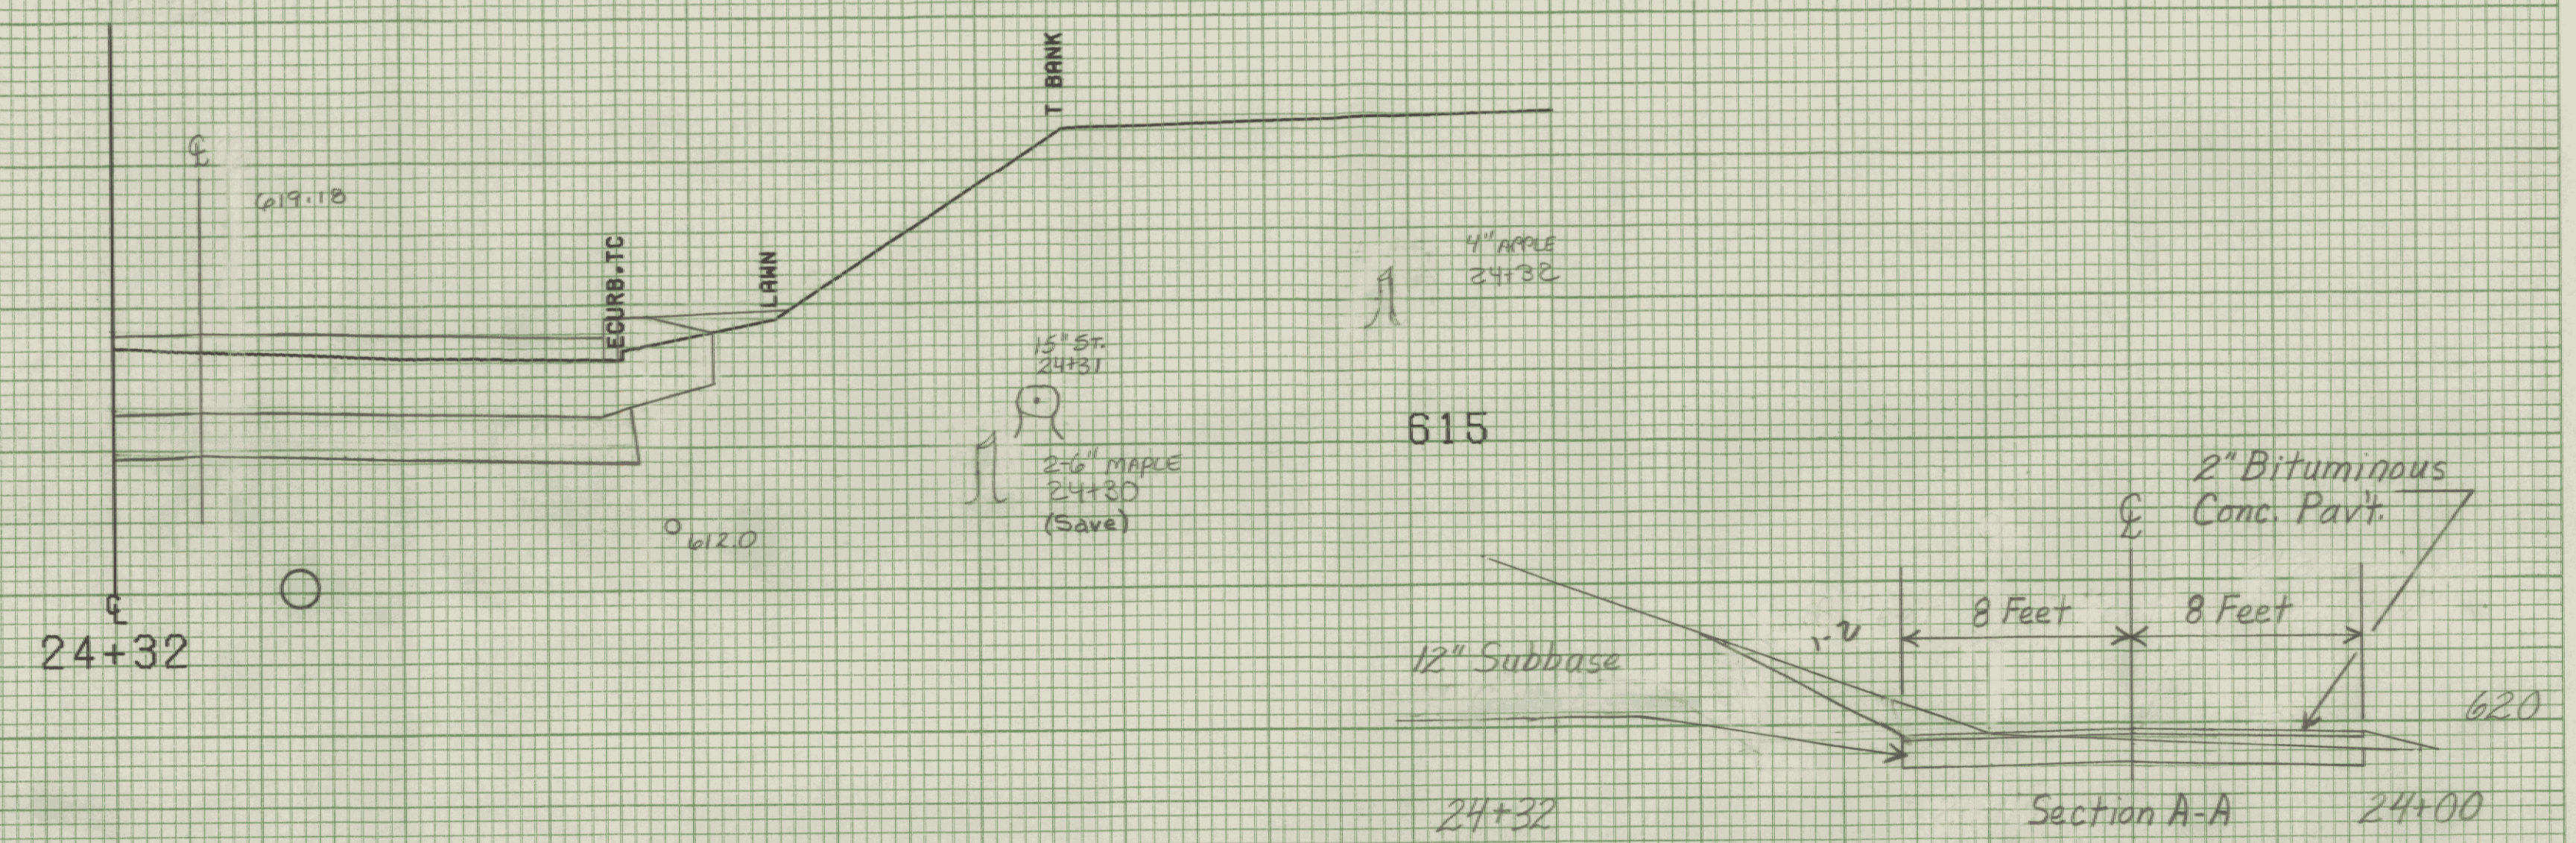

24+19 RT
 Begin Vertical Granite Curb

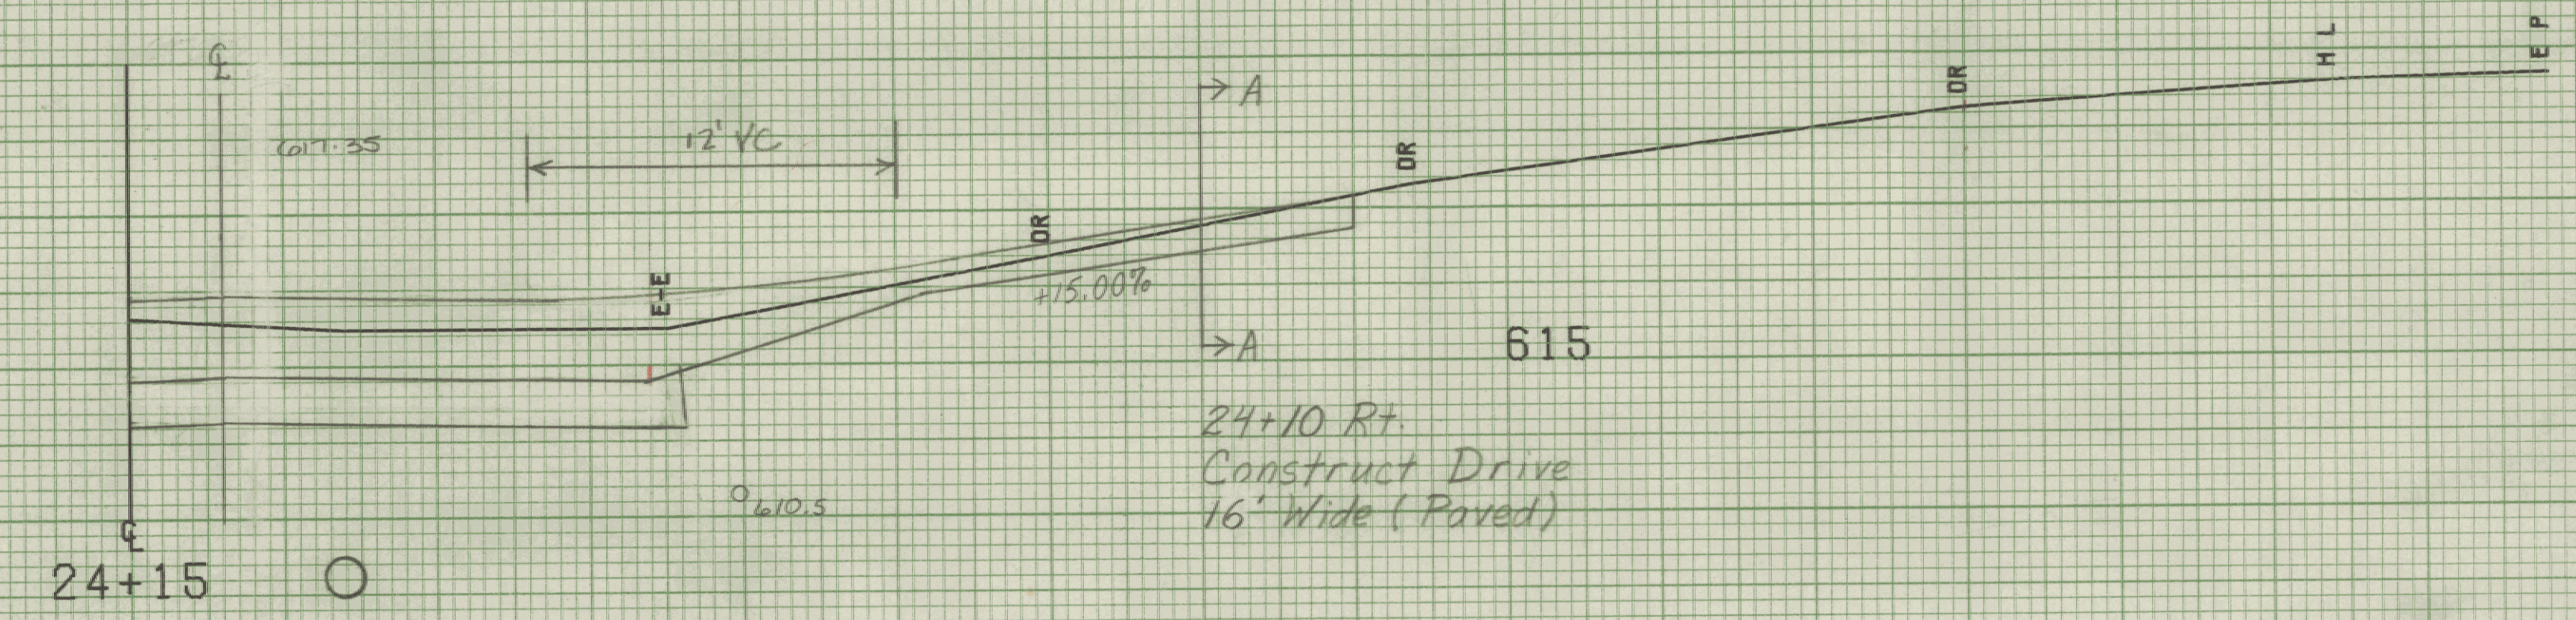

24+10 RT
 Construct Drive
 16' Wide (Paved)

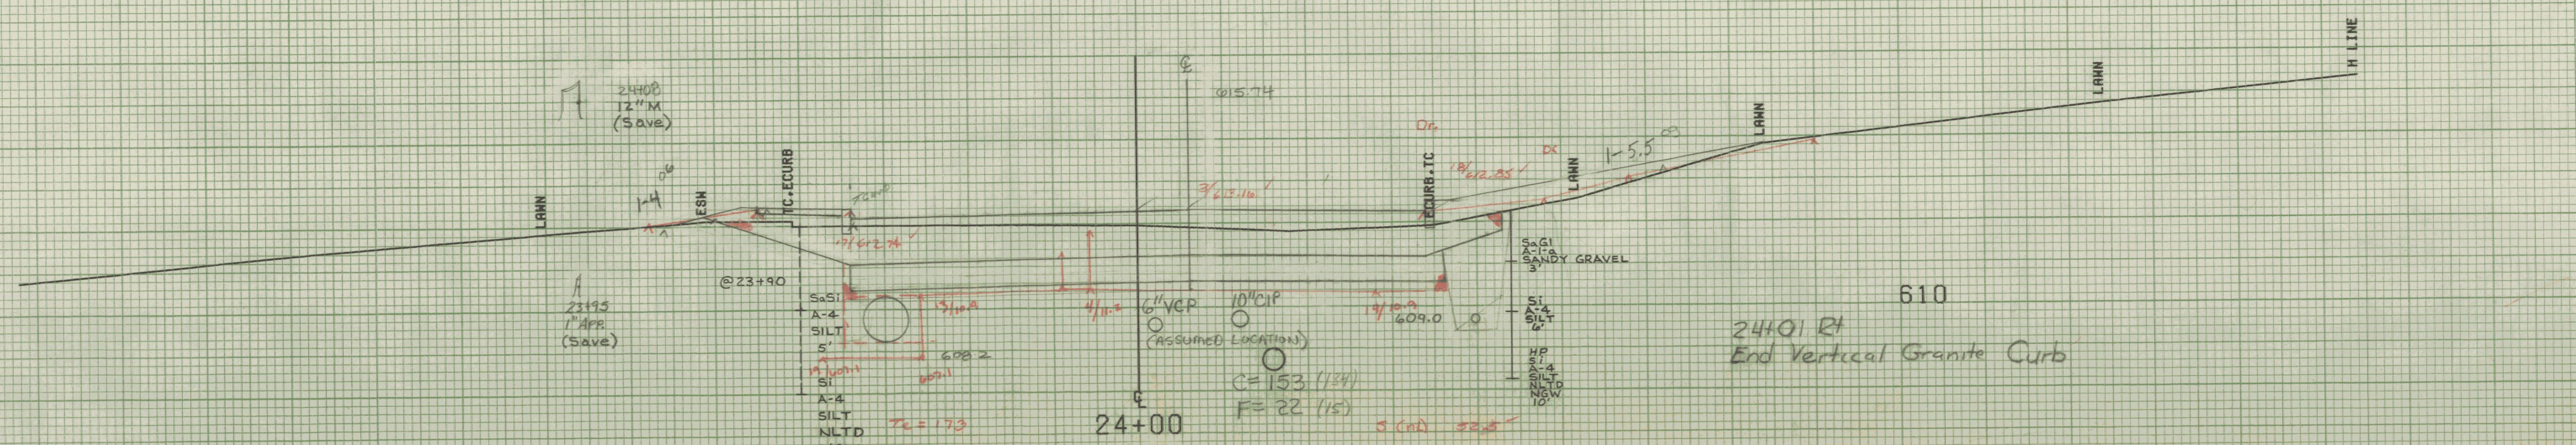

24+01 RT
 End Vertical Granite Curb

FROM STA. 24+00 TO STA. 24+32
 PROJECT NAME MONTPELIER MAIN2
 NO. M 660 N6400(7) PLOTTED 06/07/85
 SURVEYED BY KASNER-MOREAU JUNE 1985
 SHEET 14 OF 335 SHEETS

SCALE 5 FEET

Plan July 12/2/93