
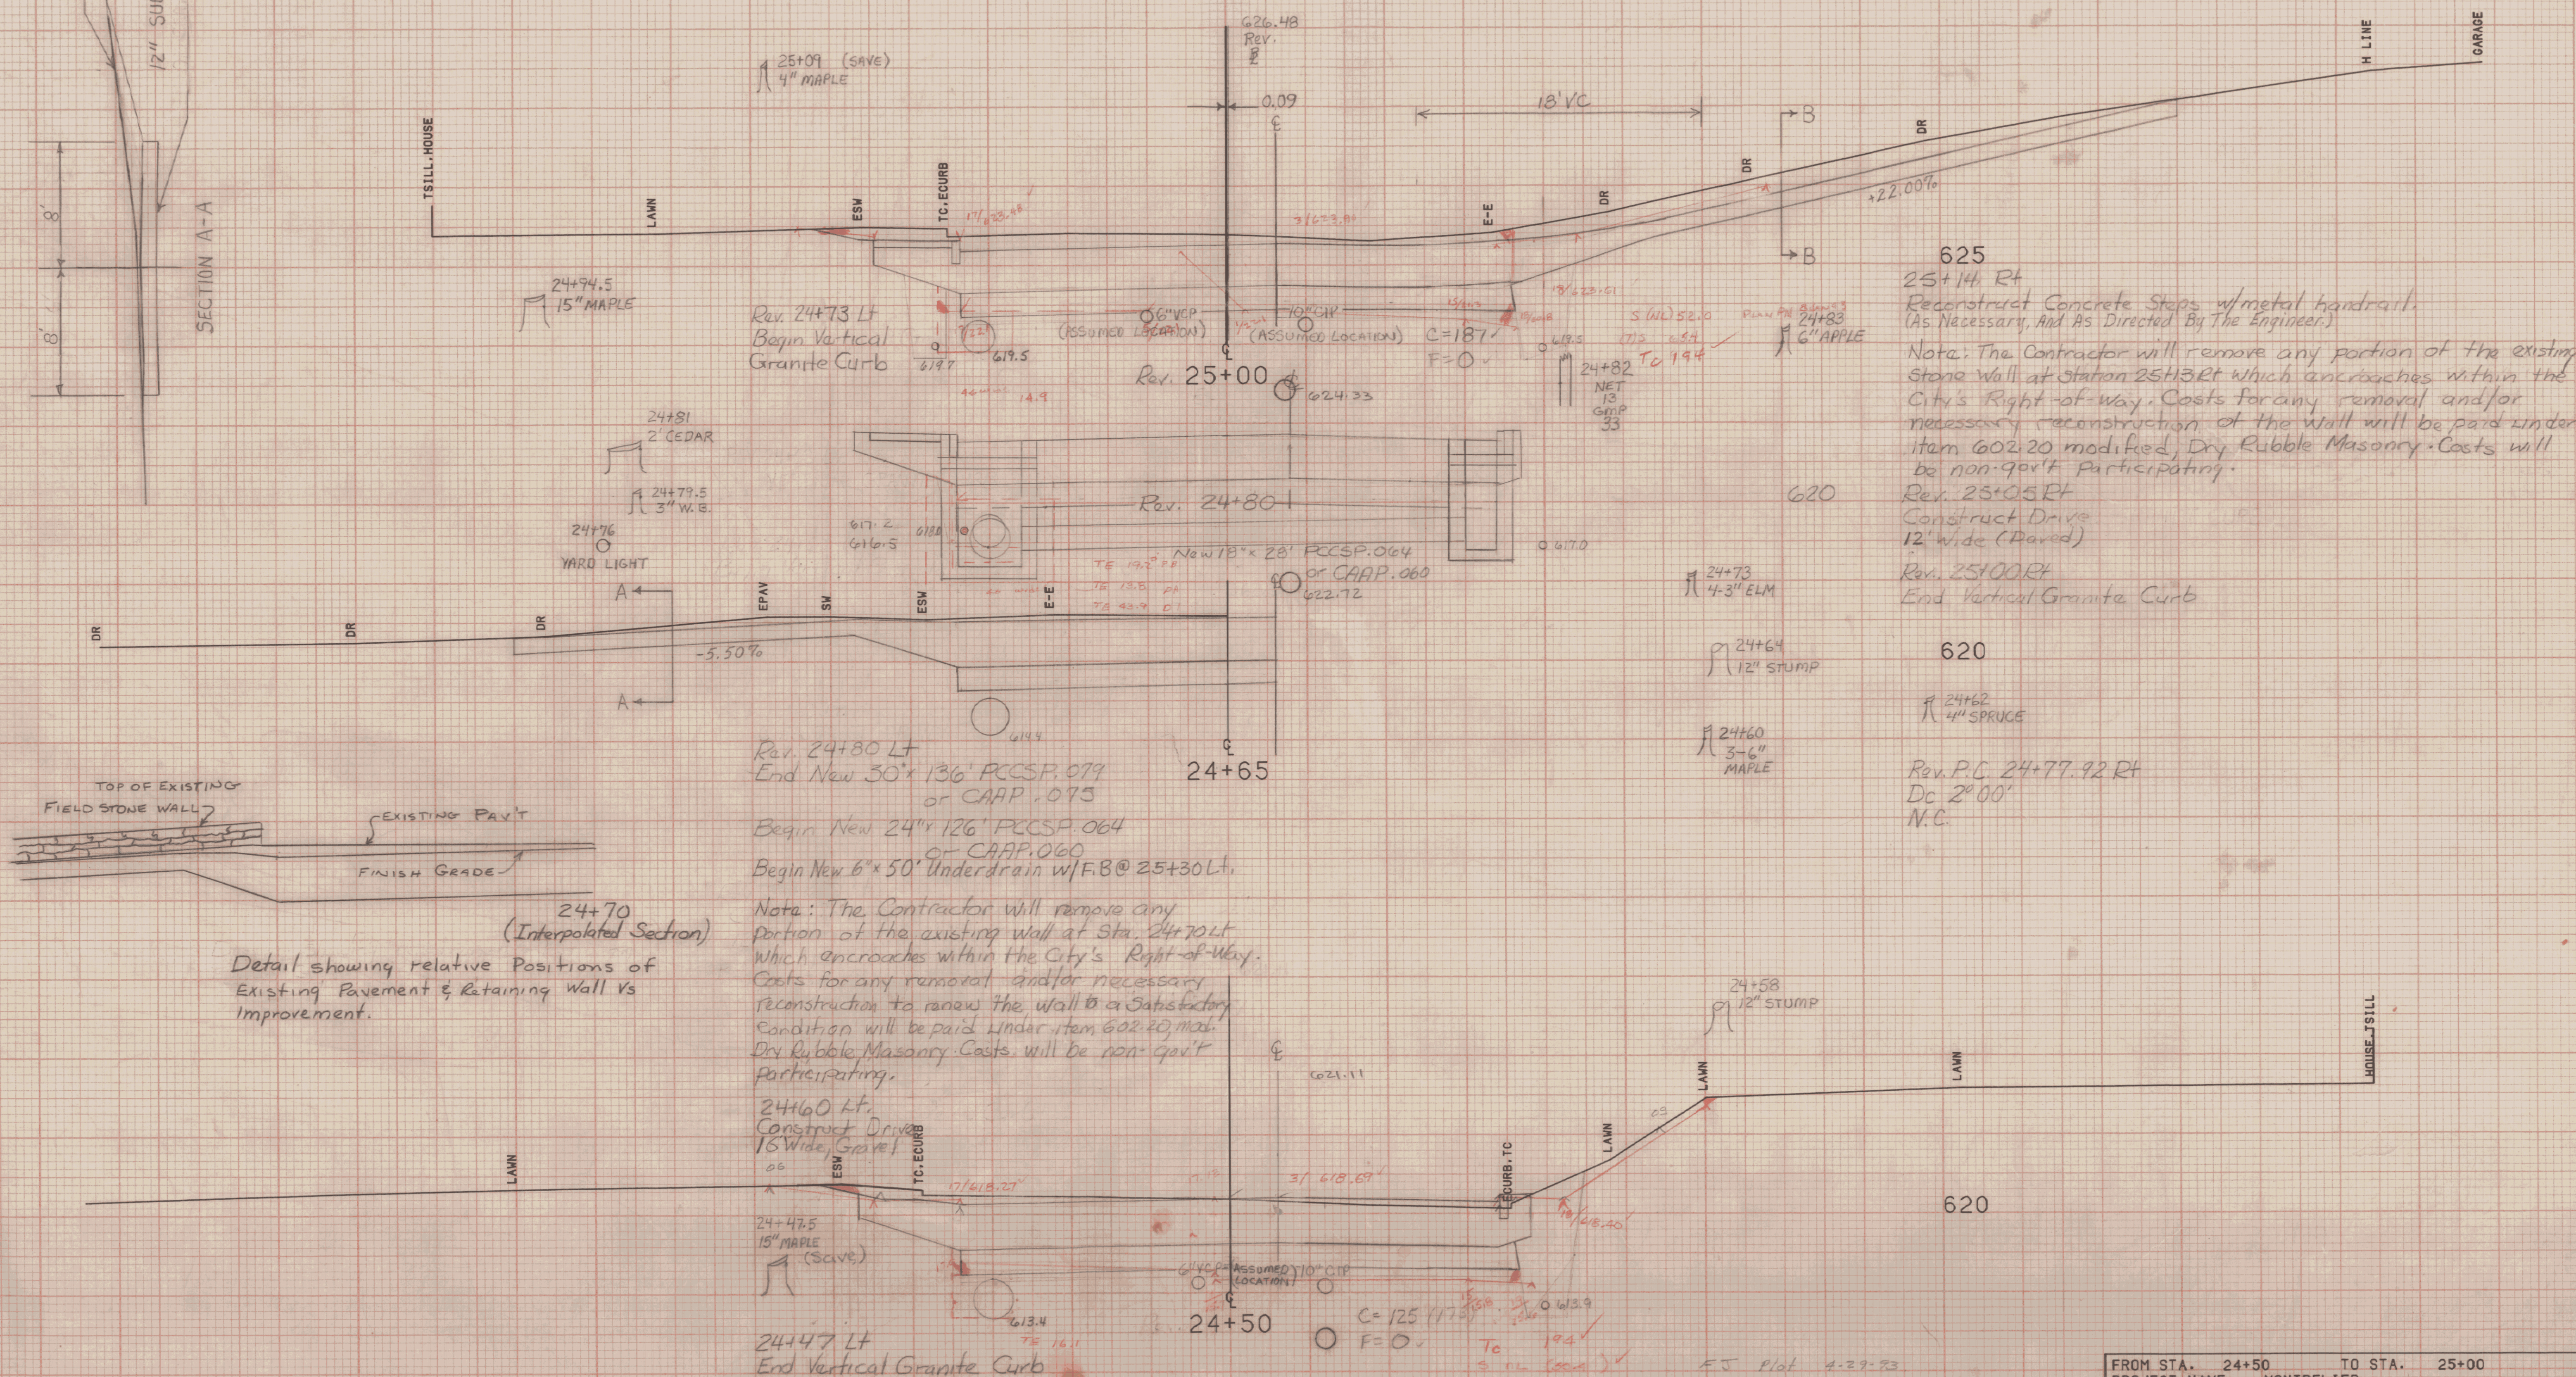
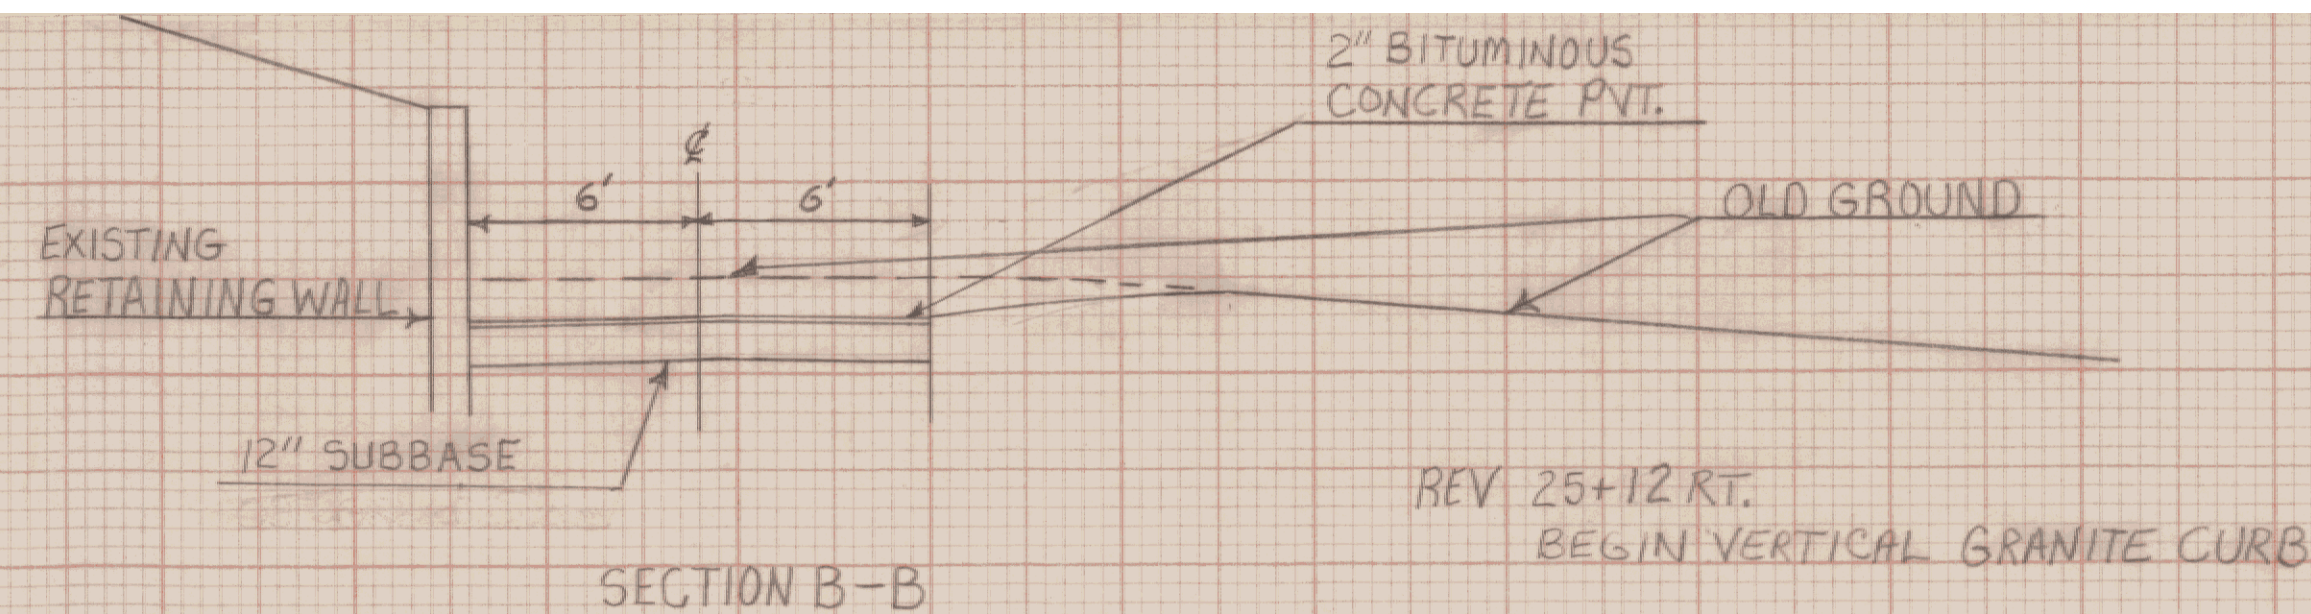


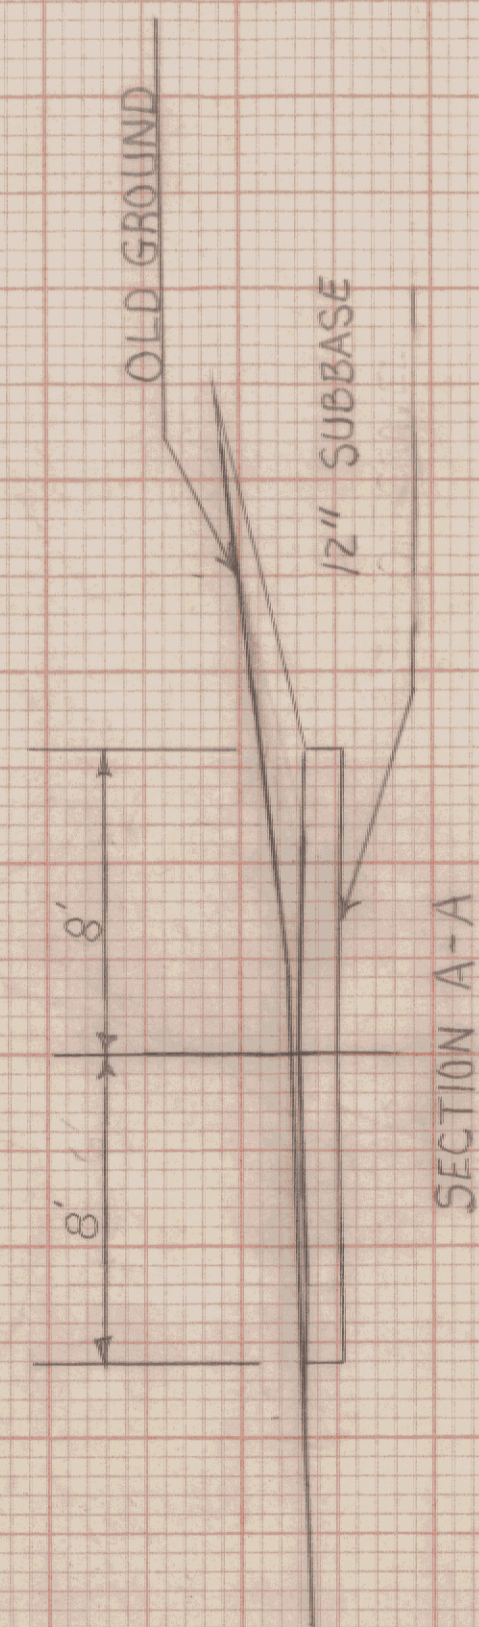

24+70
(Interpolated Section)
Detail showing relative Positions of
Existing Pav't & Retaining Wall vs
Improvement.

625
25+14.1 Rt
Reconstruct Concrete Steps w/metal handrail.
(As Necessary, And As Directed By The Engineer.)
Note: The Contractor will remove any portion of the existing
Stone Wall at Station 25+13.75 which encroaches within the
City's Right-of-way. Costs for any removal and/or
necessary reconstruction of the wall will be paid under
Item 602.20 modified, Dry Rubble Masonry. Costs will
be non-qual. Participating.
Rev. 25+05.15
Construct Drive
12' wide (Paved)
Rev. 25+00.15
End Vertical Granite Curb
620
24+73
4-3" ELM
24+64
12" STUMP
24+60
3-6" MAPLE
24+62
4" SPRUCE
Rev. P.C. 24+77.92 Rt
D.C. 2° 00'
N.C.