
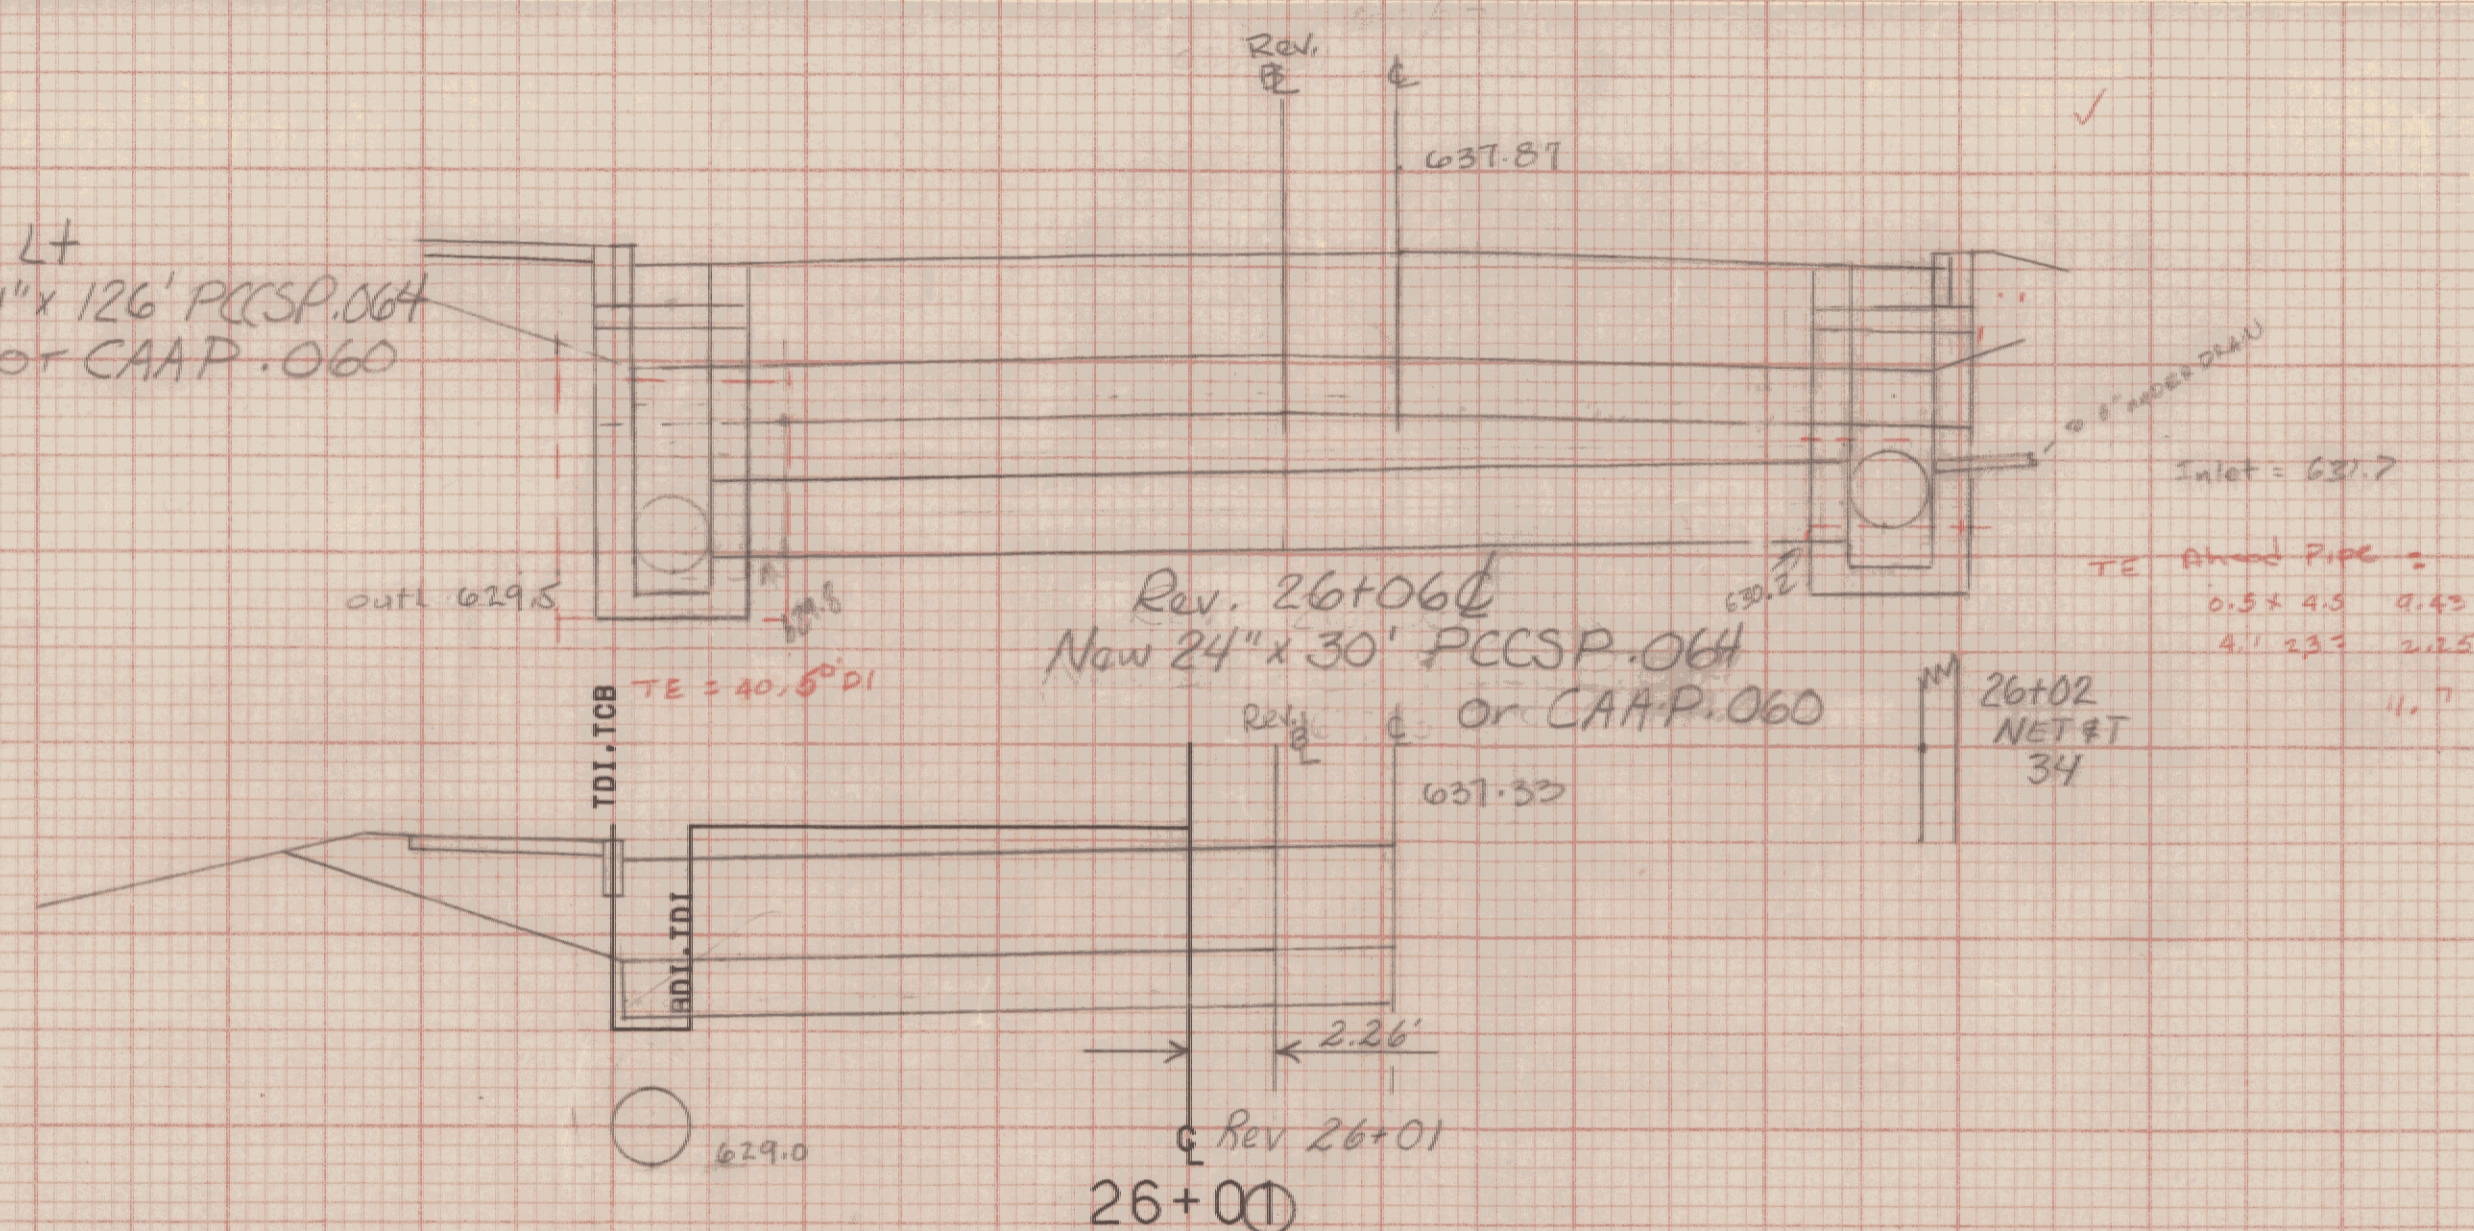


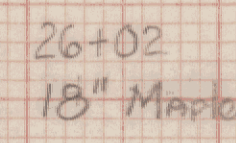


Rev. 26+06R4
Begin New 24"x188" POCSP.064
or CAAP.060

635

Rev. 26+06 ~ 26+15 R+

Rev. 26+10 Rt
End New 6"x268' Underdrain
w/Flushing Basin @ 26+10 Rt

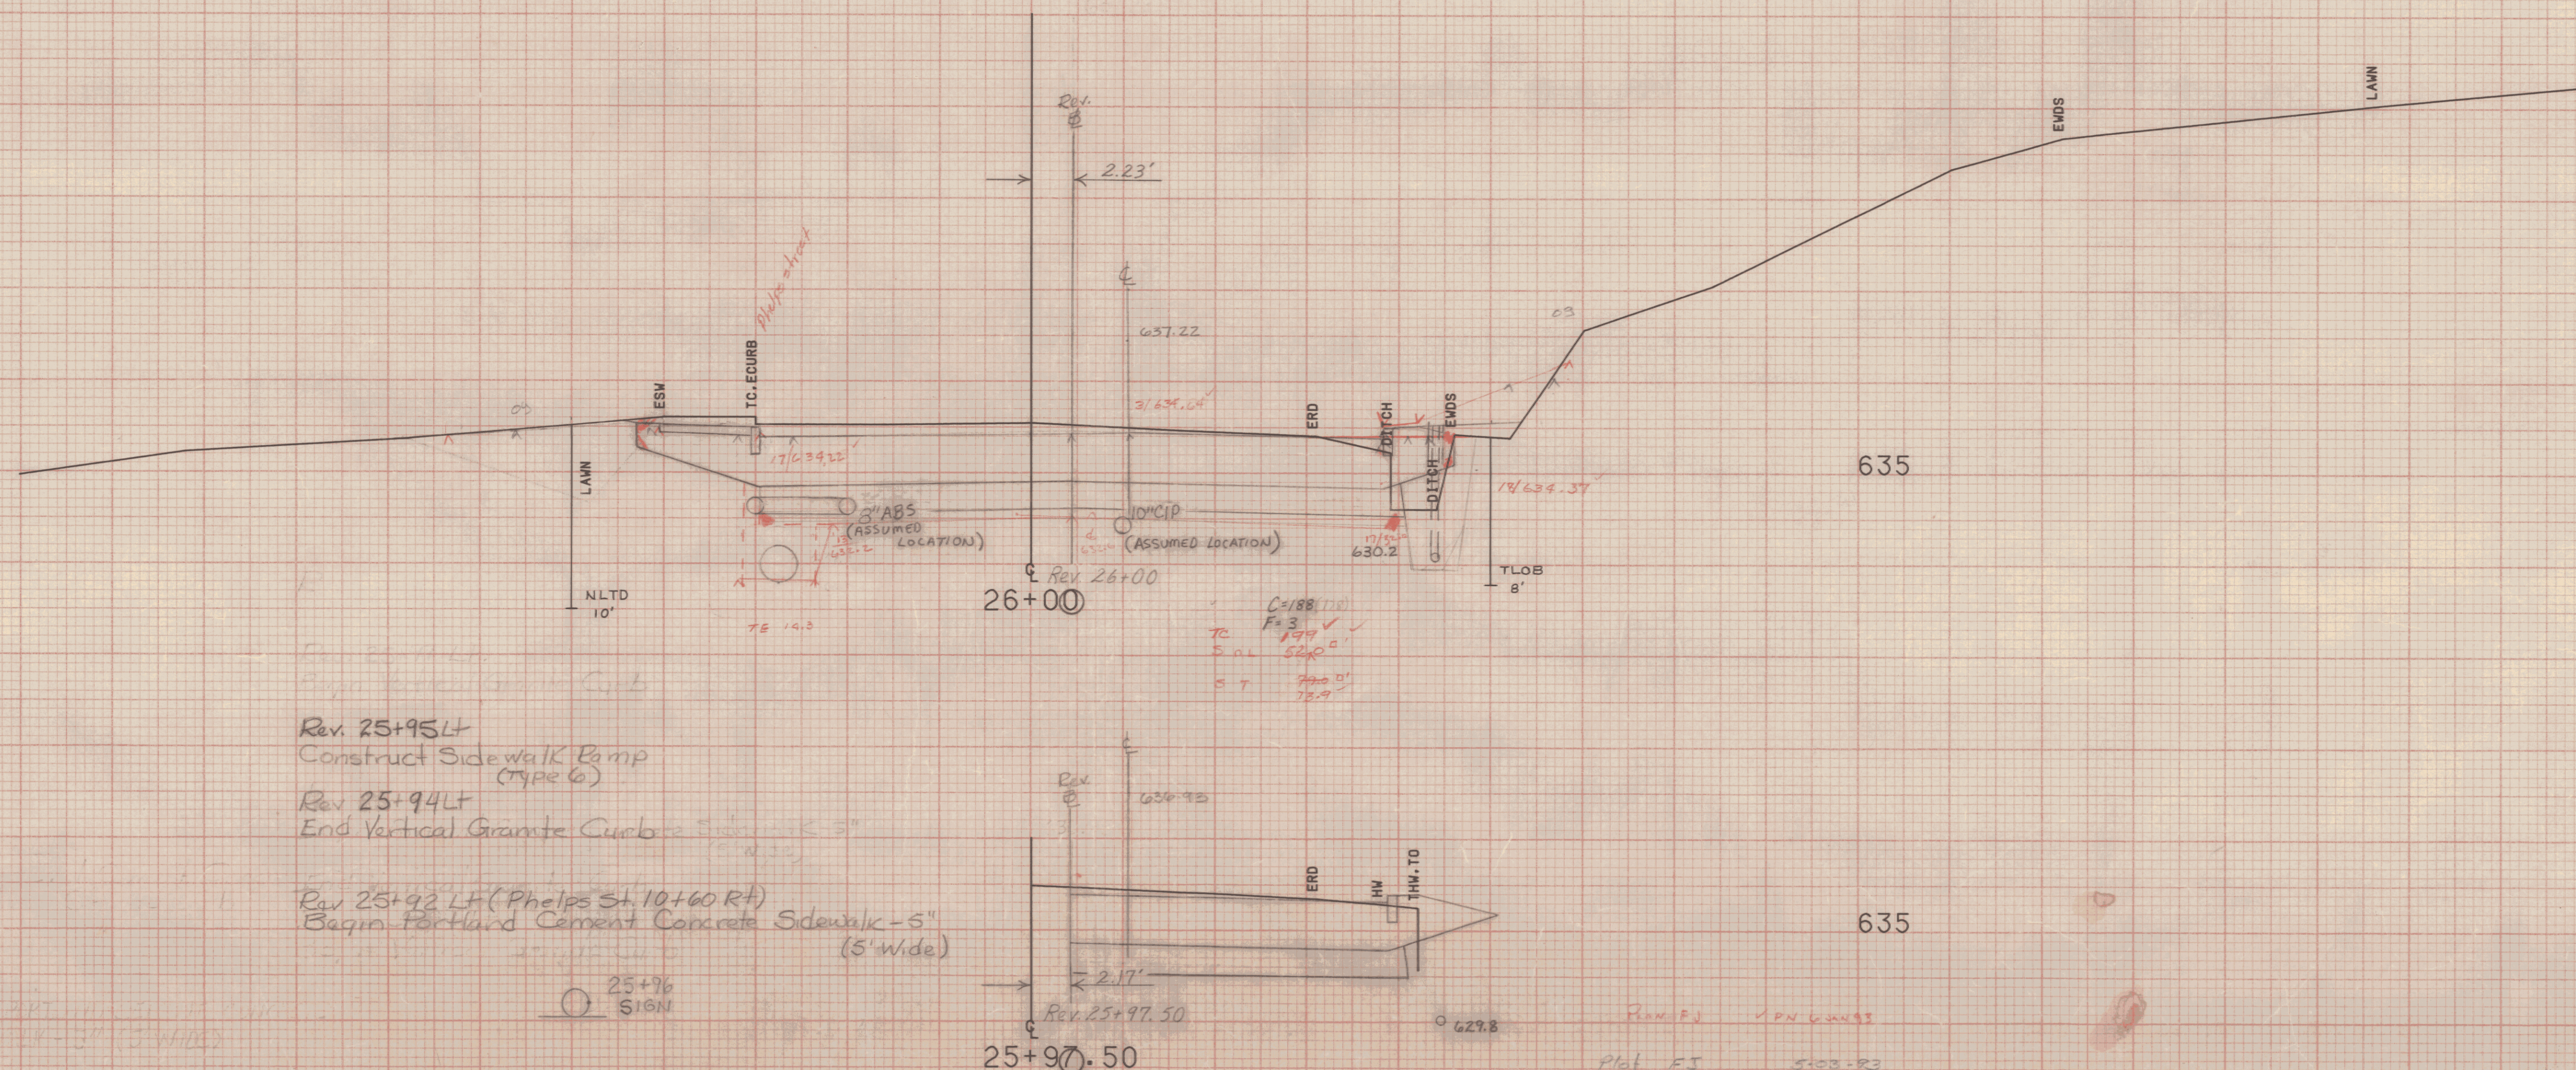

Rev. 25+95.4
Construct Sidewalk Pump
(Type 6)

Rev 25+94.47
End Vertical Granite Curve Side Slope 1:K=5"

Rav 25+92 LT (Phelps St 10+60 RT)
Begin Portland Cement Concrete Sidewalk - 5"
(5' wide)

25+96
SIGN

635

635

FROM STA. 25+97.50 TO STA. 26+01
PROJECT NAME MONTPELIER
NO. M 866-M6400 (7) PLOTTED 05/04/87
SURVEYED BY KASTNER-MOREAU 06/85
SHEET 178 OF 335 SHEETS

SCALE 5 FEET