


Rev. 28+45 Lt.  
 End New 6" x 50' Underdrain  
 w/ F.B. @ 28+45 Lt.

Rev 28+10 Rt  
 Exist. 18" RCP to be plugged & to remain in place

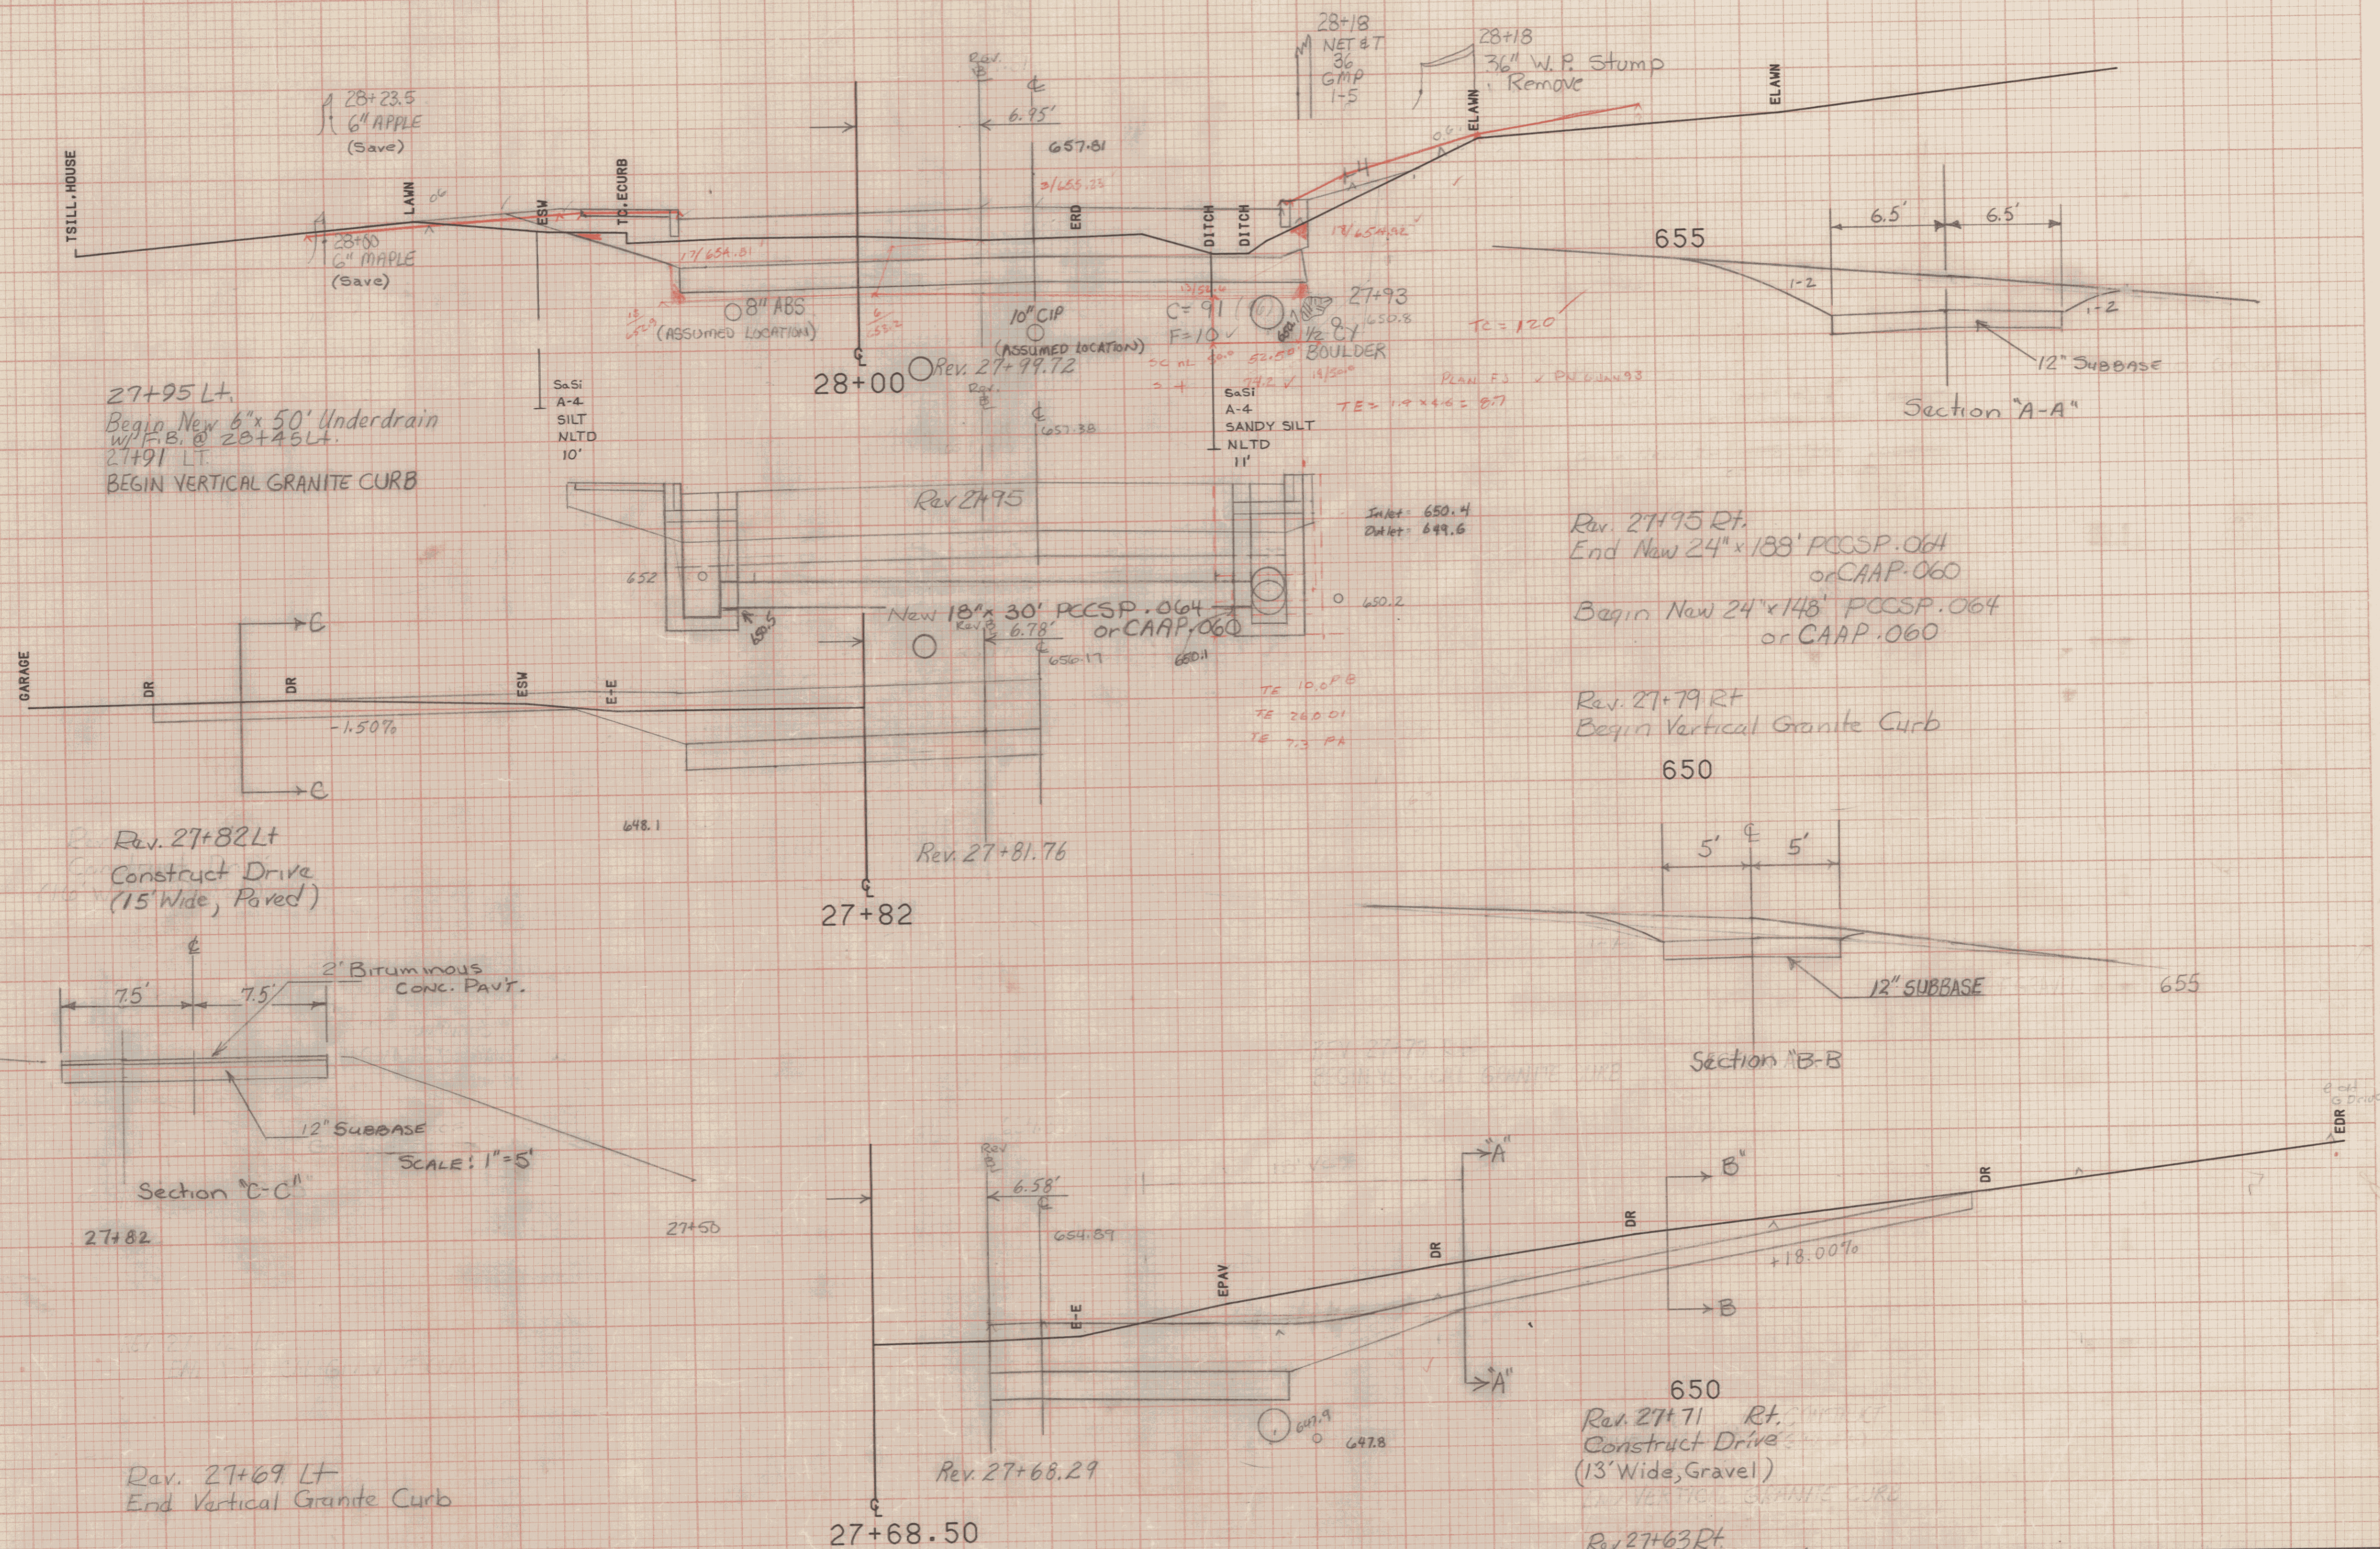


27+95 Lt.  
 Begin New 6" x 50' Underdrain  
 w/ F.B. @ 28+45 Lt.  
 27+91 Lt.  
 BEGIN VERTICAL GRANITE CURB

Rev. 27+95 Rt.  
 End New 24" x 189' PCCSP.064  
 or CAAP.060  
 Begin New 24" x 148' PCCSP.064  
 or CAAP.060

Rev. 27+79 Rt  
 Begin Vertical Granite Curb  
 650

Rev. 27+82 Lt  
 Construct Drive  
 (15' Wide, Paved)

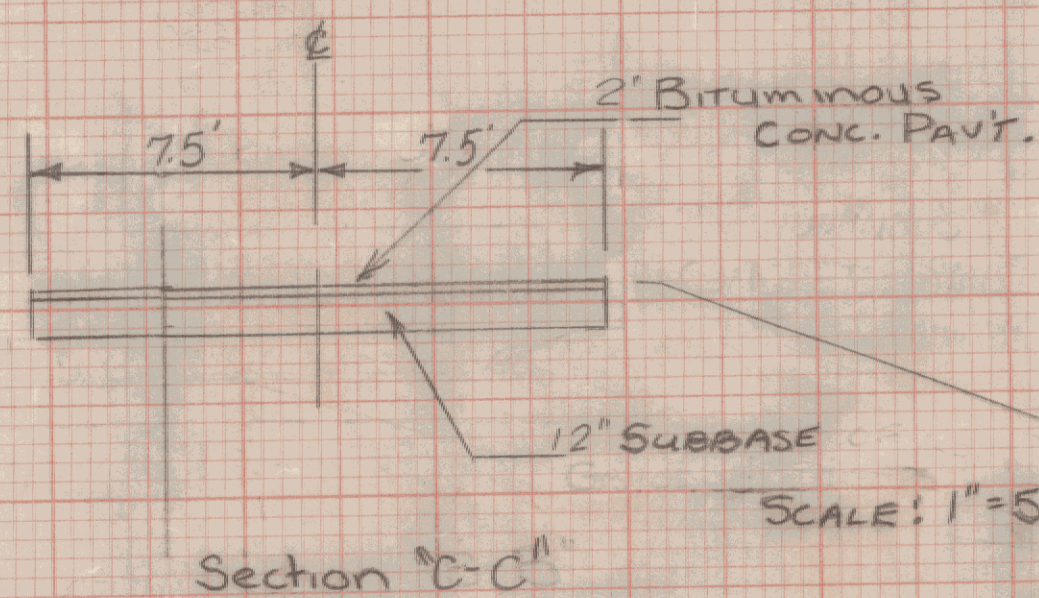

Rev. 27+69 Lt  
 End Vertical Granite Curb

Rev. 27+71 Rt.  
 Construct Drive  
 (13' Wide, Gravel)  
 BEGIN VERTICAL GRANITE CURB

Rev. 27+63 Rt  
 End Vertical Granite Curb

FROM STA.	27+68.50	TO STA.	28+00
PROJECT NAME	MONTPELIER		
	NO. M. 6400 (7)		
SURVEYED BY	KASTNER-MOREAU 06/85		PLOTTED 05/04/87
SHEET	181	OF	335 SHEETS

SCALE 1" = 5 FEET

Plot 55 5 23 93  
 Plot 9mm/10/15/93  
 Plan 1/2" = 1' 03/93