

Rev. 29+44 RT
 Begin New 24" x 120" PCCSP .064 or CAAP .060
 End New 24" x 148" PCCSP .064 or CAAP .060

See Wilson St. X-Section 15+50
 Sheet 156



29+44 Rt. ~ Wilson St. 15+50 Rt.
 New 12" x 60' CSP (.064) or CAAP (.060)

Rev. 29+48 LT
 End Vertical Granite Curb

Rev. 29+40 LT
 Remove & Reset Flagstone Walk (3' wide)
 To Be Paid as Cement Rubble Masonry

New 18" x 30' PCCSP .064 or CAAP .060

TE = 28.6 DI 5' x 4' x 4.5

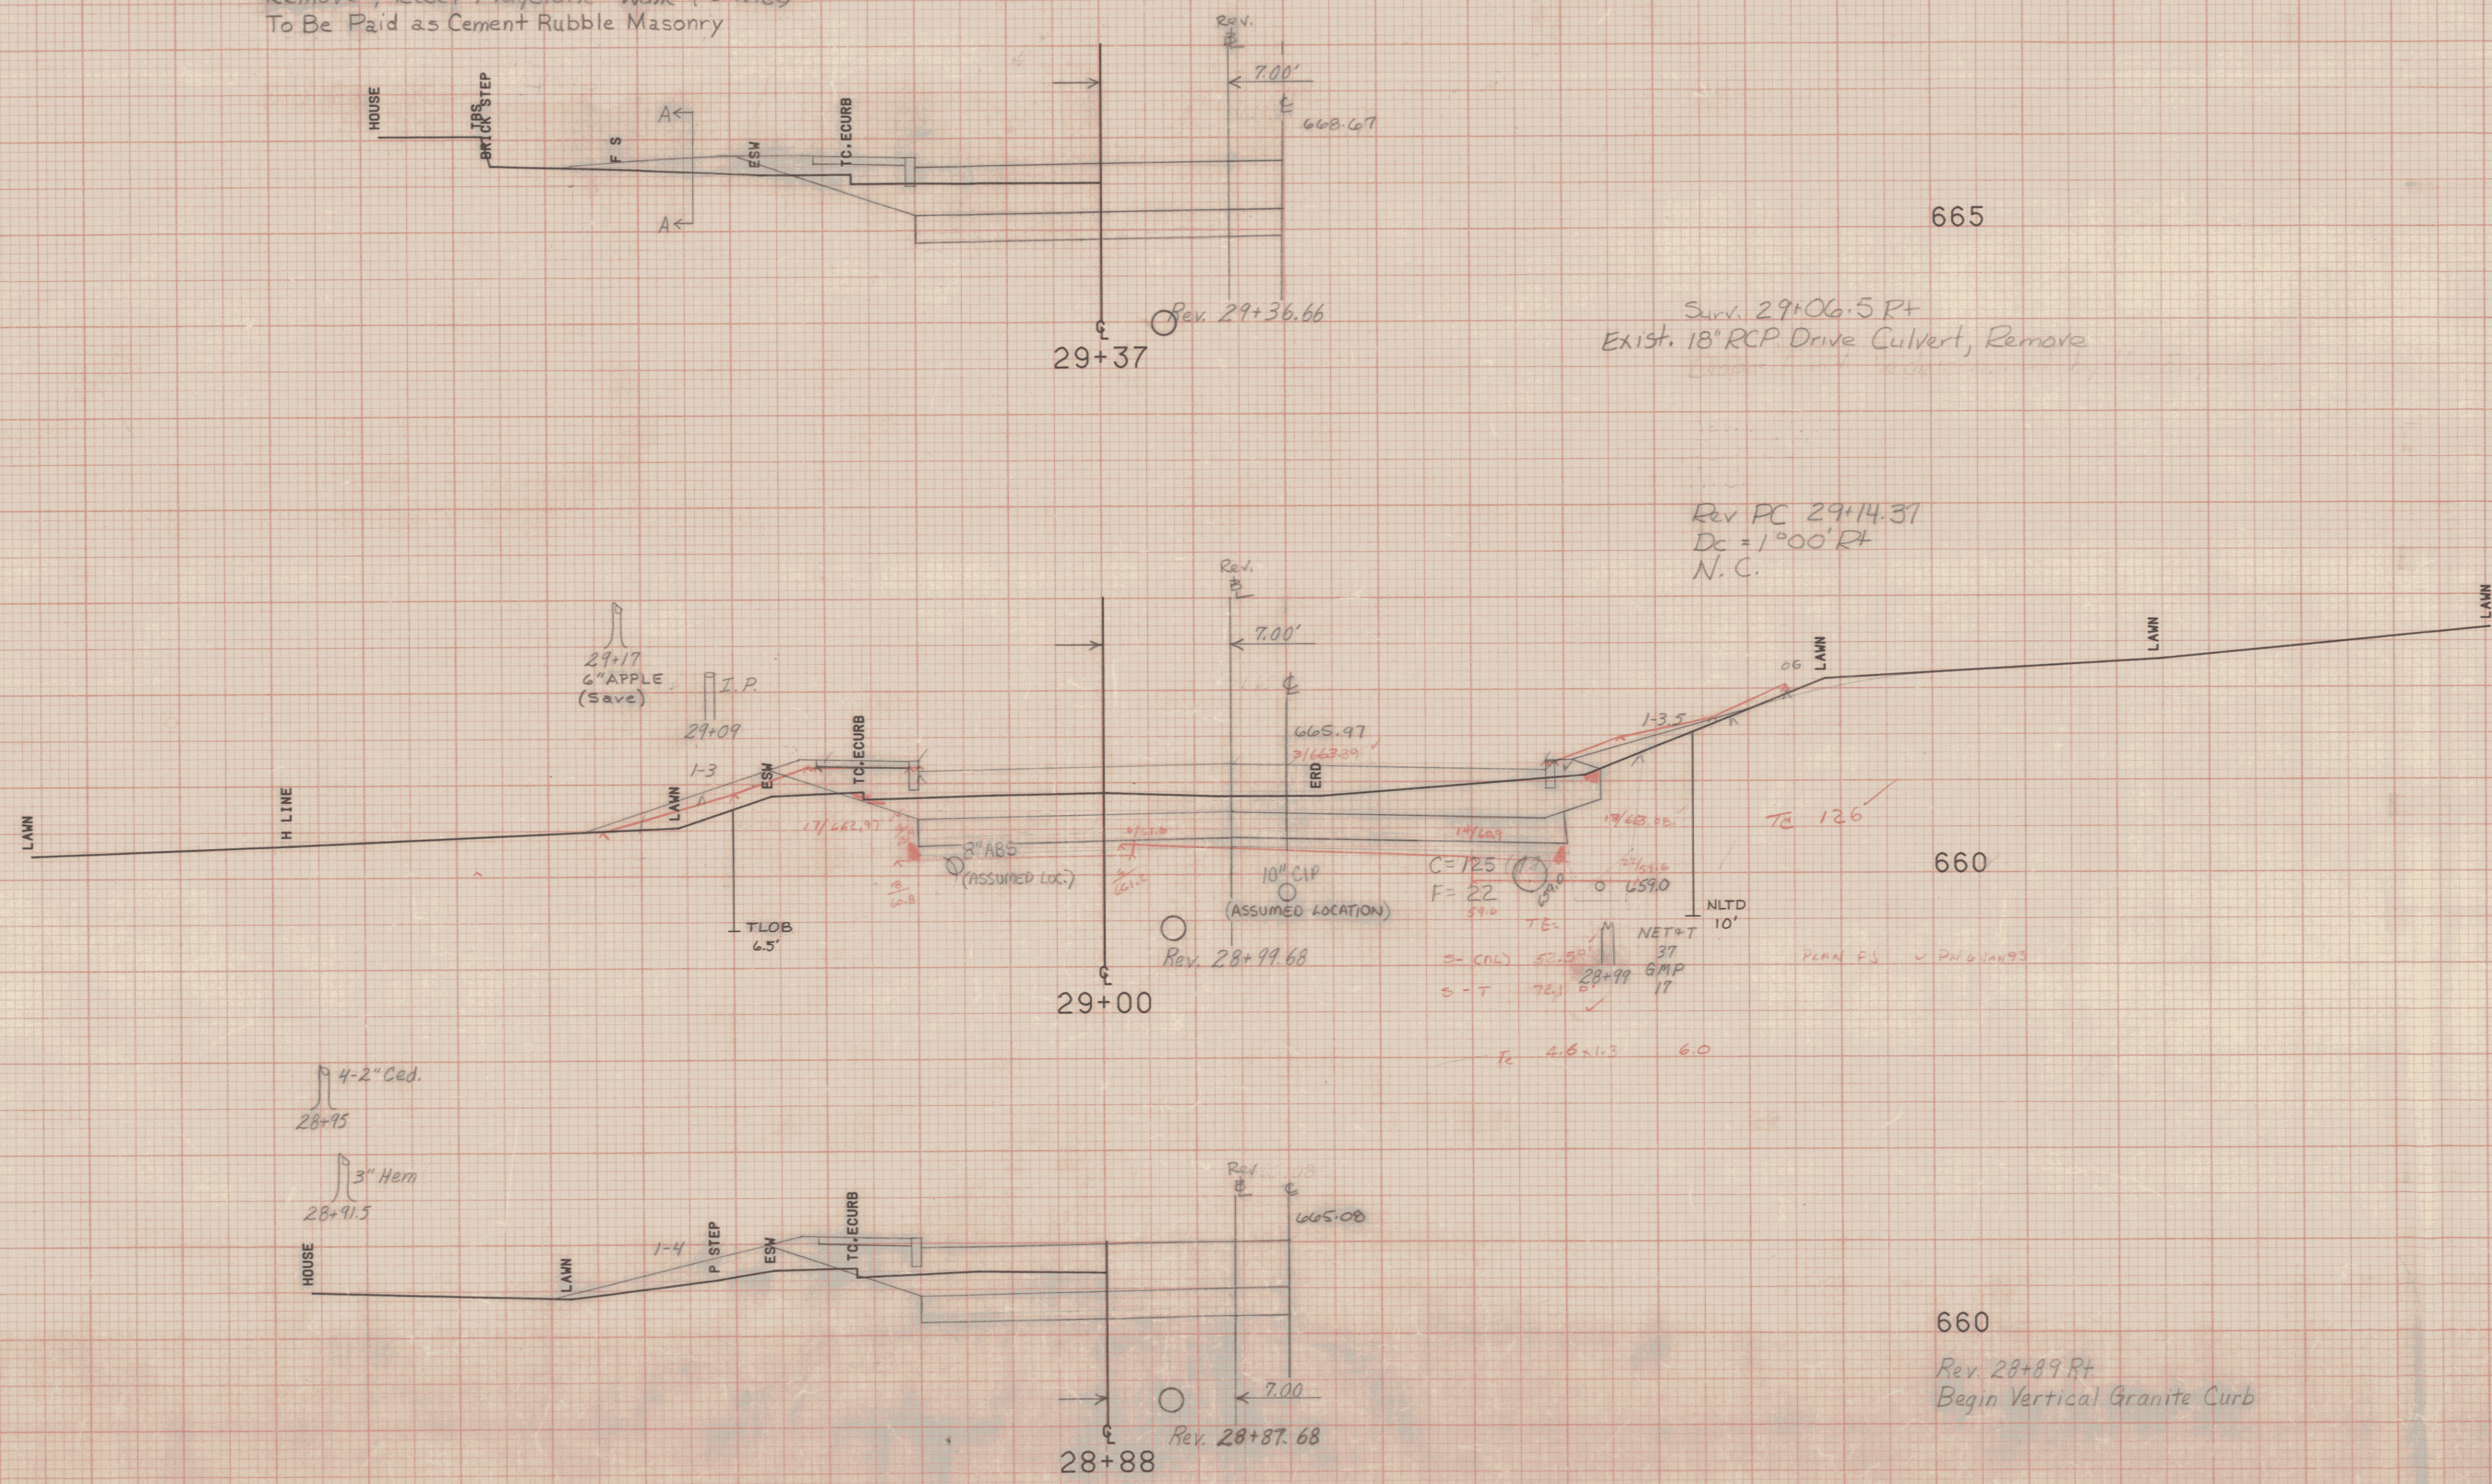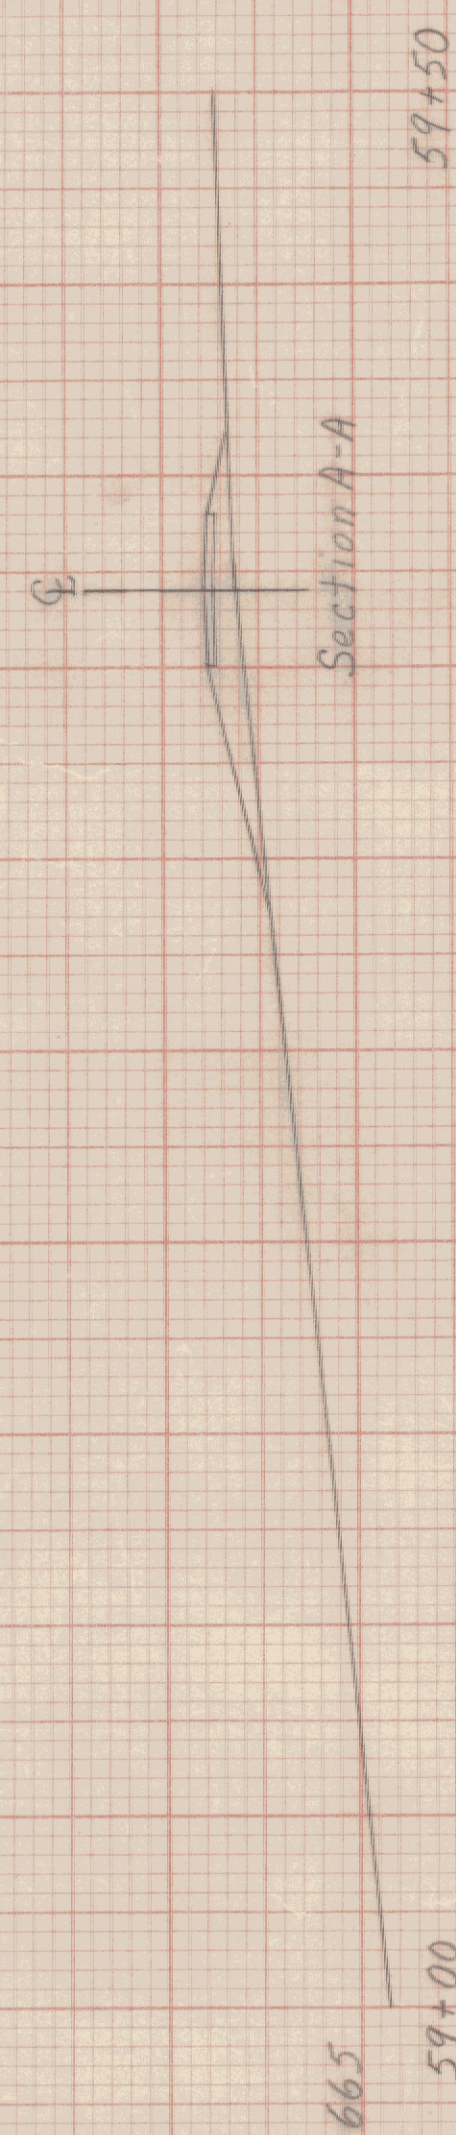

660
 Rev. 28+89 Rt
 Begin Vertical Granite Curb

Plot FT 5-273
 D1 - 7 May 14/15193
 Plan 7 May 12/103193

FROM STA. 28+88	TO STA. 29+37
PROJECT NAME MONTPELIER	
NO. M66-M6400 (7)	PLOTTED 05/04/87
SURVEYED BY KASTNER-MOREAU 06/85	
SHEET 123	OF 335 SHEETS

SCALE 5 FEET