

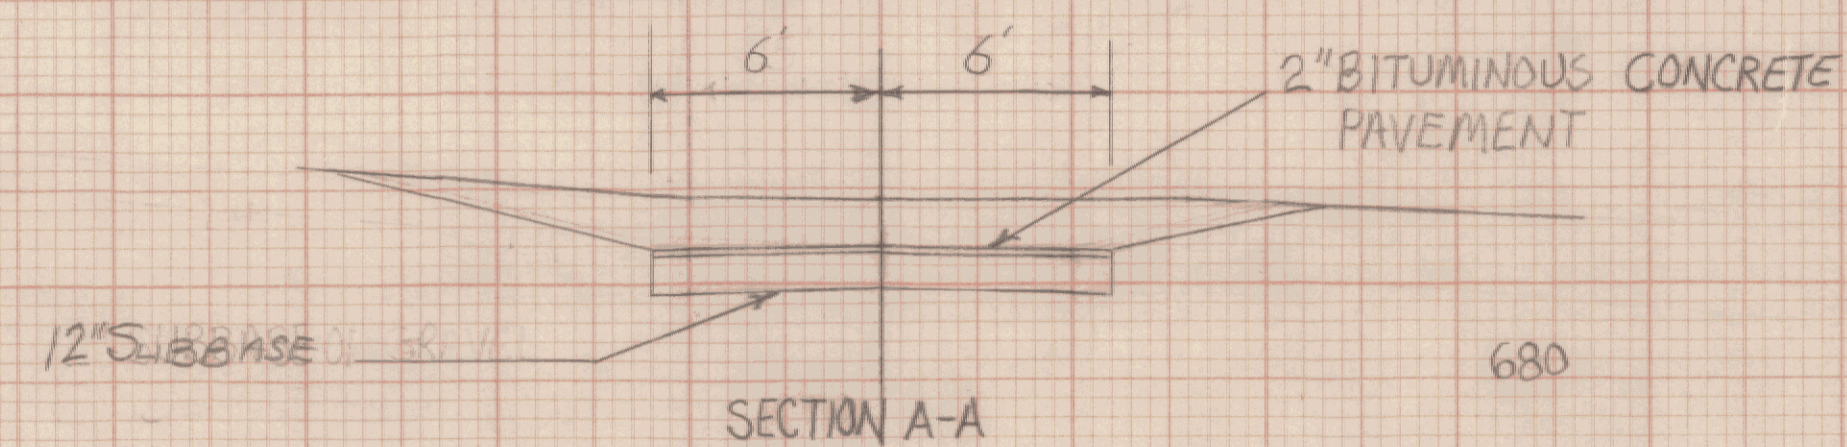


Rev. 31+15 Lt
End New 6" x 50' Underdrain
w/ F.B. @ 31+15 Lt.

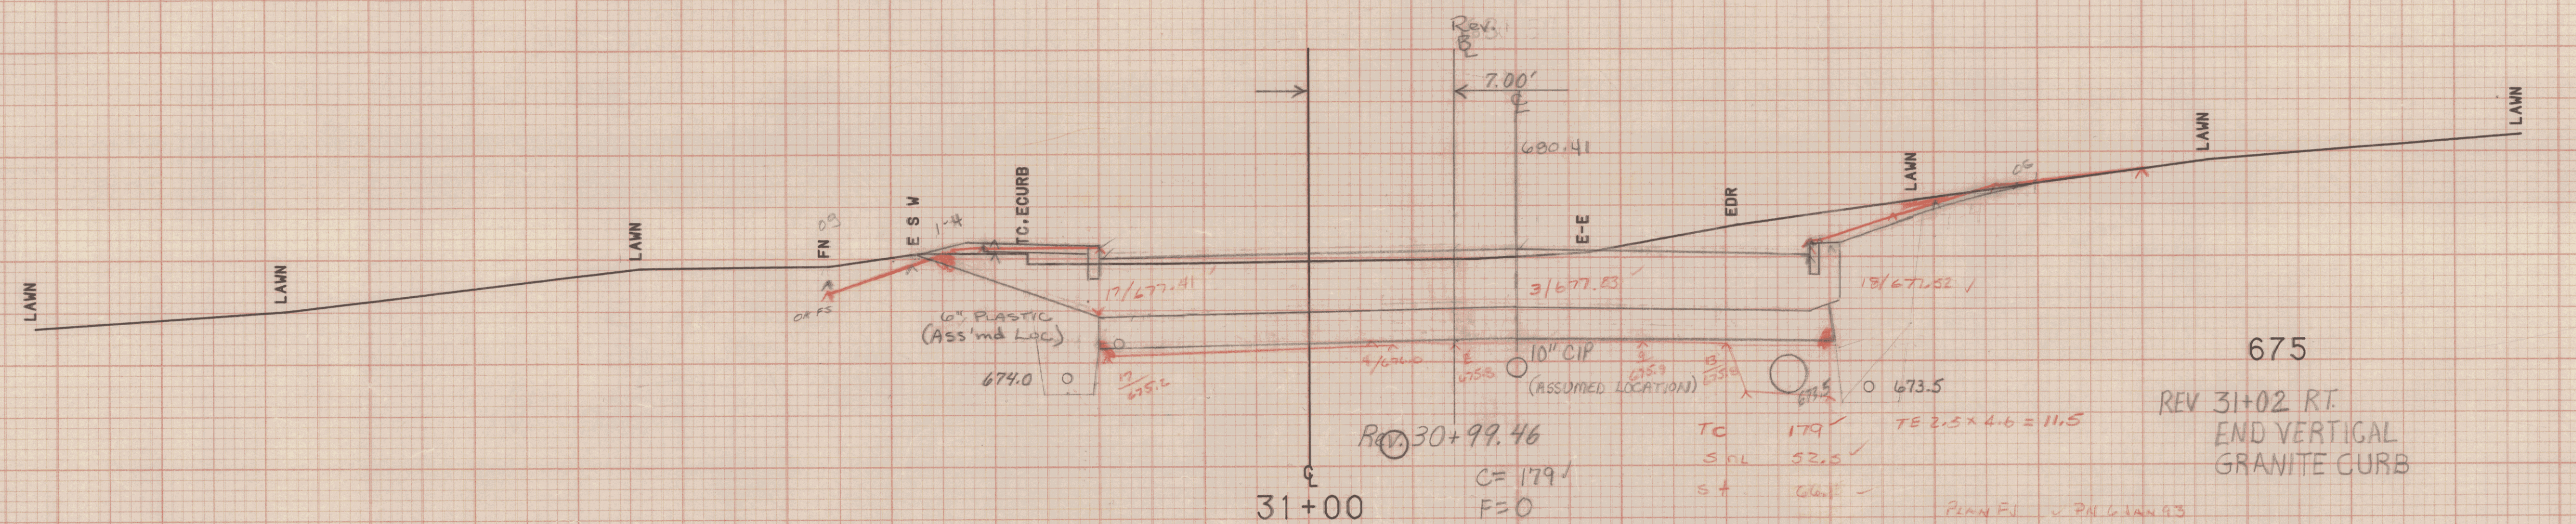


REY 31+12 RT.
BEGIN VERTICAL GRANITE CURB

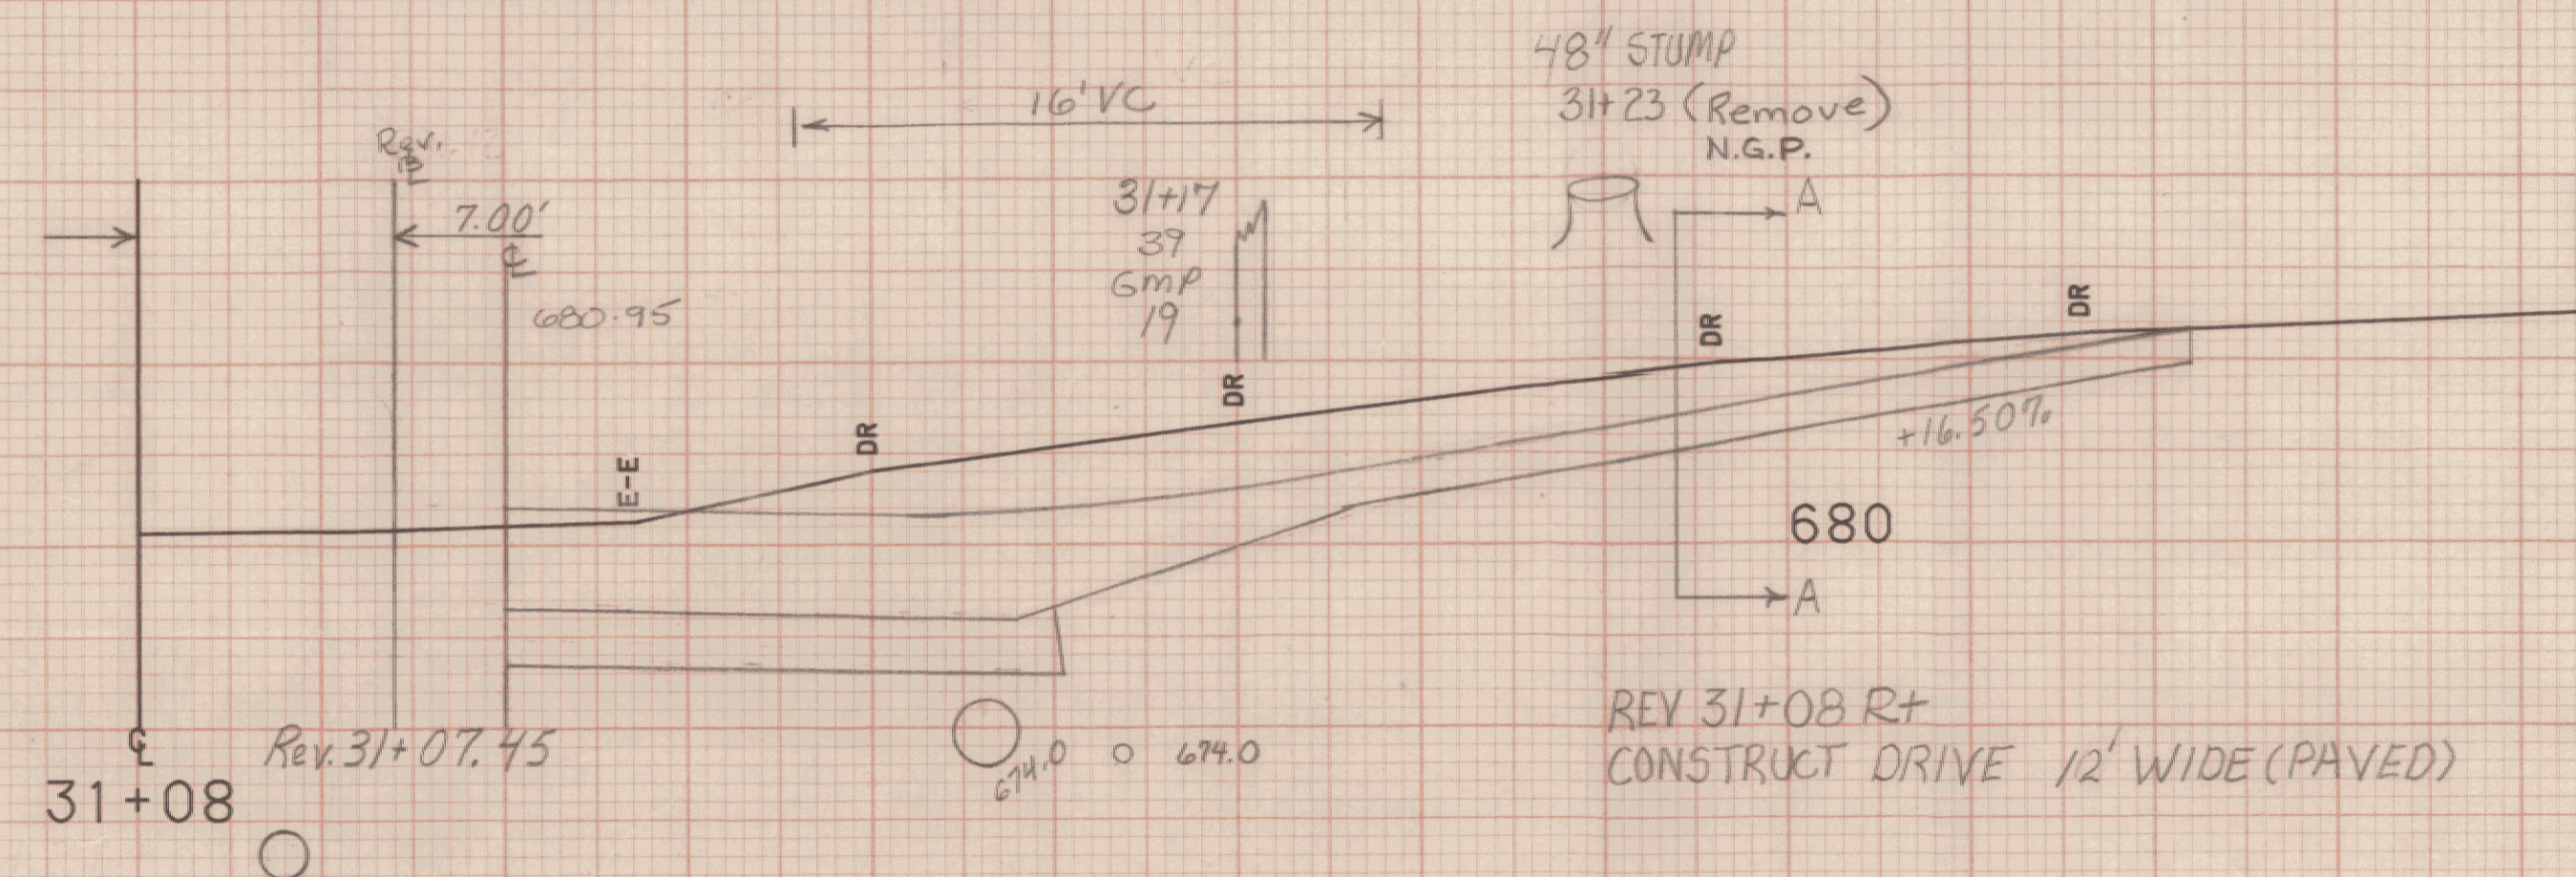

675
REV 31+02 RT.
END VERTICAL
GRANITE CURB

30+92 R+ ~ 31+17 R+
Remove Existing 15" RCP
And 2-5'x1' Granite Headwalls

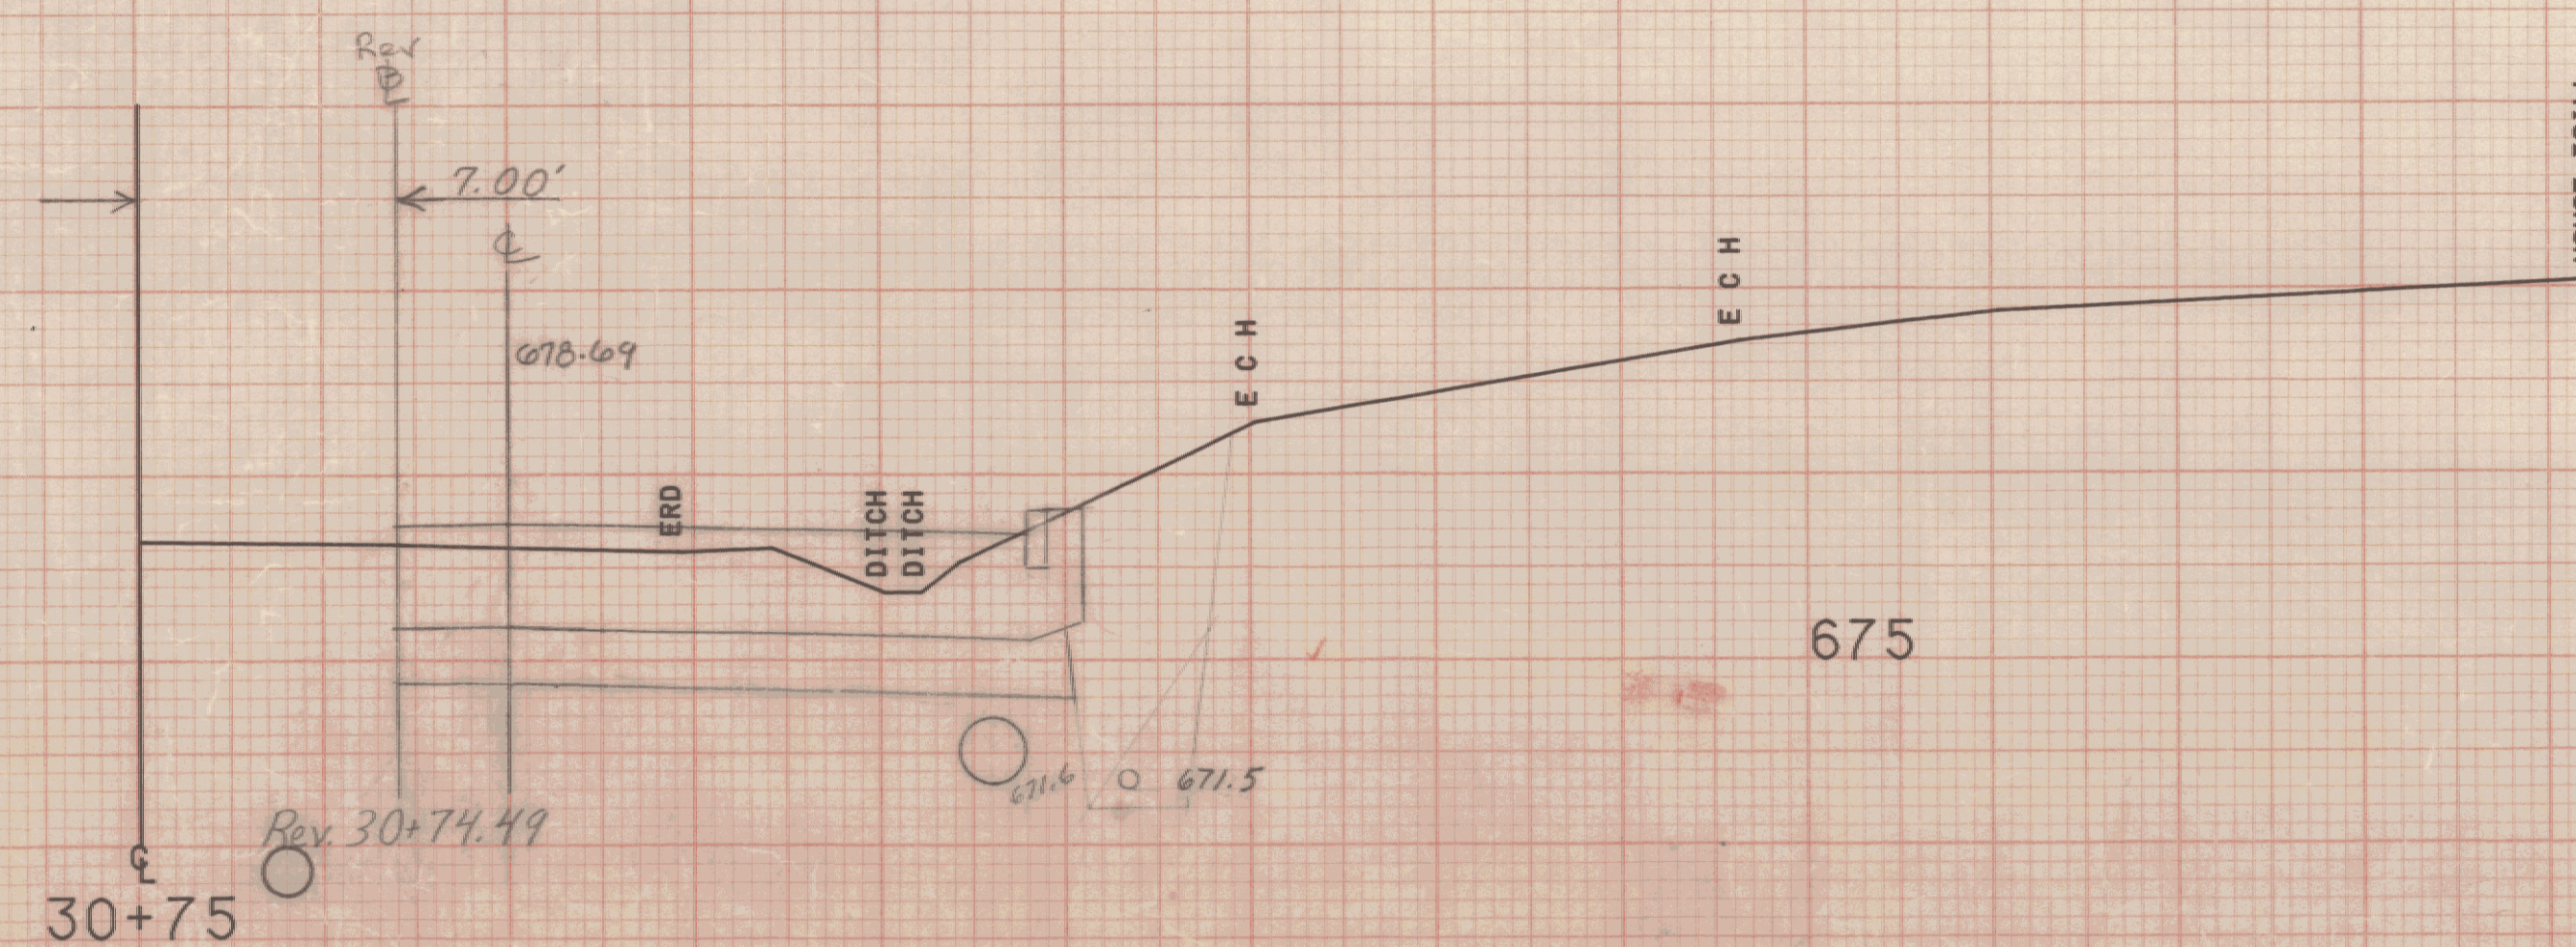

Plot gms 11/15/93
✓ Plan gms 12/03/93

FROM STA. 30+75 TO STA. 31+08
PROJECT NAME MONTPELIER
NO. ~~MEC~~ M6400 (7) PLOTTED 05/04/87
SURVEYED BY KASTNER-MOREAU 06/85
SHEET 180 OF 335 SHEETS