

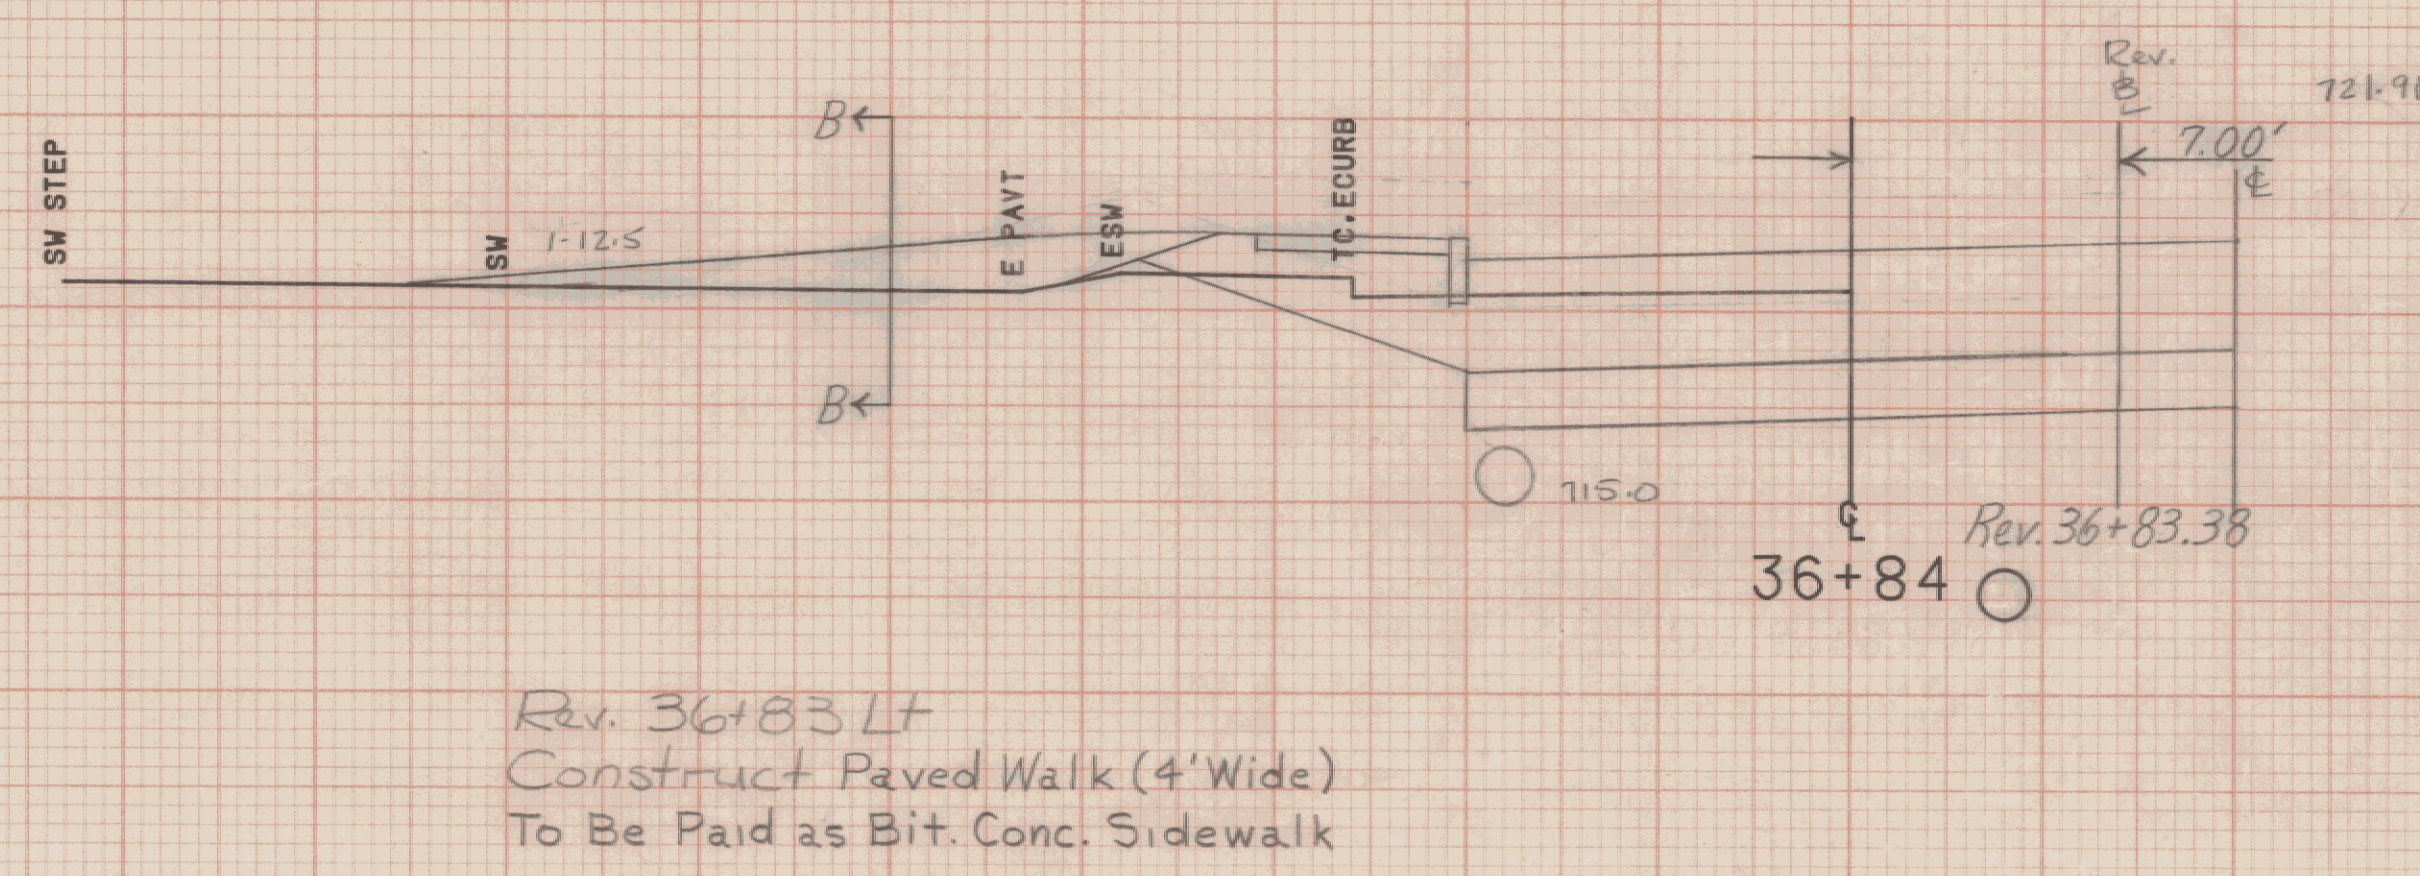
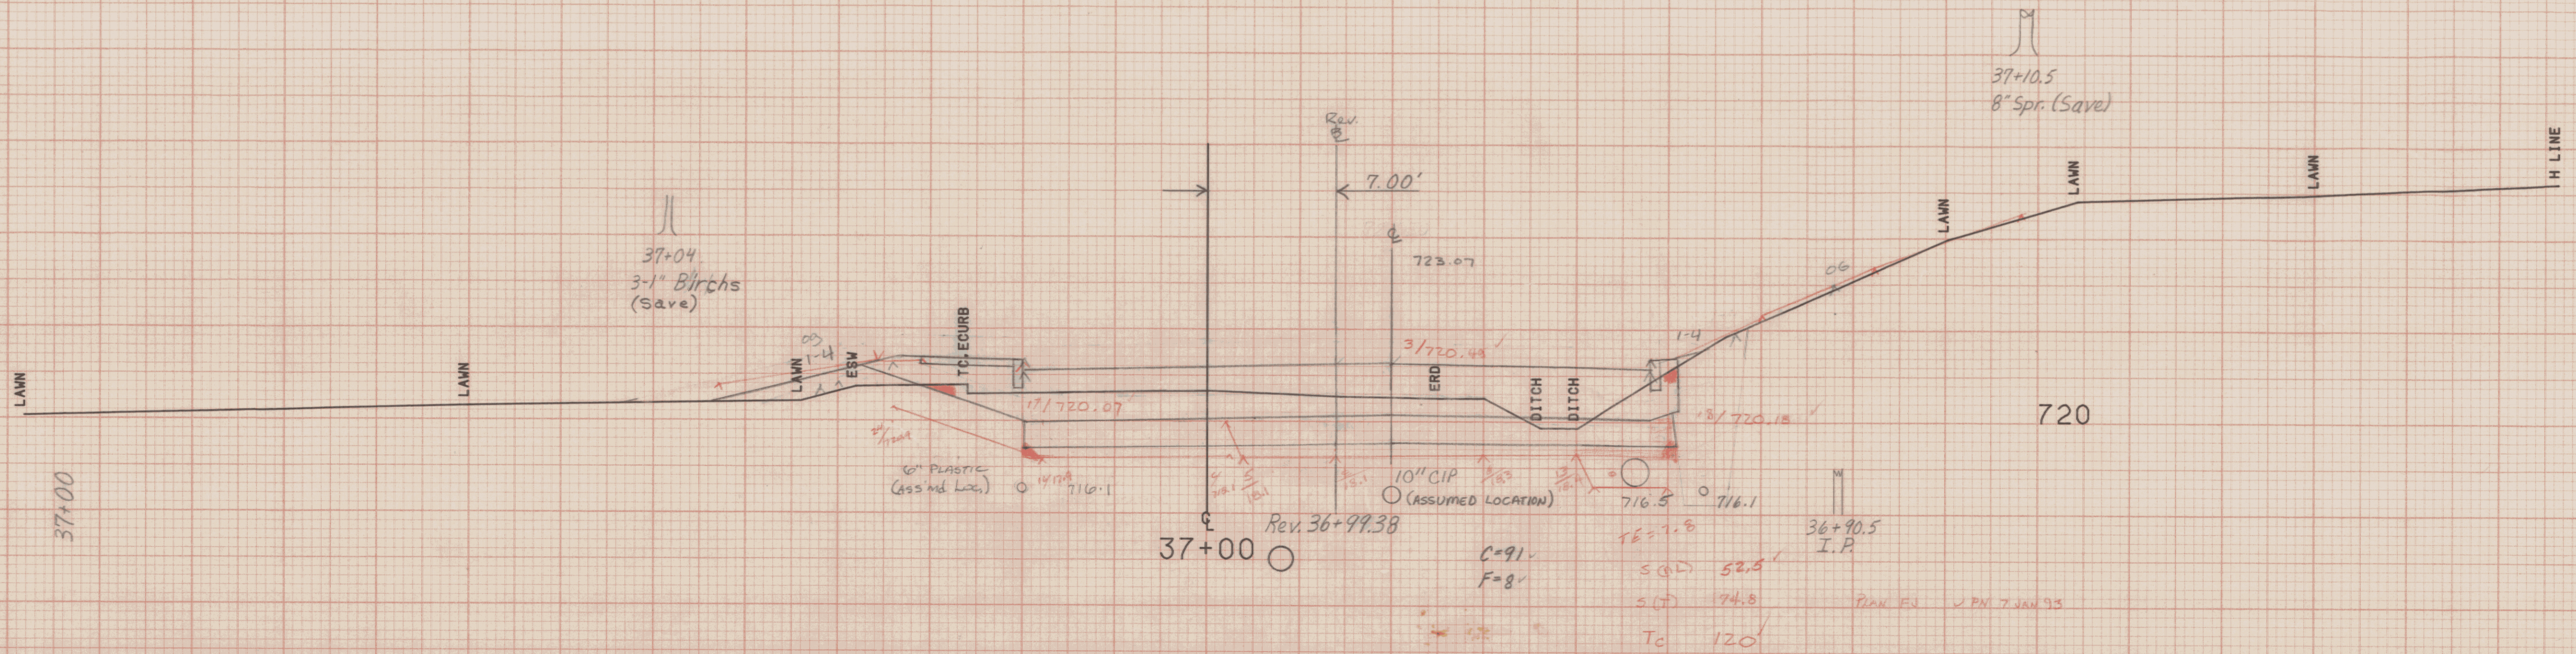


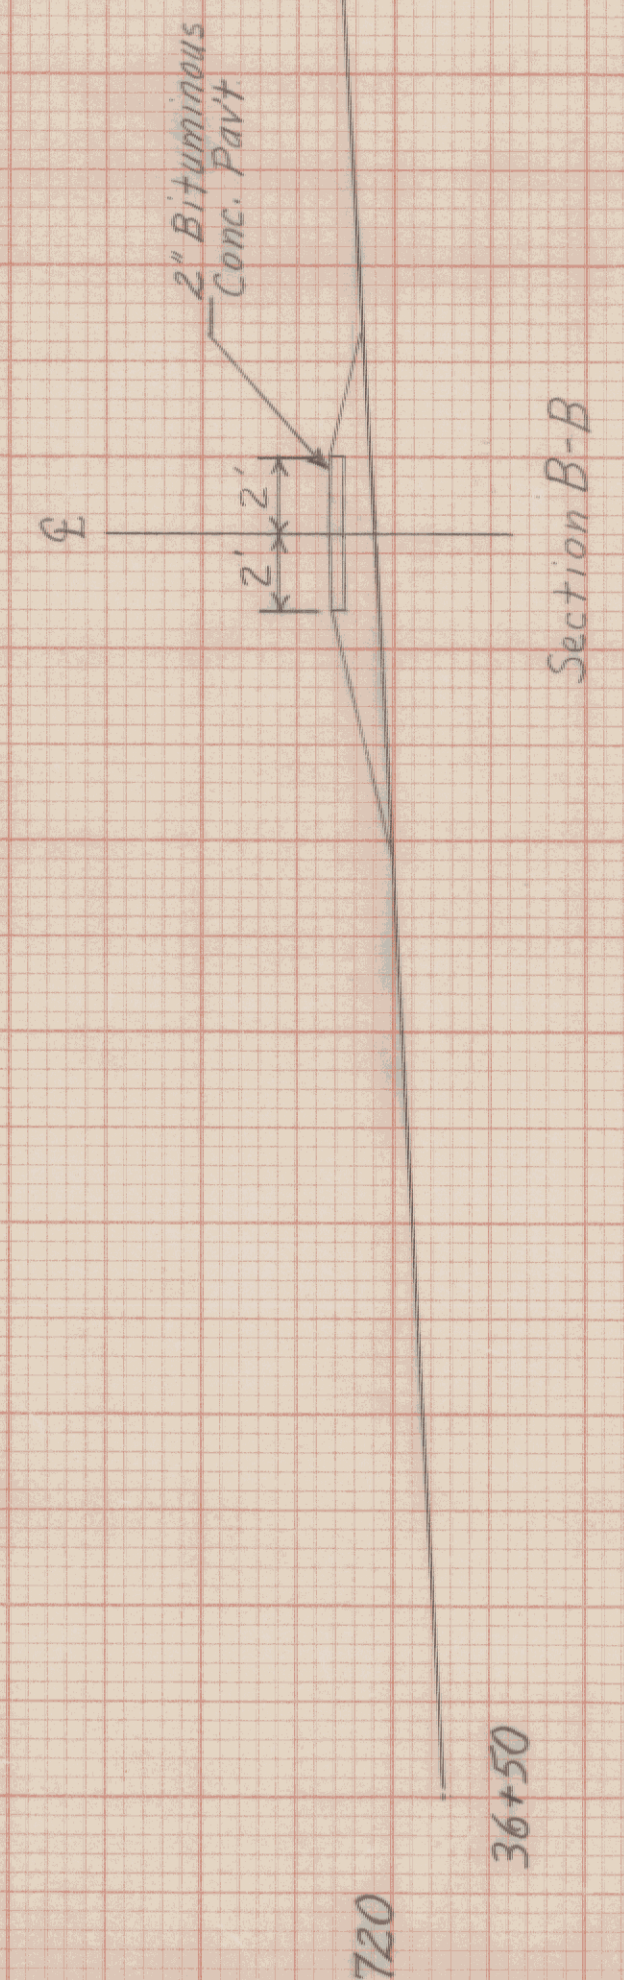

Rev. 36+83 Lt
Construct Paved Walk (4' Wide)
To Be Paid as Bit. Conc. Sidewalk

Rev. 36+70 Lt
End New 6" x 50' Underdrain w/ F.B. @ 36+70 Lt.

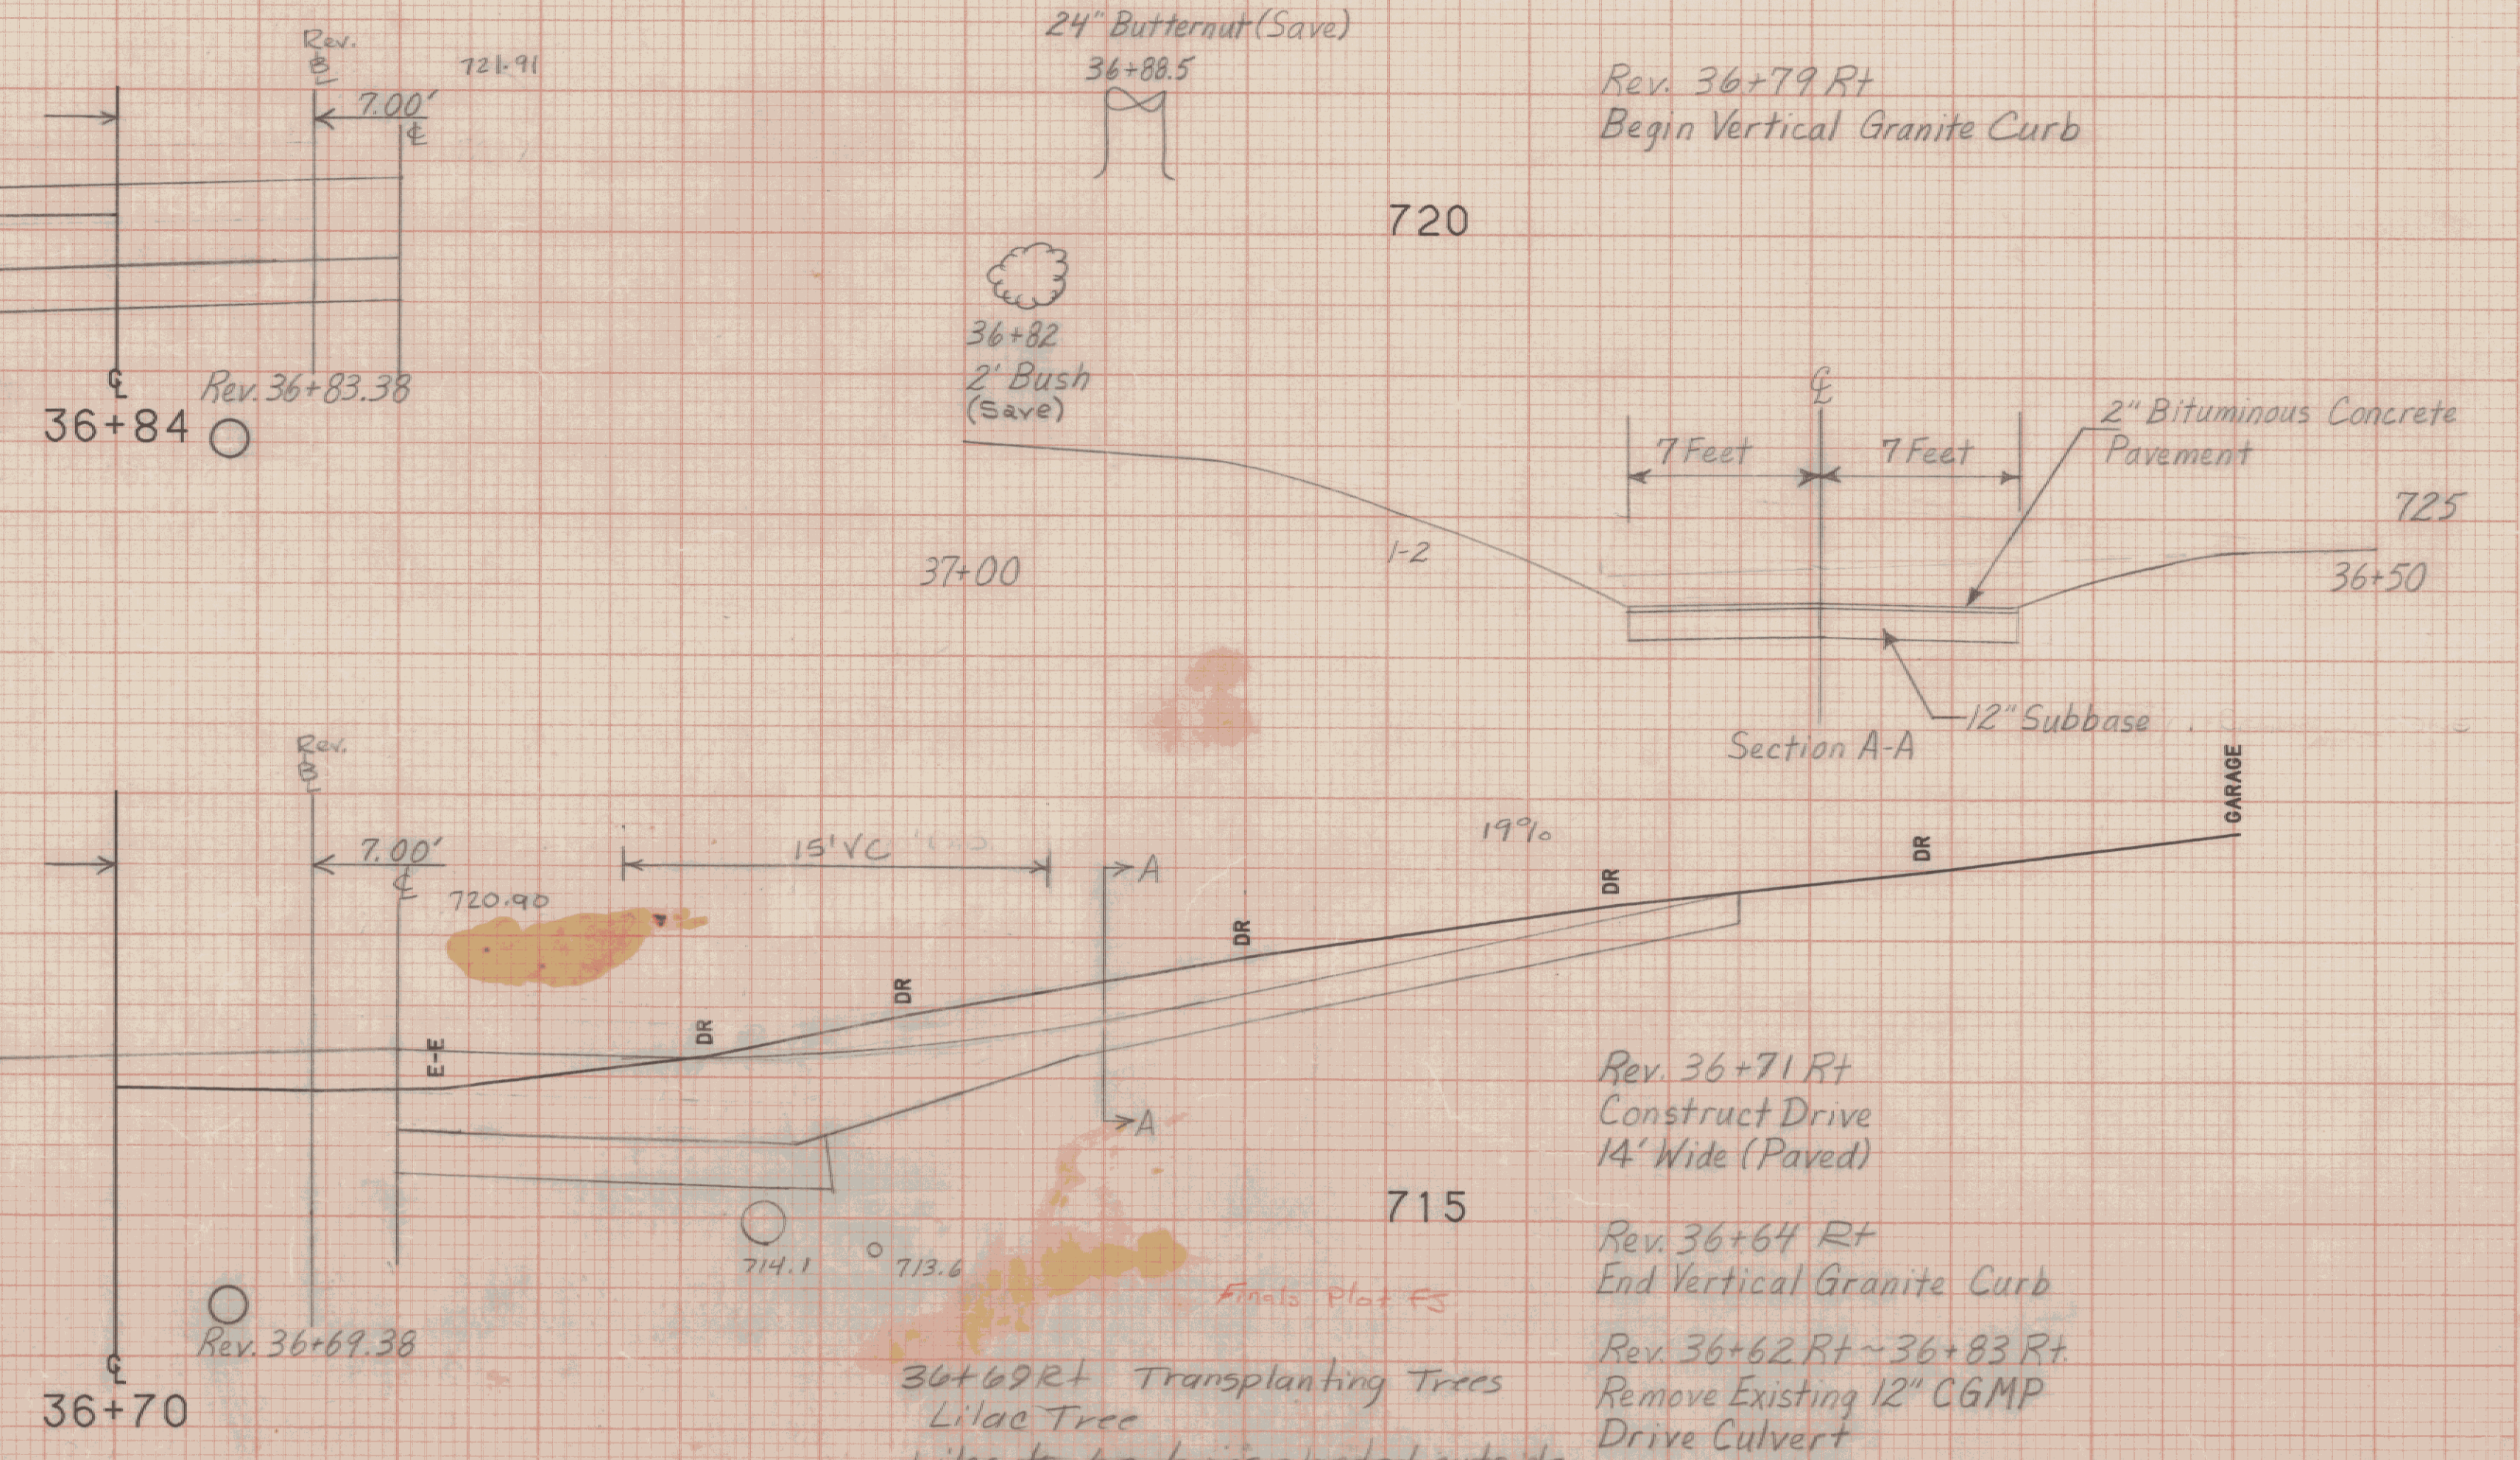

Rev. 36+79 Rt
Begin Vertical Granite Curb

Rev. 36+71 Rt
Construct Drive
14' Wide (Paved)

Rev. 36+64 Rt
End Vertical Granite Curb

Rev. 36+62 Rt ~ 36+83 Rt
Remove Existing 12" CGMP
Drive Culvert

36+69 Rt Transplanting Trees
Lilac Tree
Lilac to be transplanted outside
of the R.O.W. Limit in a location
which is mutually agreeable with the
property owner and resident engineer.

FROM STA.	36+70	TO STA.	37+00
PROJECT NAME	MONTPELIER		
NO.	M660	M6400 (7)	
SURVEYED BY	KASTNER-MOREAU 06/85		
		PLOTTED	05/04/87