


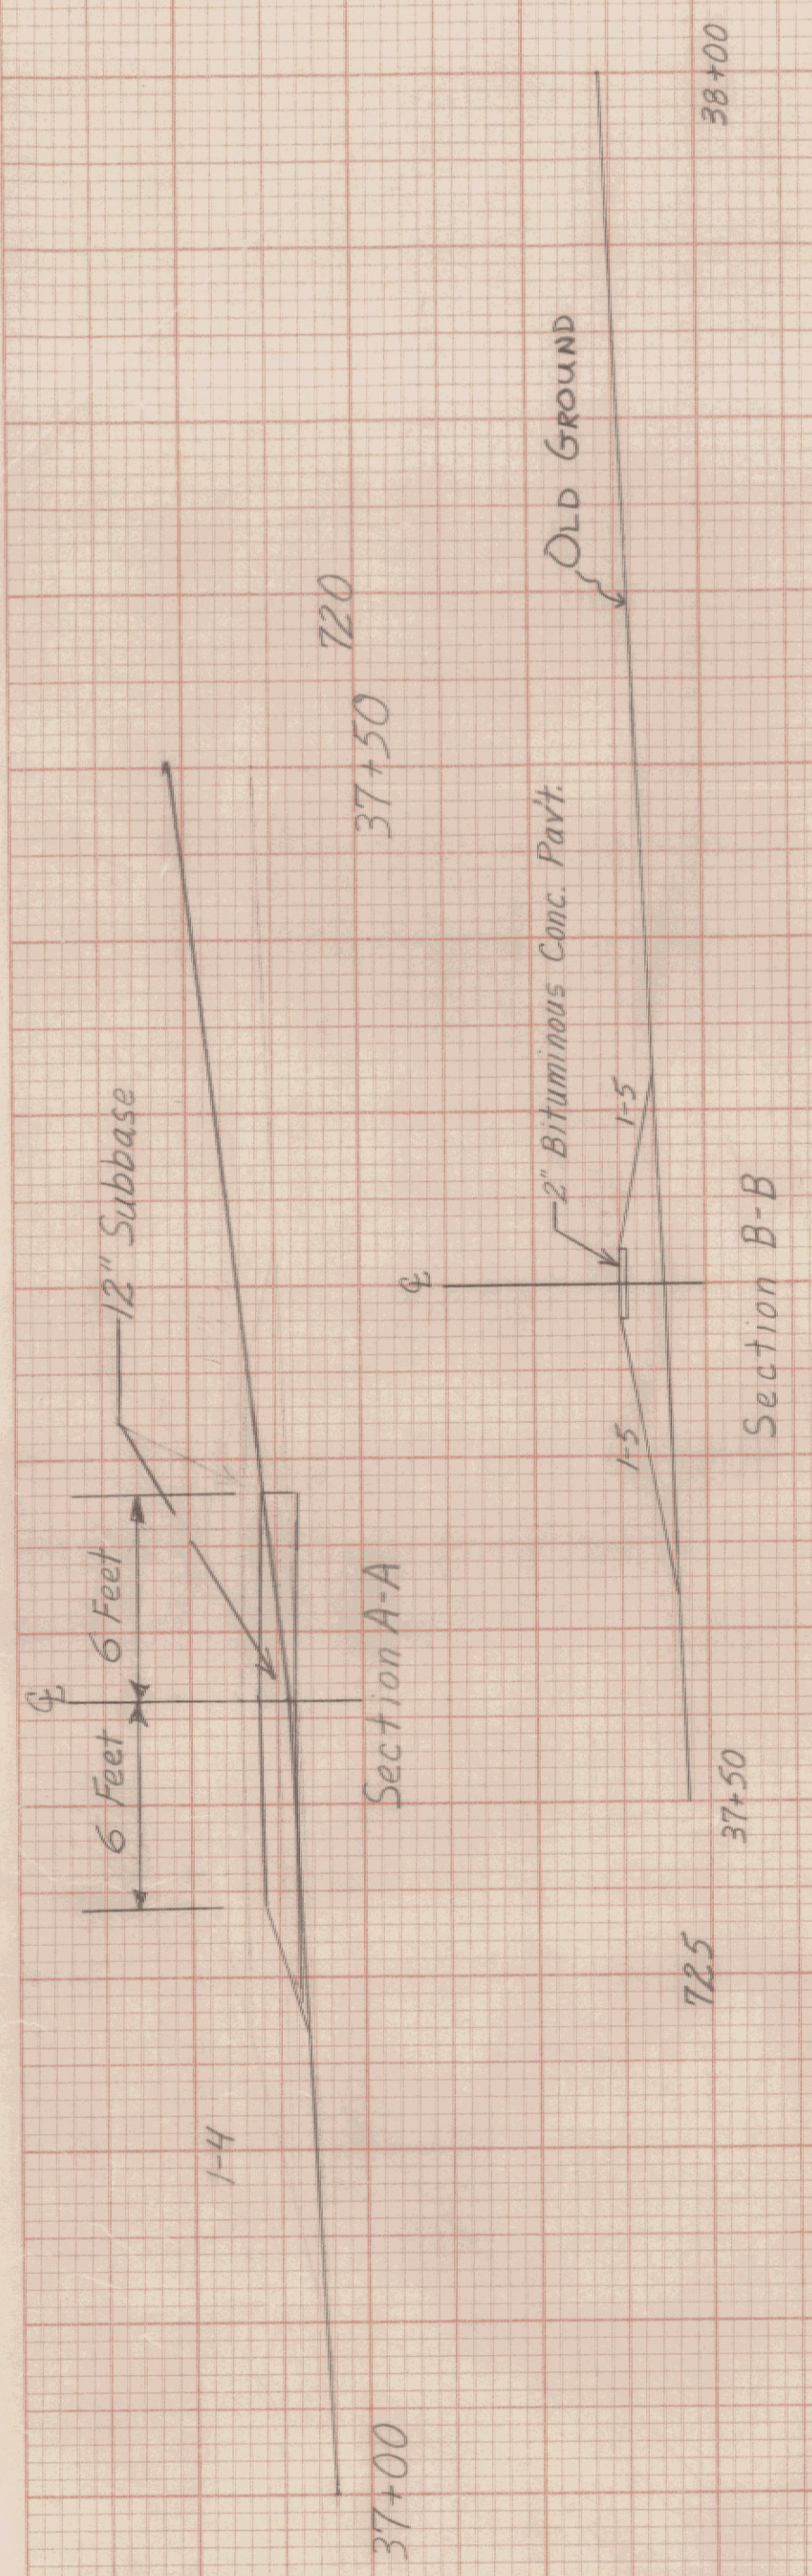

Rev. 37+65 Lt.
Construct Paved Walk (2' Wide)
To Be Paid as Bit. Conc. Sidewalk

HOUSE
P.W. STEP

1-12.5

TO E.CURB

720.9

Rev. 37+64.38

37+65

7.00' 727.79

725

Rev. 37+60 Rt.
End 6" Underdrain Carrier Pipe
Begin New 6"x330' Underdrain
w/ Flushing Basin @ 40+90 Rt

Rev. 37+60 Rt ~ 37+89 Rt
Remove Existing 12" CGMP
Drive Culvert

