


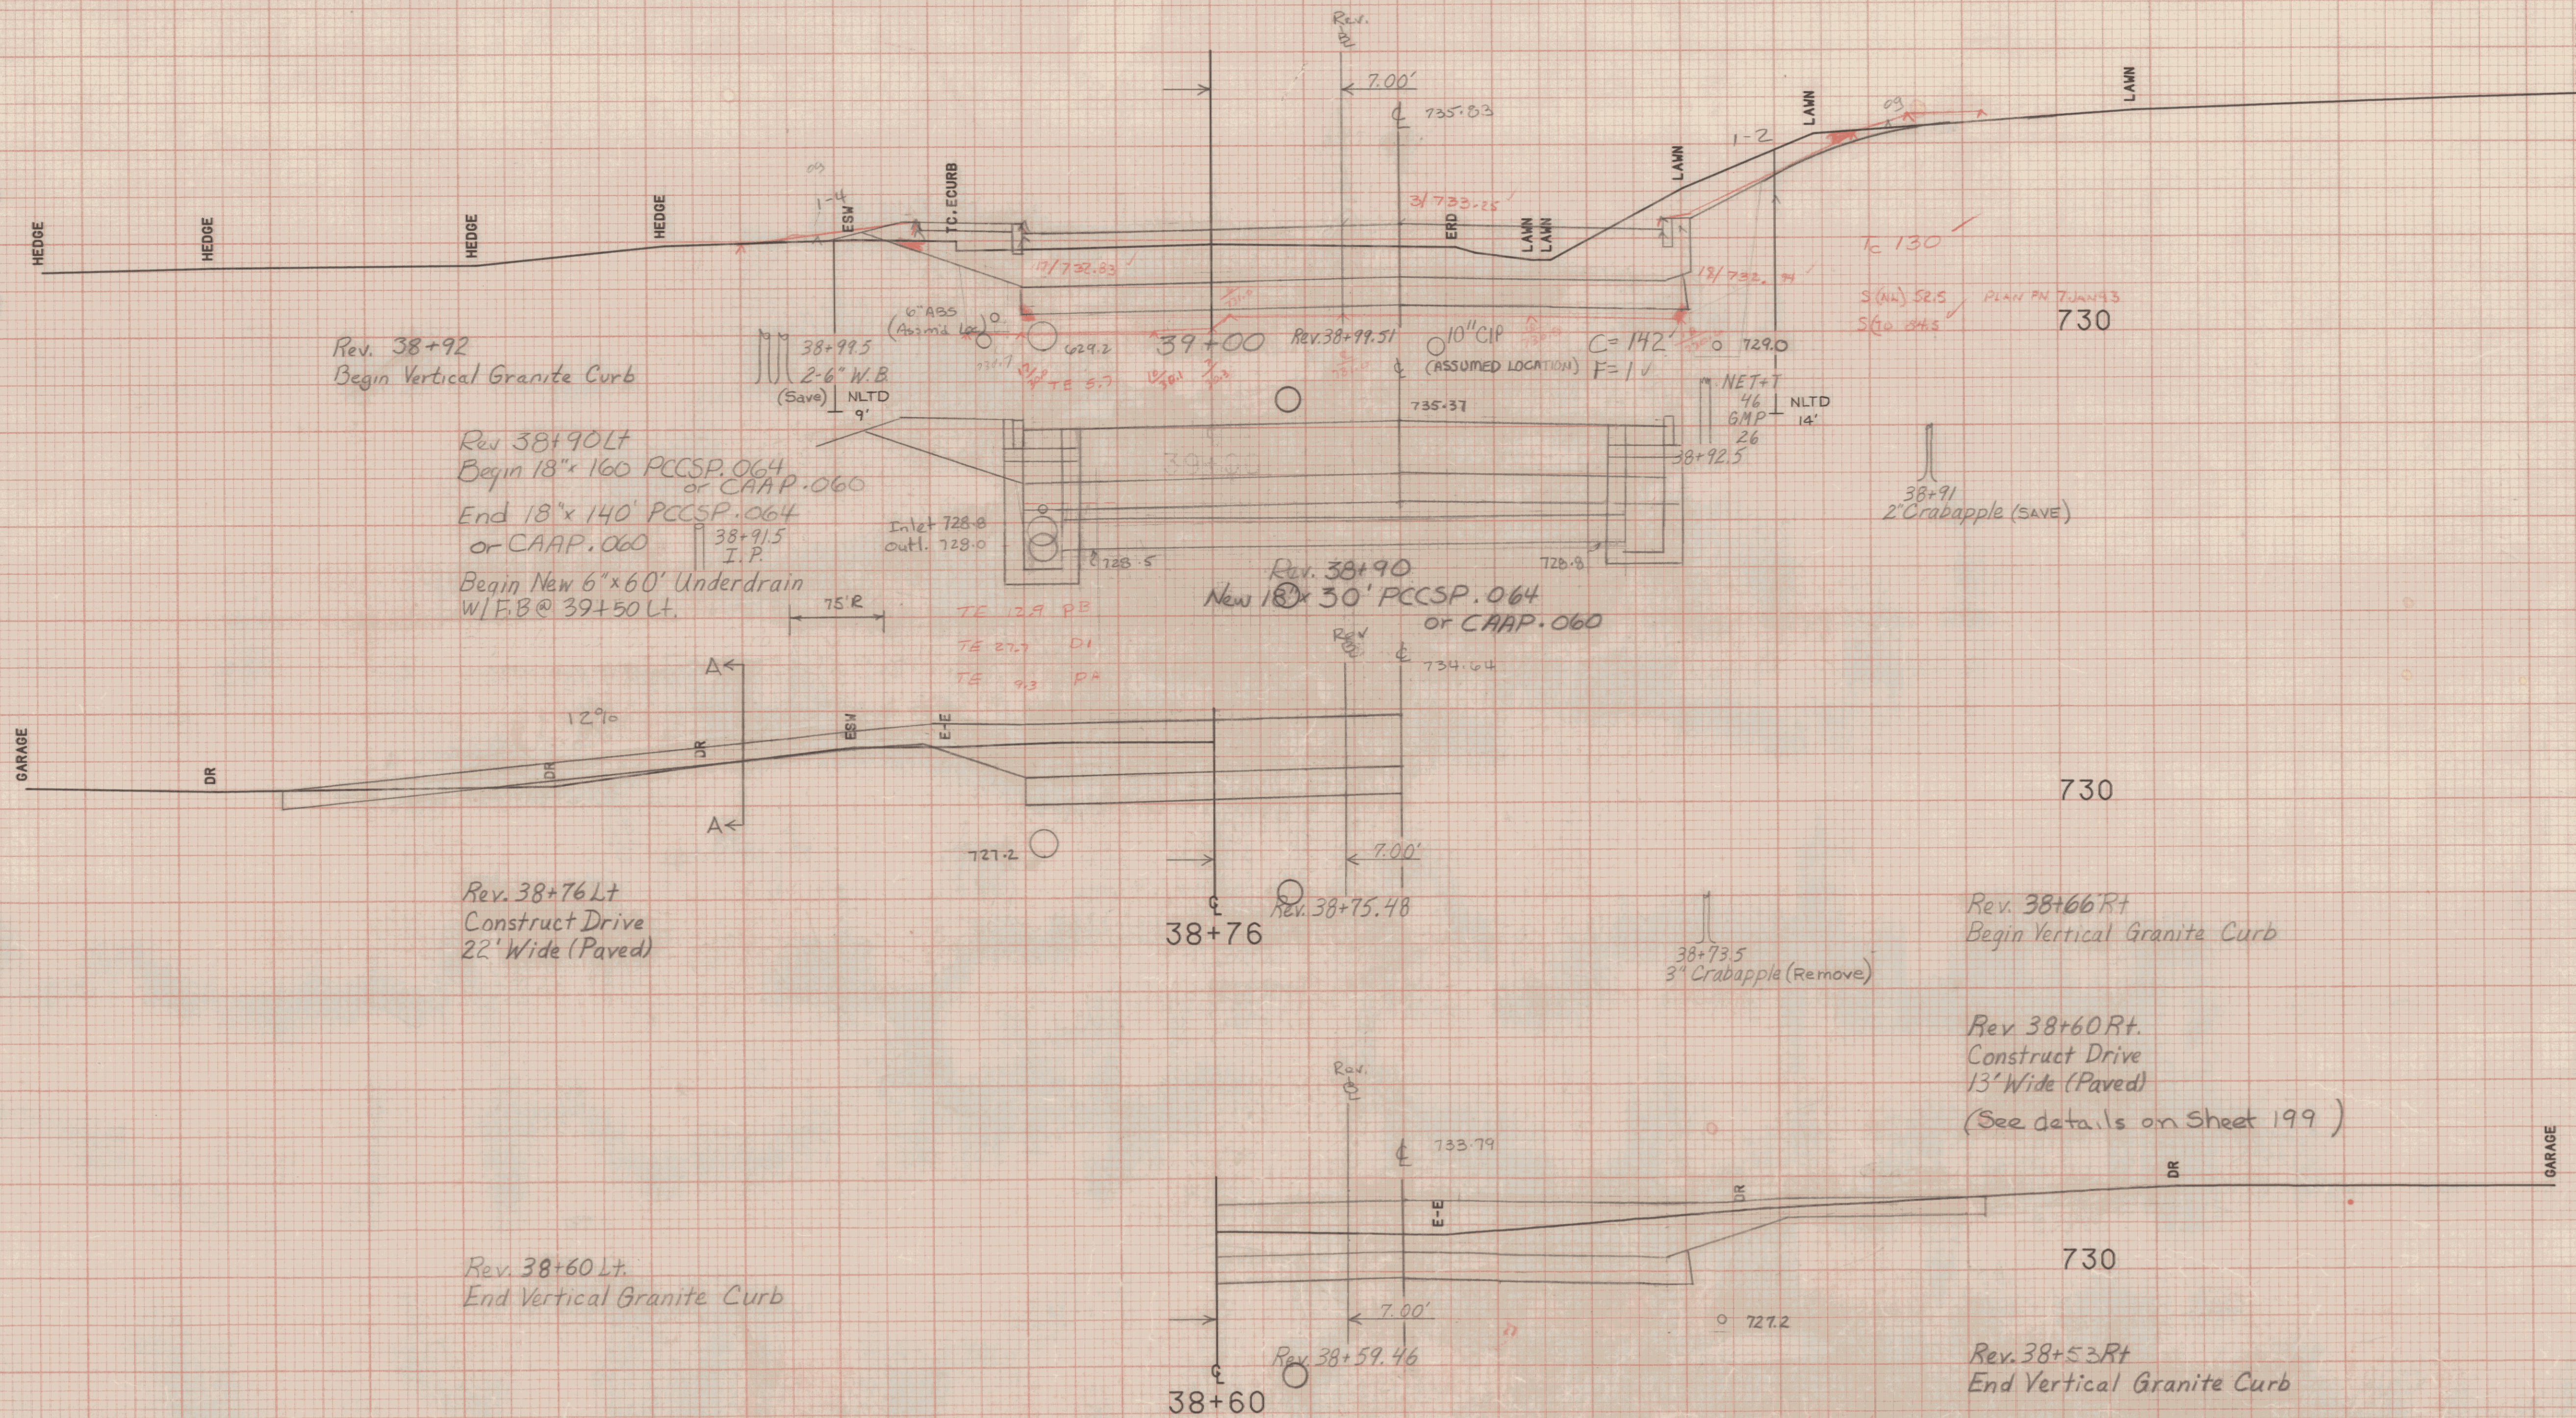

Finals Plot FJ
Plot FJ
✓ Plan g May 12/06/93

FROM STA. 38+60 TO STA. 39+00
PROJECT NAME MONTPELIER
NO. MEGC M6400 (7) PLOTTED 05/04/87
SURVEYED BY KASTNER-MOREAU 06/85
SHEET 198 OF 335 SHEETS