


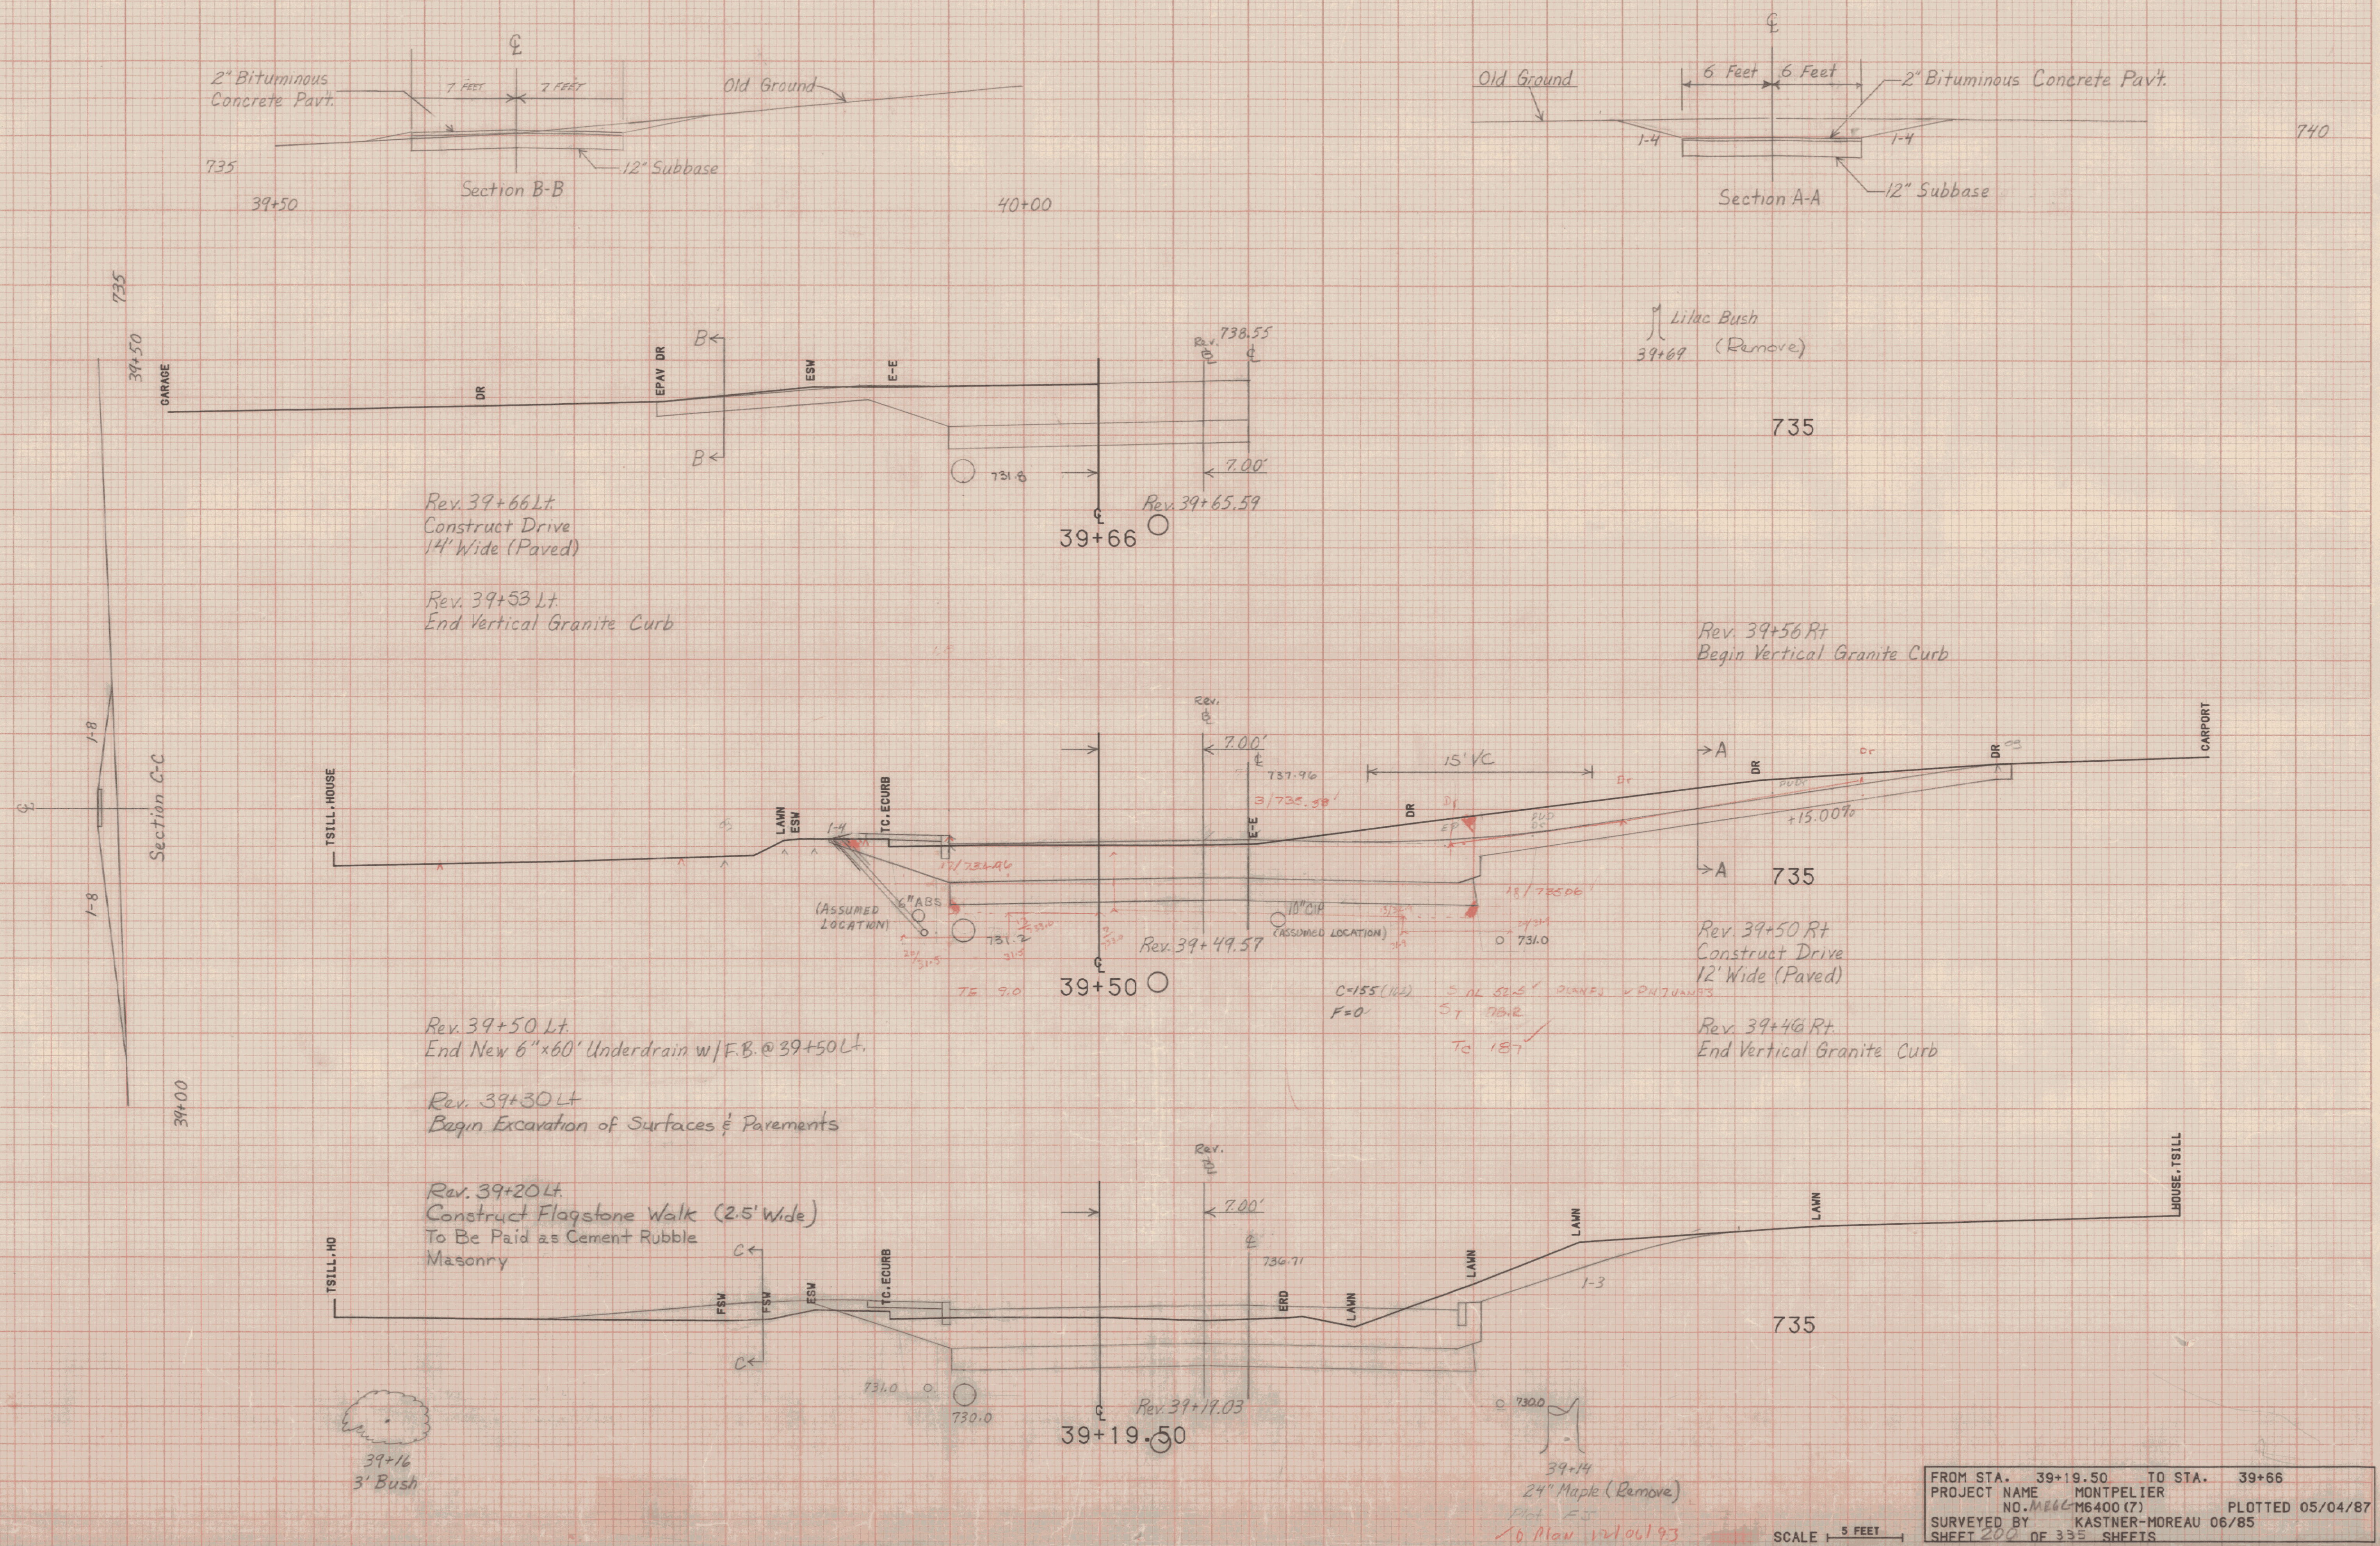

FROM STA. 39+19.50 TO STA. 39+66
PROJECT NAME MONTPELIER
NO. ~~M66~~ M6400 (7) PLOTTED 05/04/87
SURVEYED BY KASTNER-MOREAU 06/85
SHEET ~~200~~ OF 335 SHEETS