
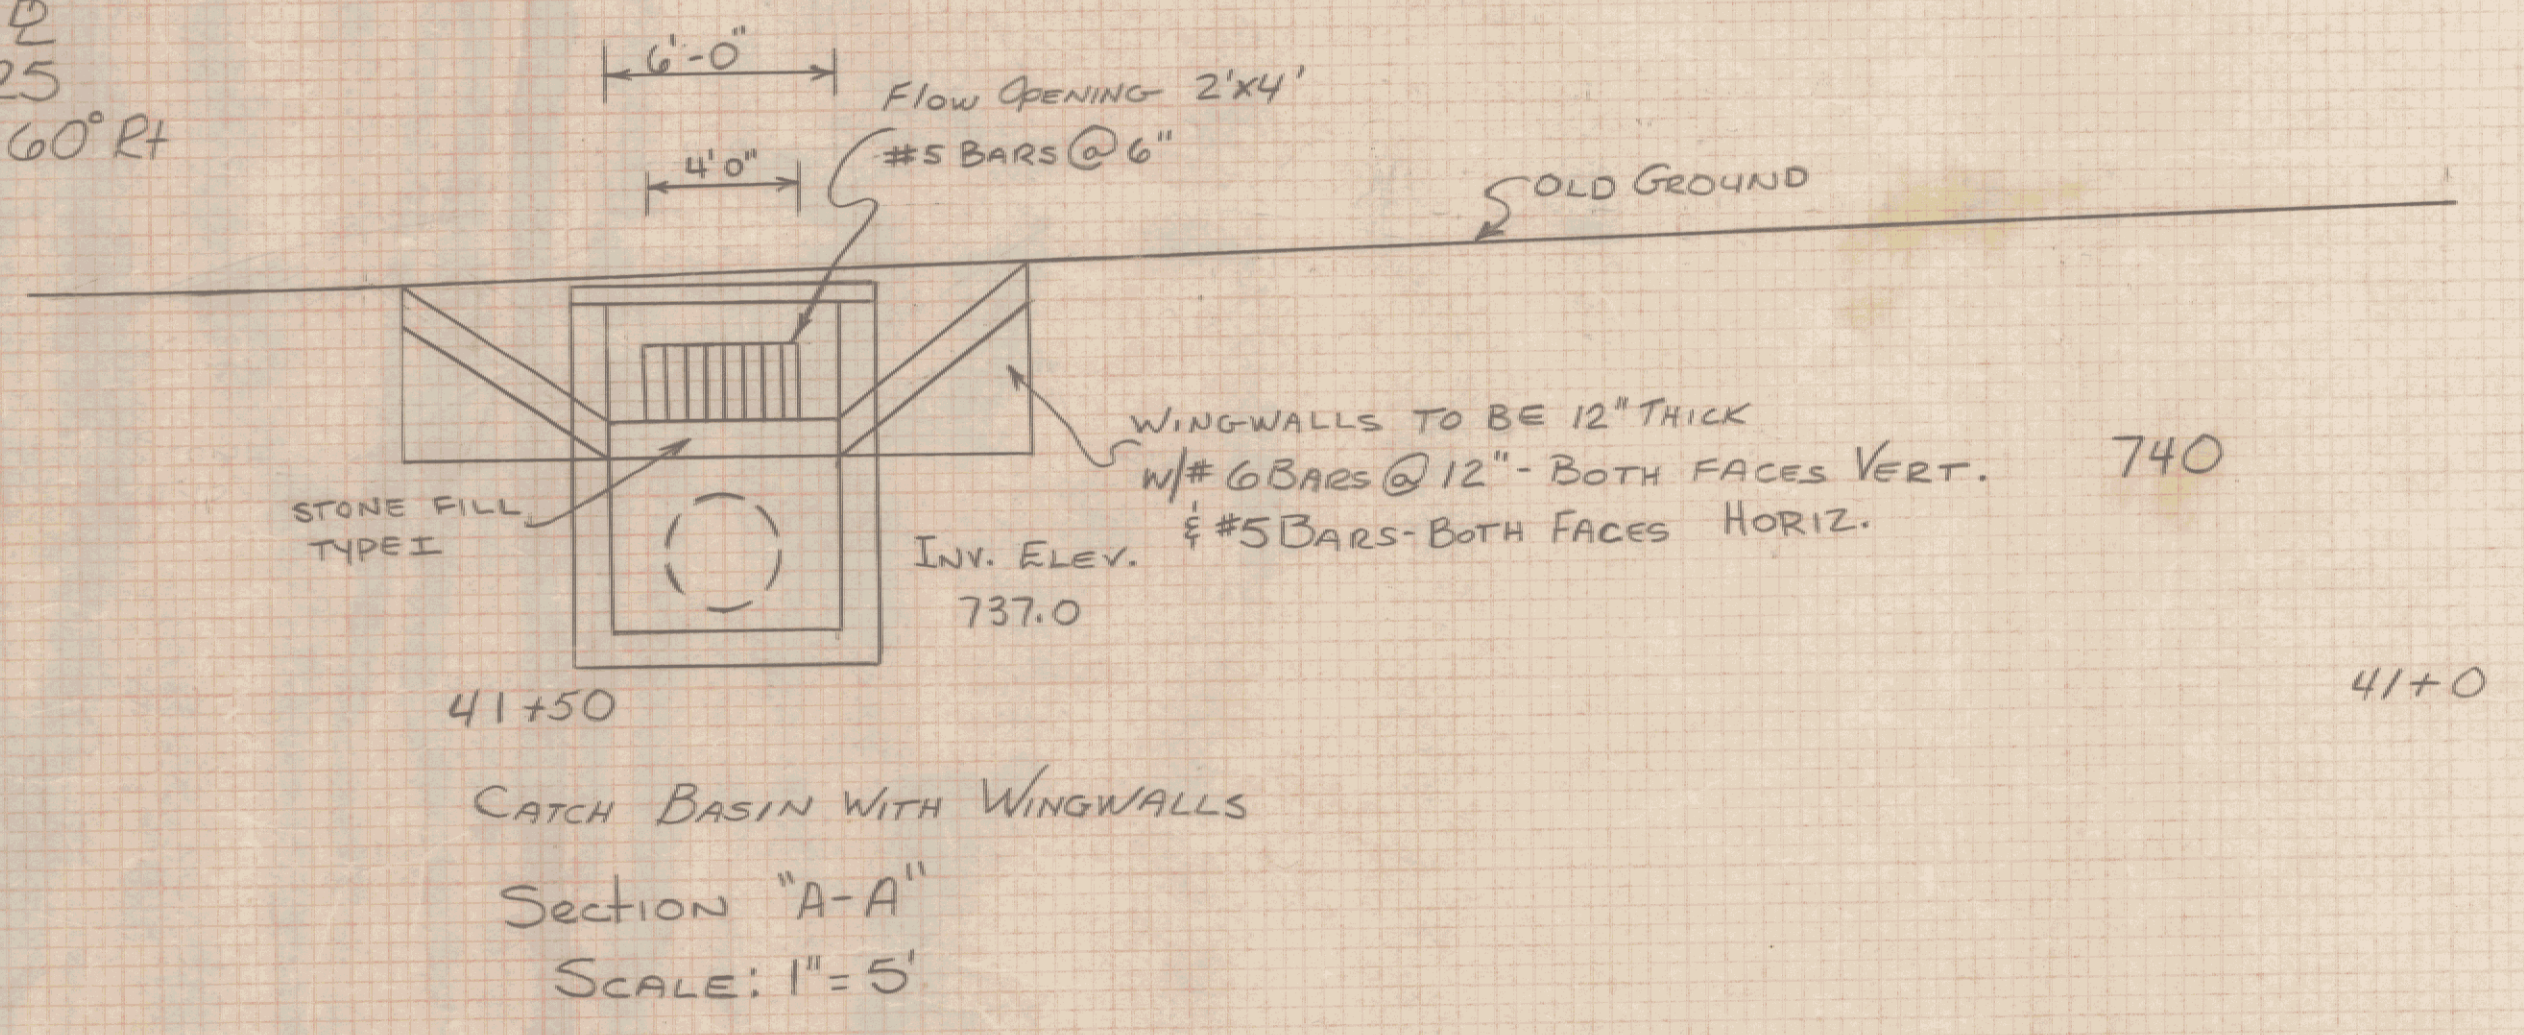


Rev 4
41+25
AsKew 60° Rt

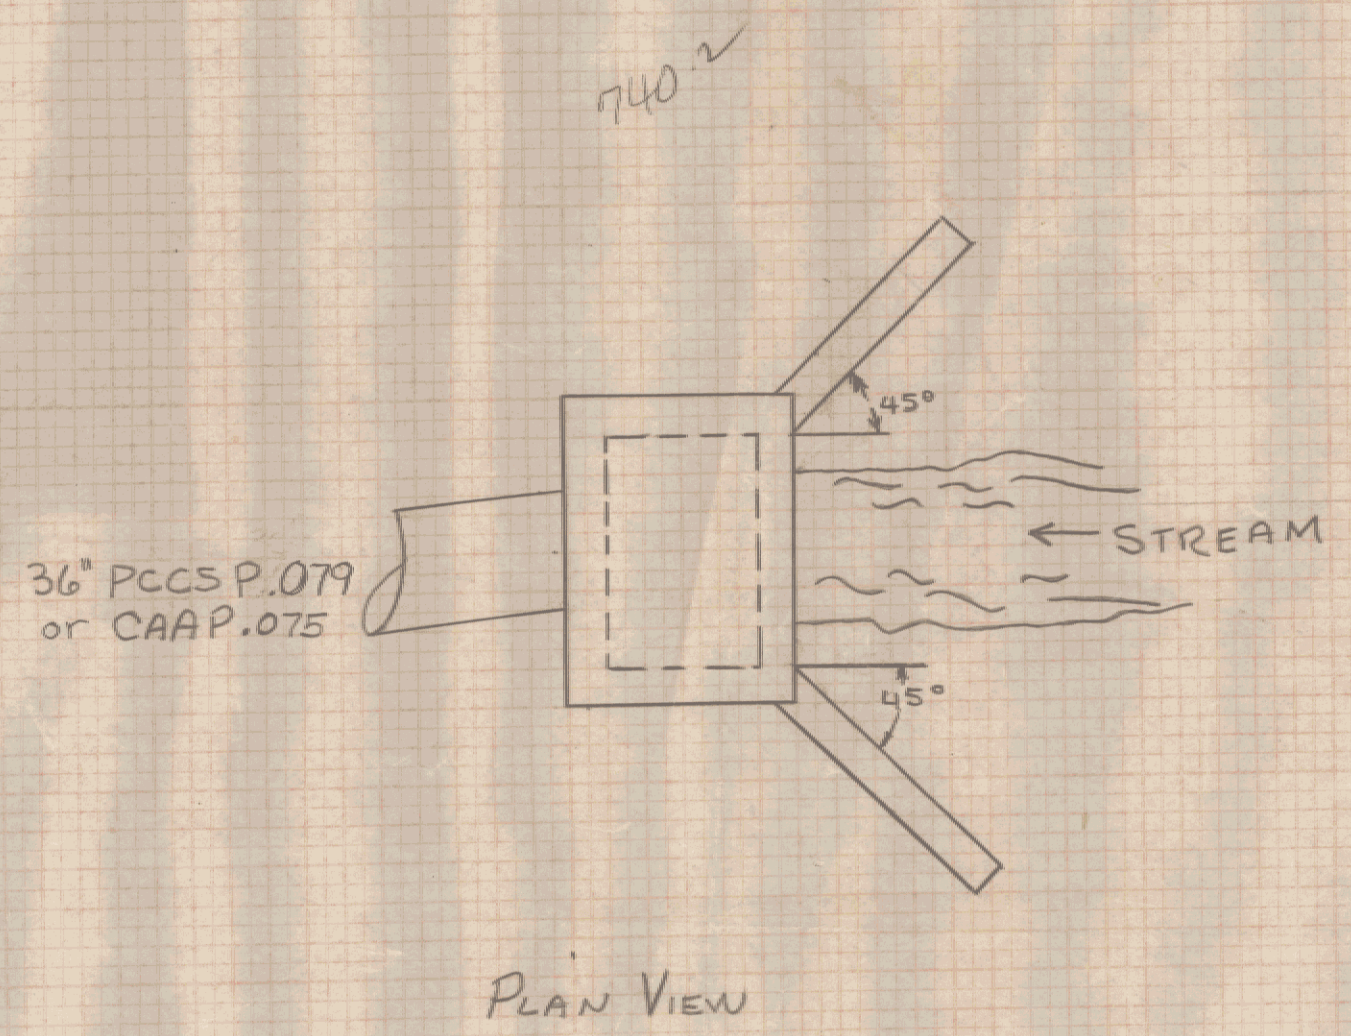

40+95L ~ 41+45 Rt
New 36" x 104' PCCSP.064
or CAAP.060 DETAILS
MONTPELIER
ME6C - M6400(7)
SHEET 203 OF 335