
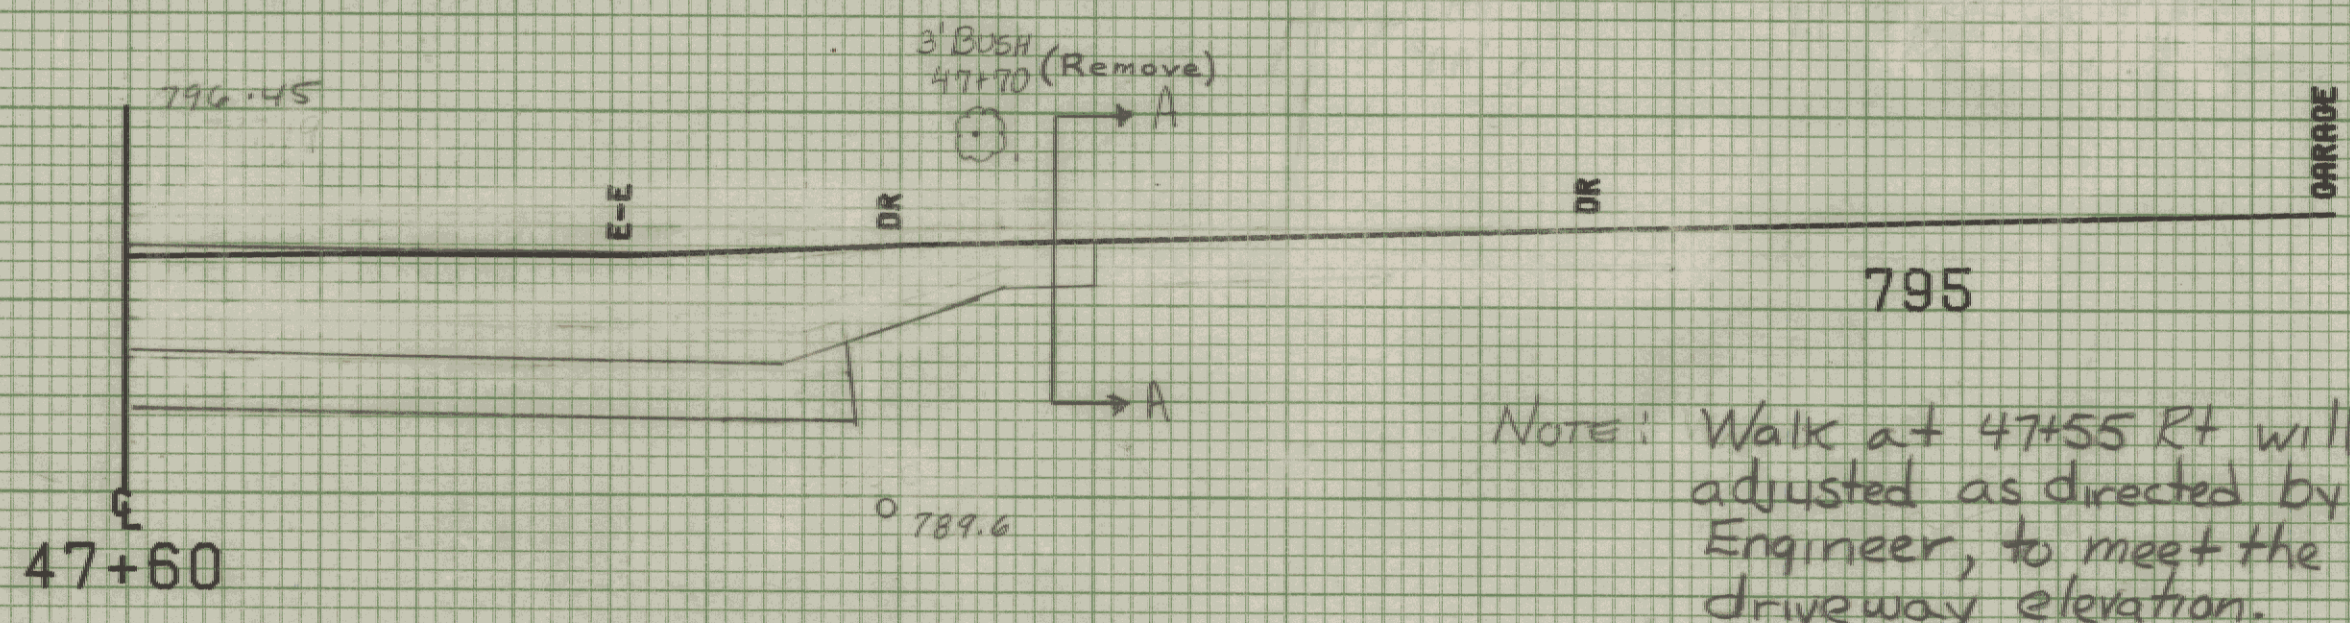
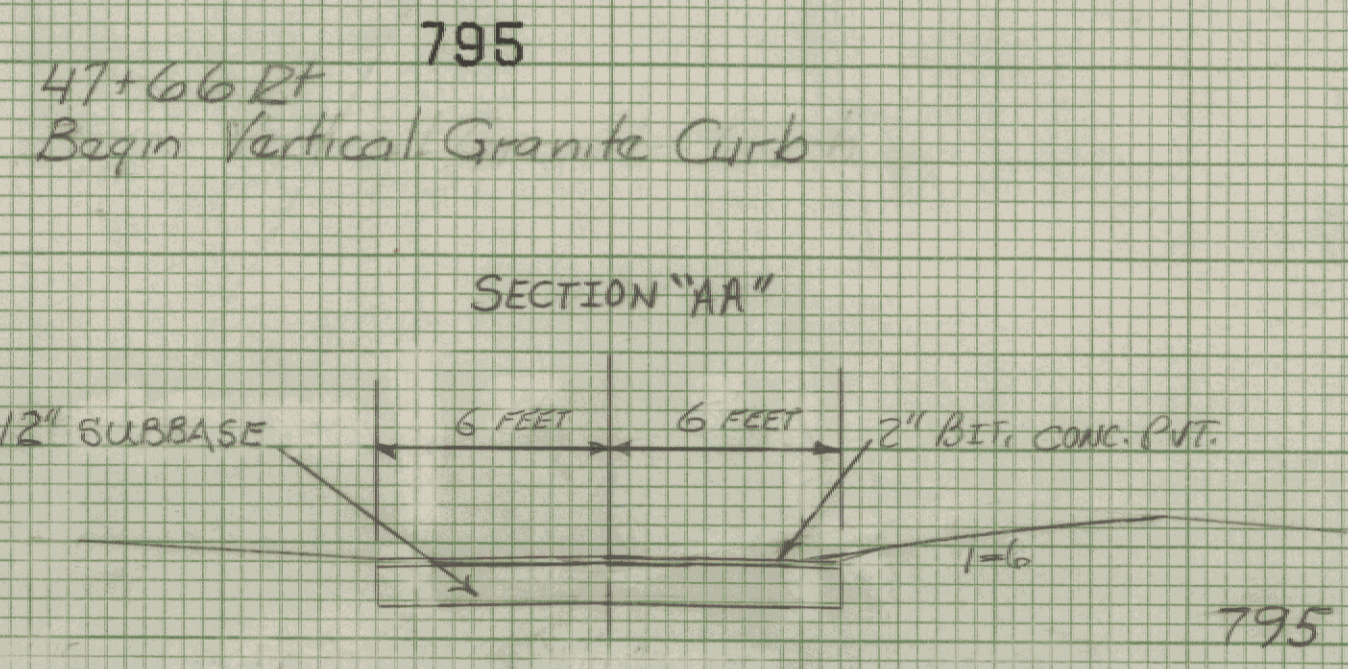


VALERIE AVE. Section B-B

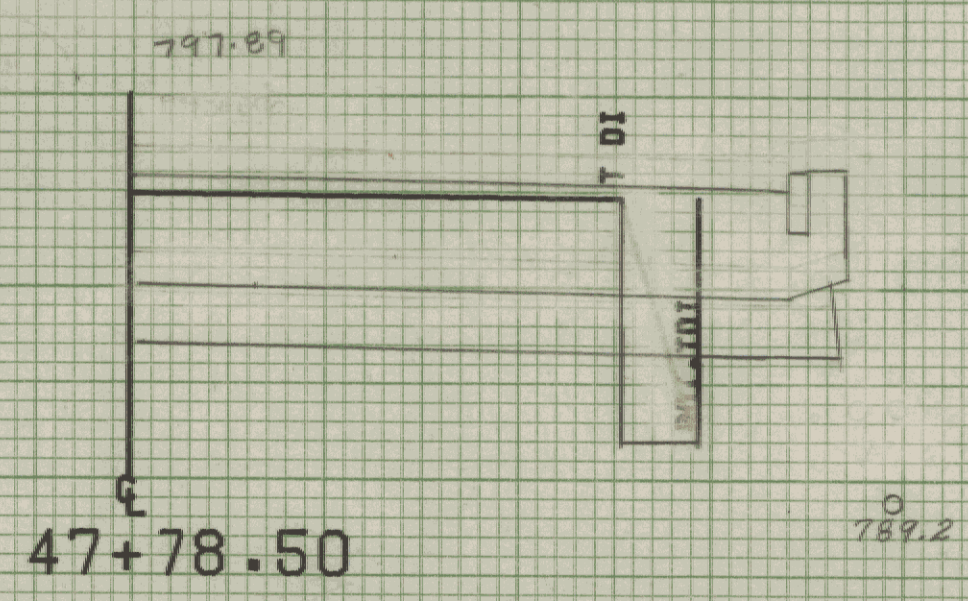


47+60R+
 Construct Drive
 12' Wide (Paved)

Note: Walk at 47+55 Rt will be adjusted as directed by the Engineer, to meet the new driveway elevation.

47+53 LT
 End Vertical Granite Curb

47+54 RT
 End Vertical Granite Curb

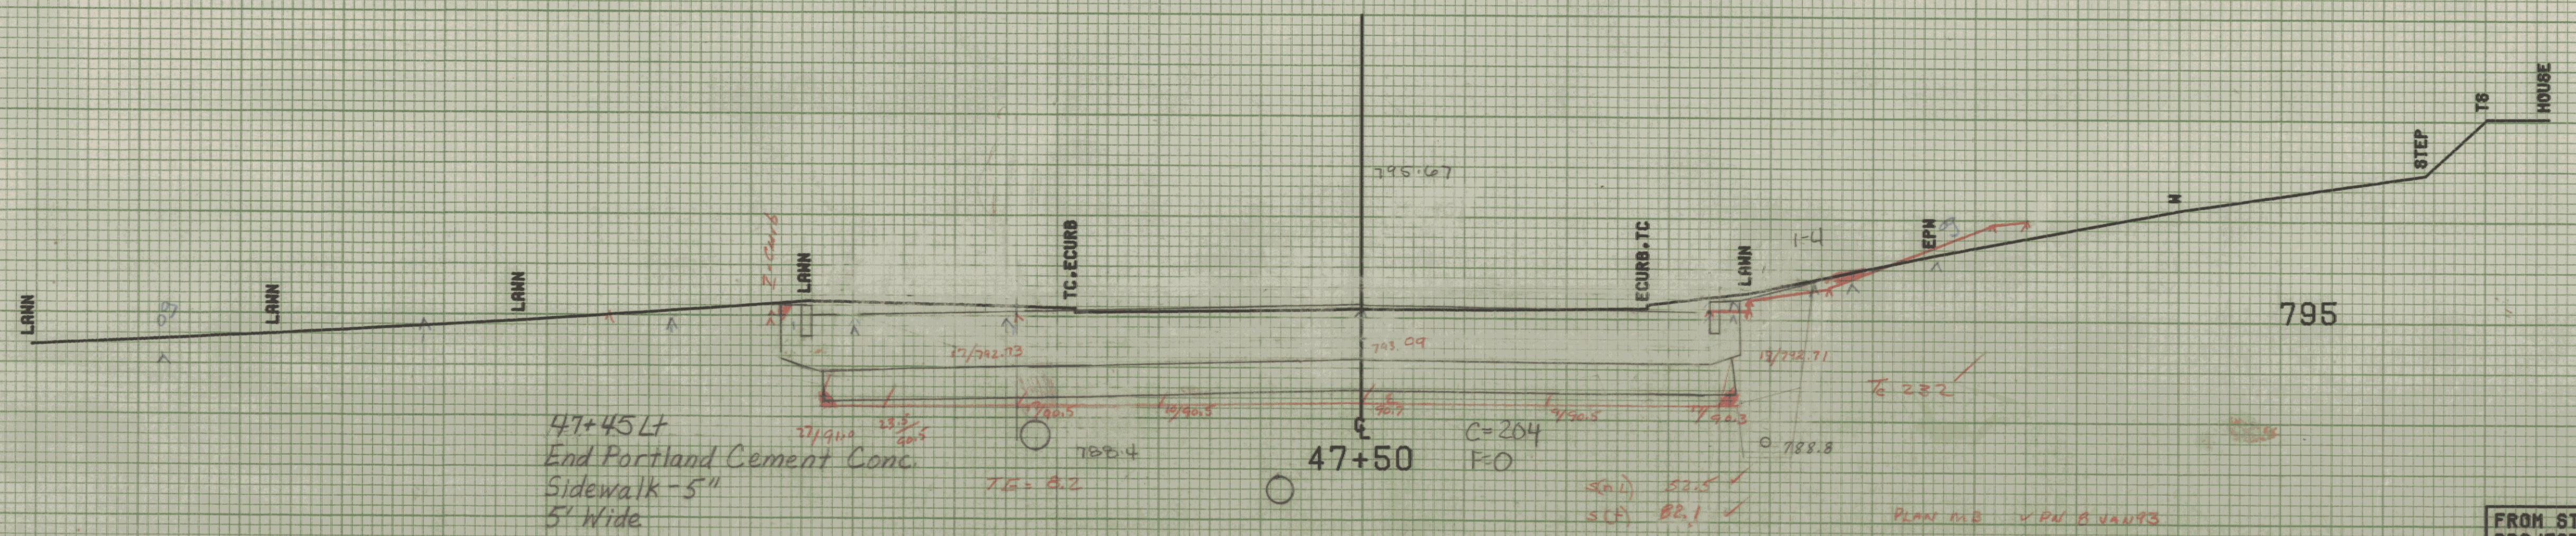

47+45 LT
 End Portland Cement
 Sidewalk - 5"
 5' Wide

SCALE 5 FEET