



805

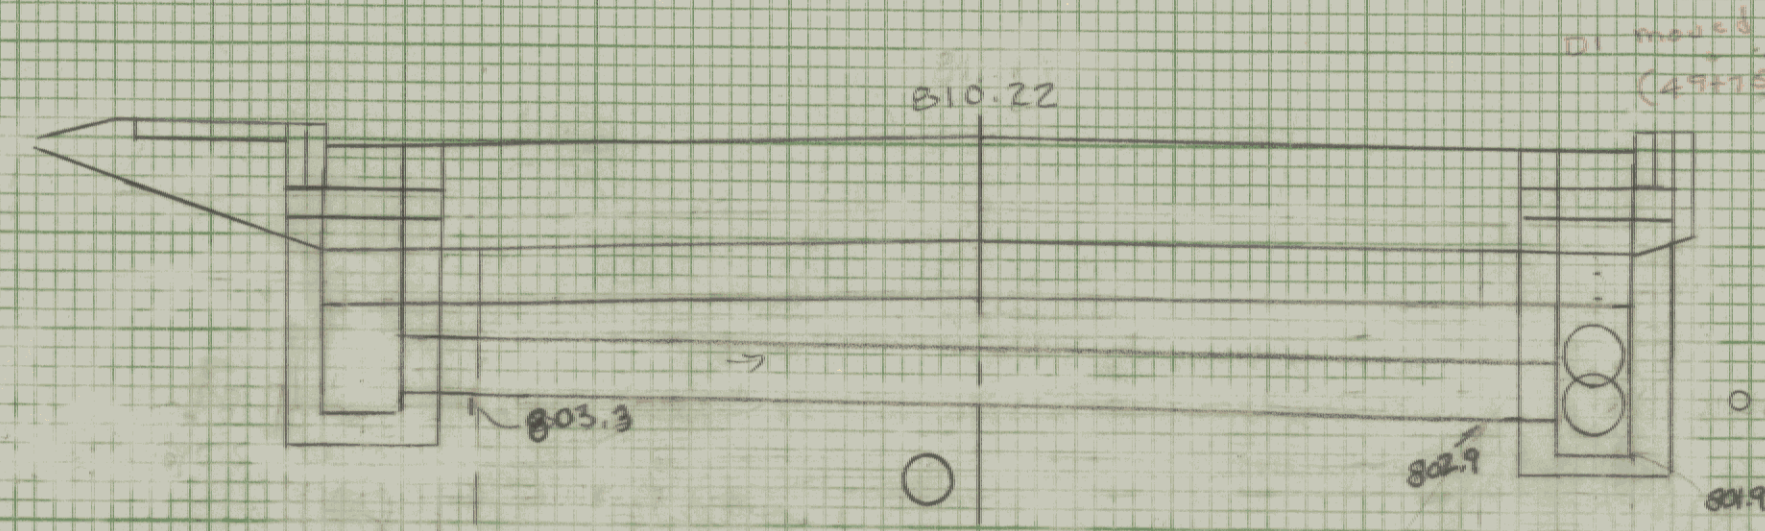


49+45 RT
 Begin New 18"x 154' PCCSP.064
 or CAAP.060
 End New 18"x 98' PCCSP.064
 or CAAP.060

49+45 E
 New 18"x 30' PCCSP.064 or
 CAAP.060

49+48.5 LT
 Remove Existing 12" CMP
 With 2'x2' DI

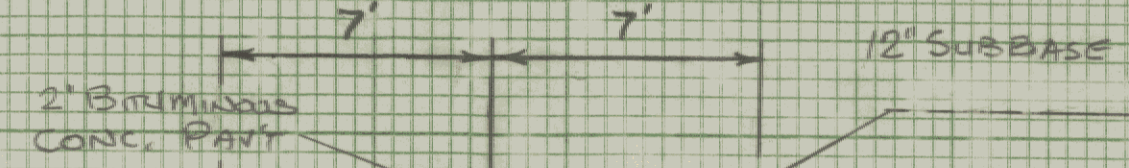

Section "B-B"

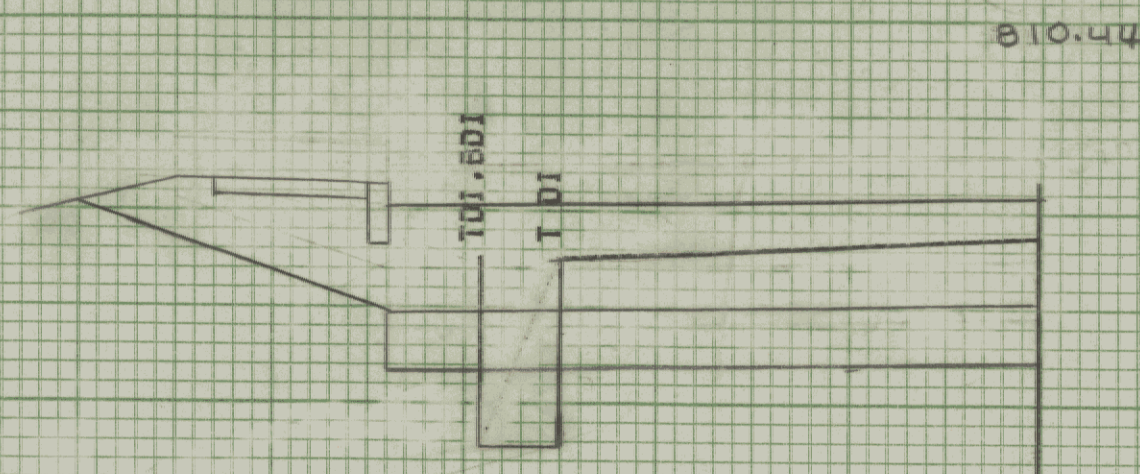


49+48.50

805

49+48.5
 10' DIA
 (Remove)

49+41 LT
 Begin Vertical Granite Curb

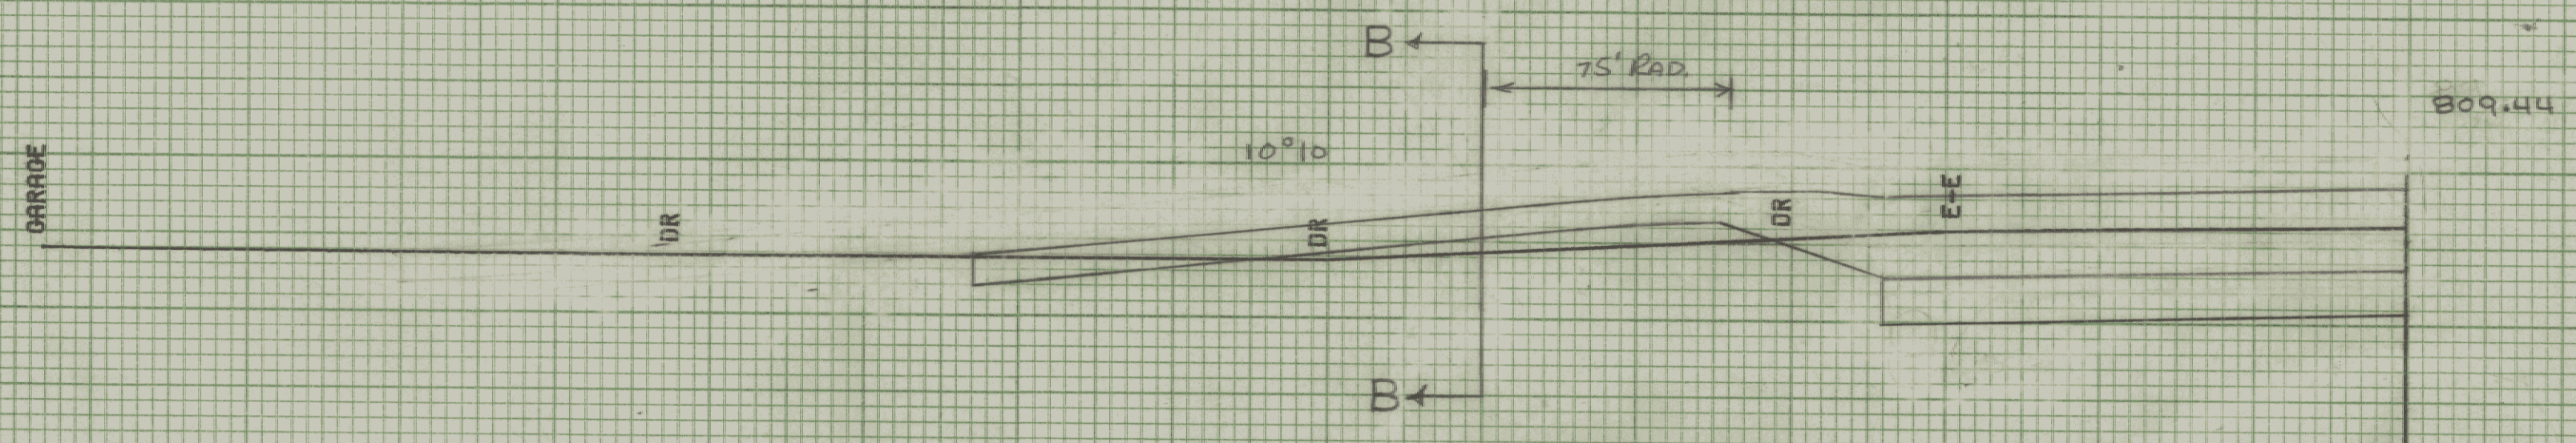


809.44

805

49+33 LT
 Construct Drive
 14' Wide, Paved

49+33

49+21 LT
 End Vertical Granite Curb

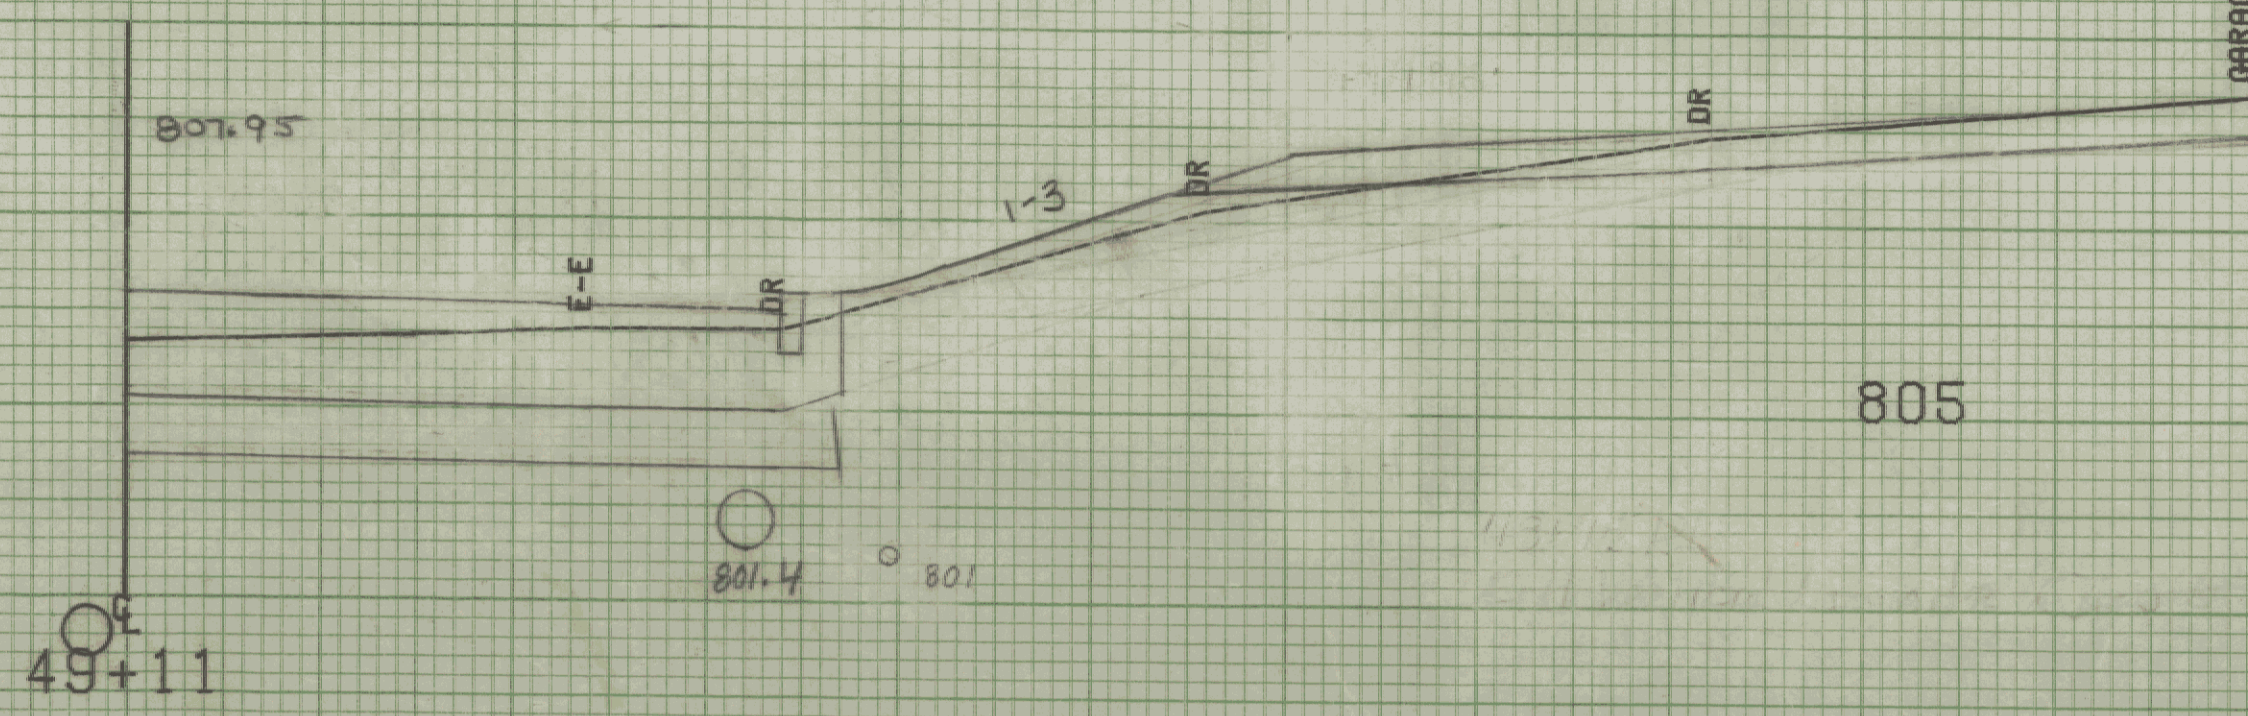

49+11

805