
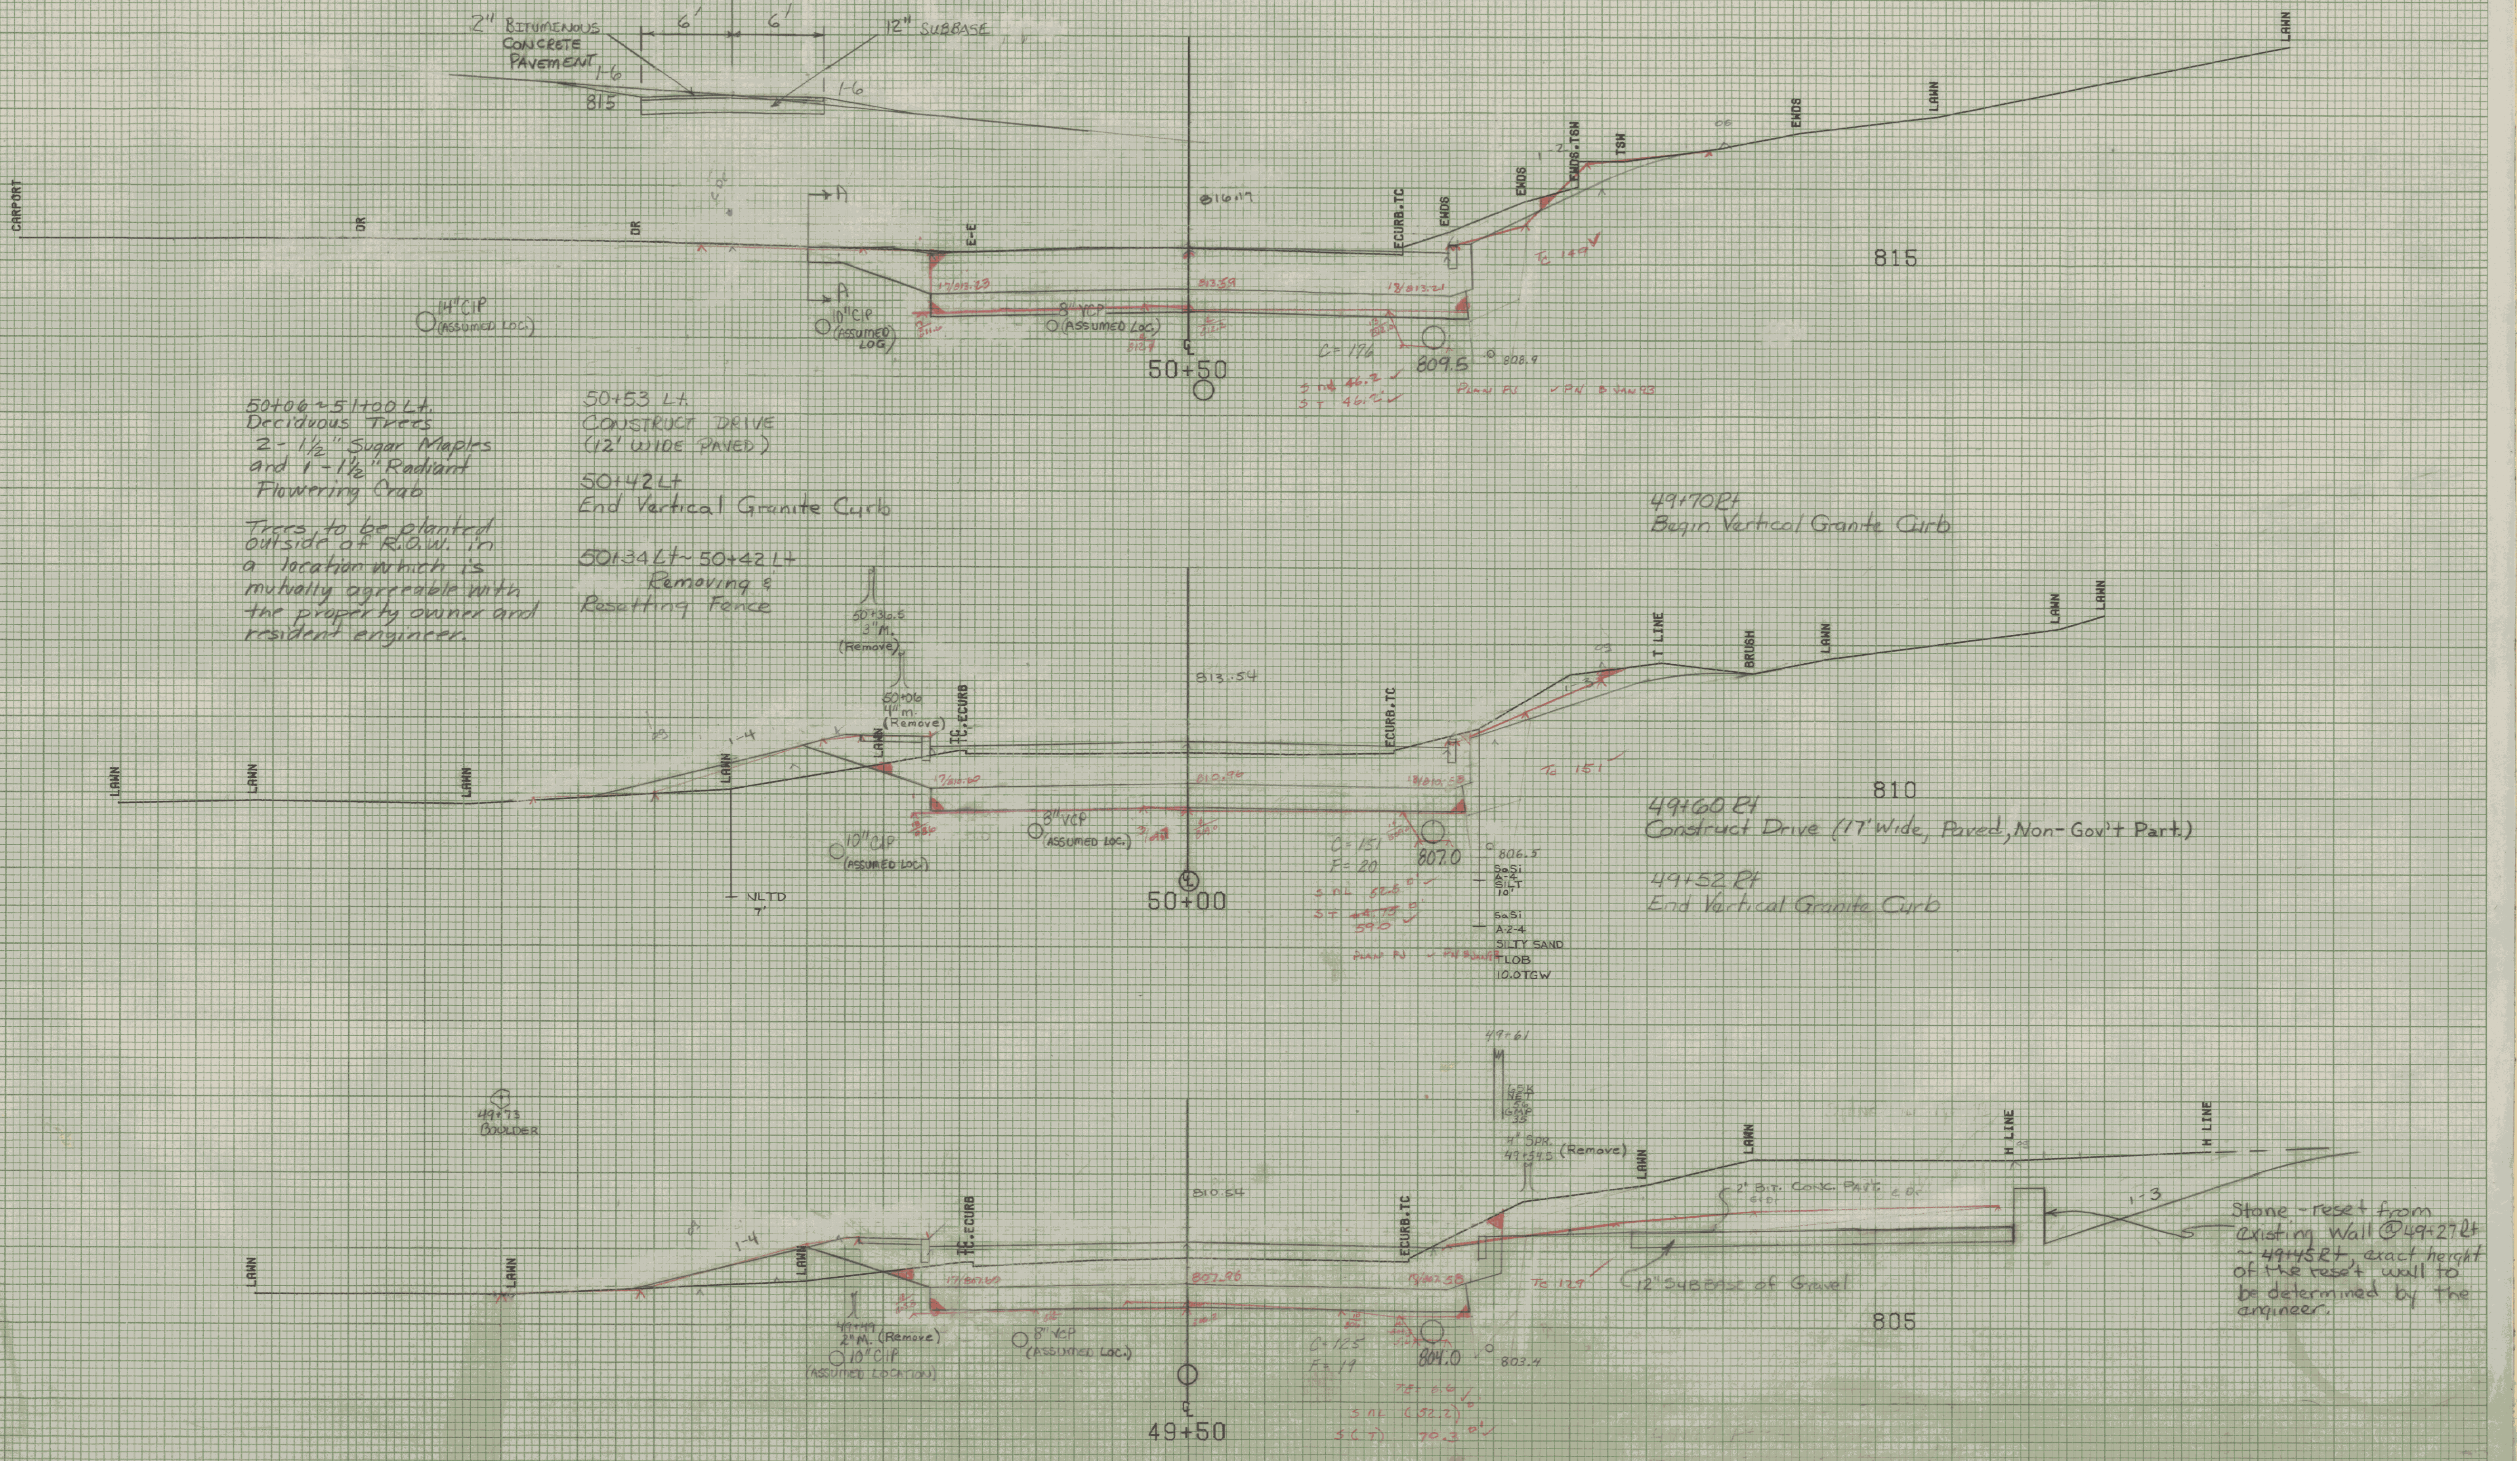


SECTION "AA"

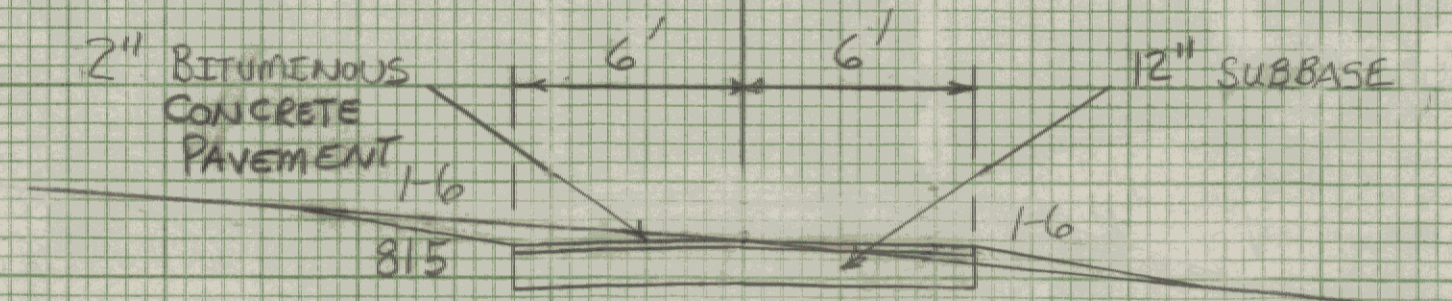

50+06 ~ 51+00 Lt.
Deciduous Trees
2 - 1 1/2" Sugar Maples
and 1 - 1 1/2" Radiant
Flowering Crab

Trees to be planted
outside of R.O.W. in
a location which is
mutually agreeable with
the property owner and
resident engineer.

50+53 Lt.
CONSTRUCT DRIVE
(12' WIDE PAVED)

50+42 Lt.
End Vertical Granite Curb

50+34 Lt ~ 50+42 Lt
Removing &
Resetting Fence

49+70 Rt
Begin Vertical Granite Curb

49+60 Rt
Construct Drive (17' Wide, Paved, Non-Gov't Part.)

49+52 Rt
End Vertical Granite Curb

Stone - reset from
existing wall @ 49+27 Rt
~ 49+52 Rt exact height
of the reset wall to
be determined by the
engineer.

Plot 216
12/06/93