


51+50 Lt  
 End New 6" x 50' Underdrain  
 w/ P.B. @ 51+50 Lt.  
 51+34 Lt  
 Begin Vertical Granite Curb

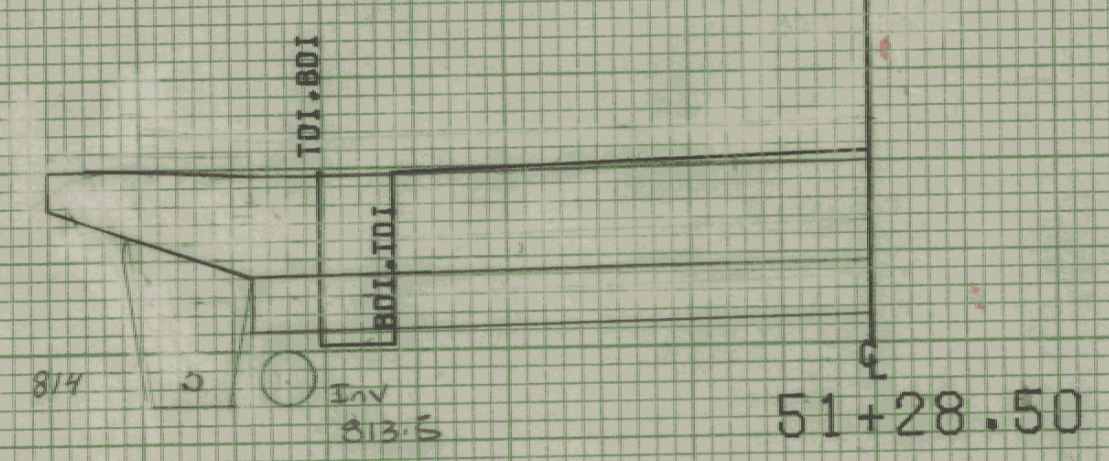

FROM STA. 51+28.50 TO STA. 52+00  
 PROJECT NAME MONTPELIER MAINS  
 NO. M&A-C-M6400(7) PLOTTED 06/07/85  
 SURVEYED BY KASTNER-MORAN JUNE 1985  
 SHEET 212 OF 335 SHEETS

Plot FS  
 Plot 2/1/85 11/10/93

SCALE 5 FEET