
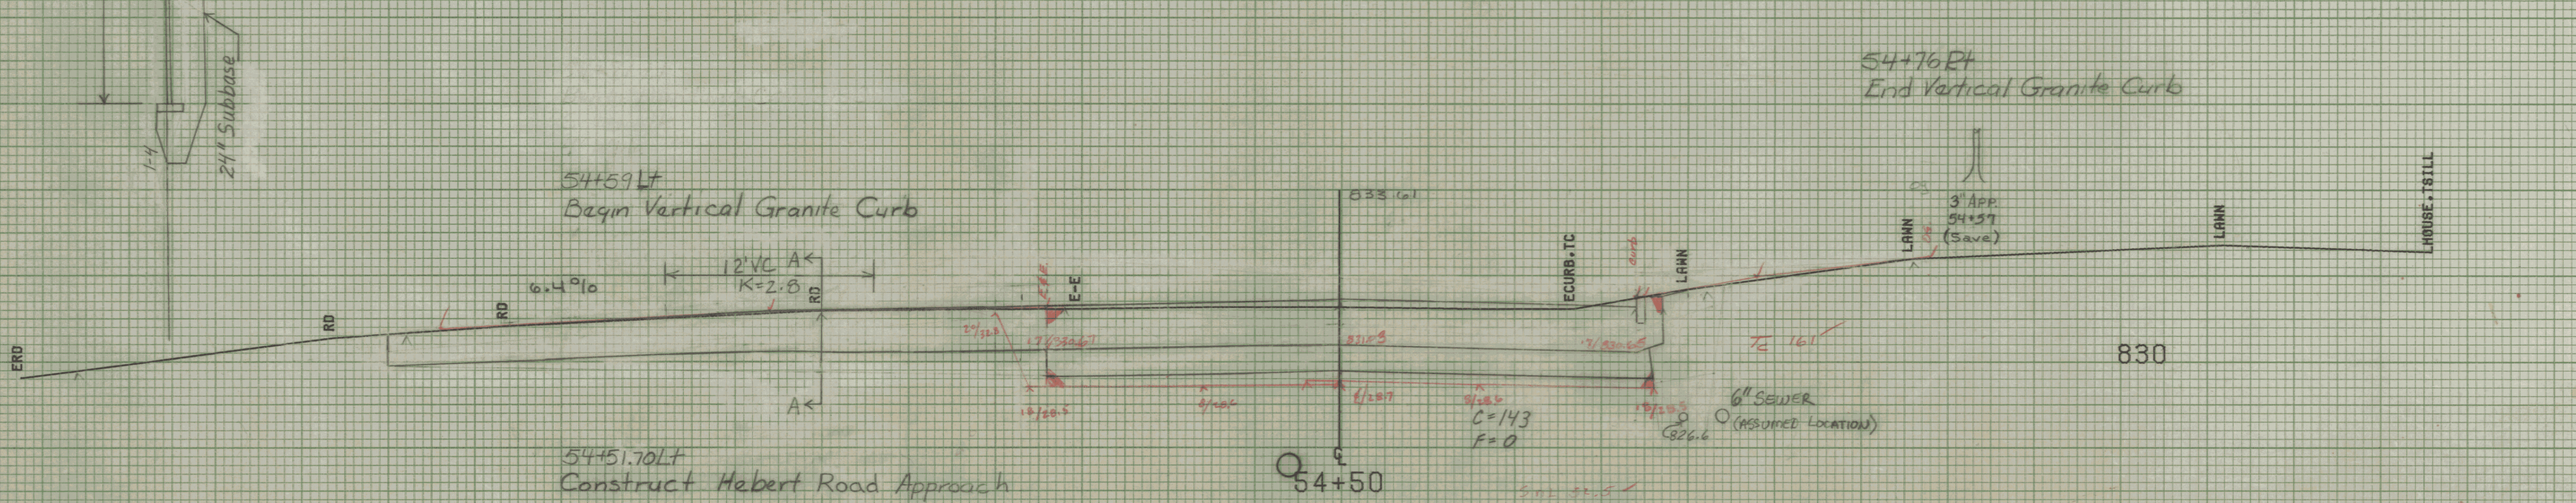
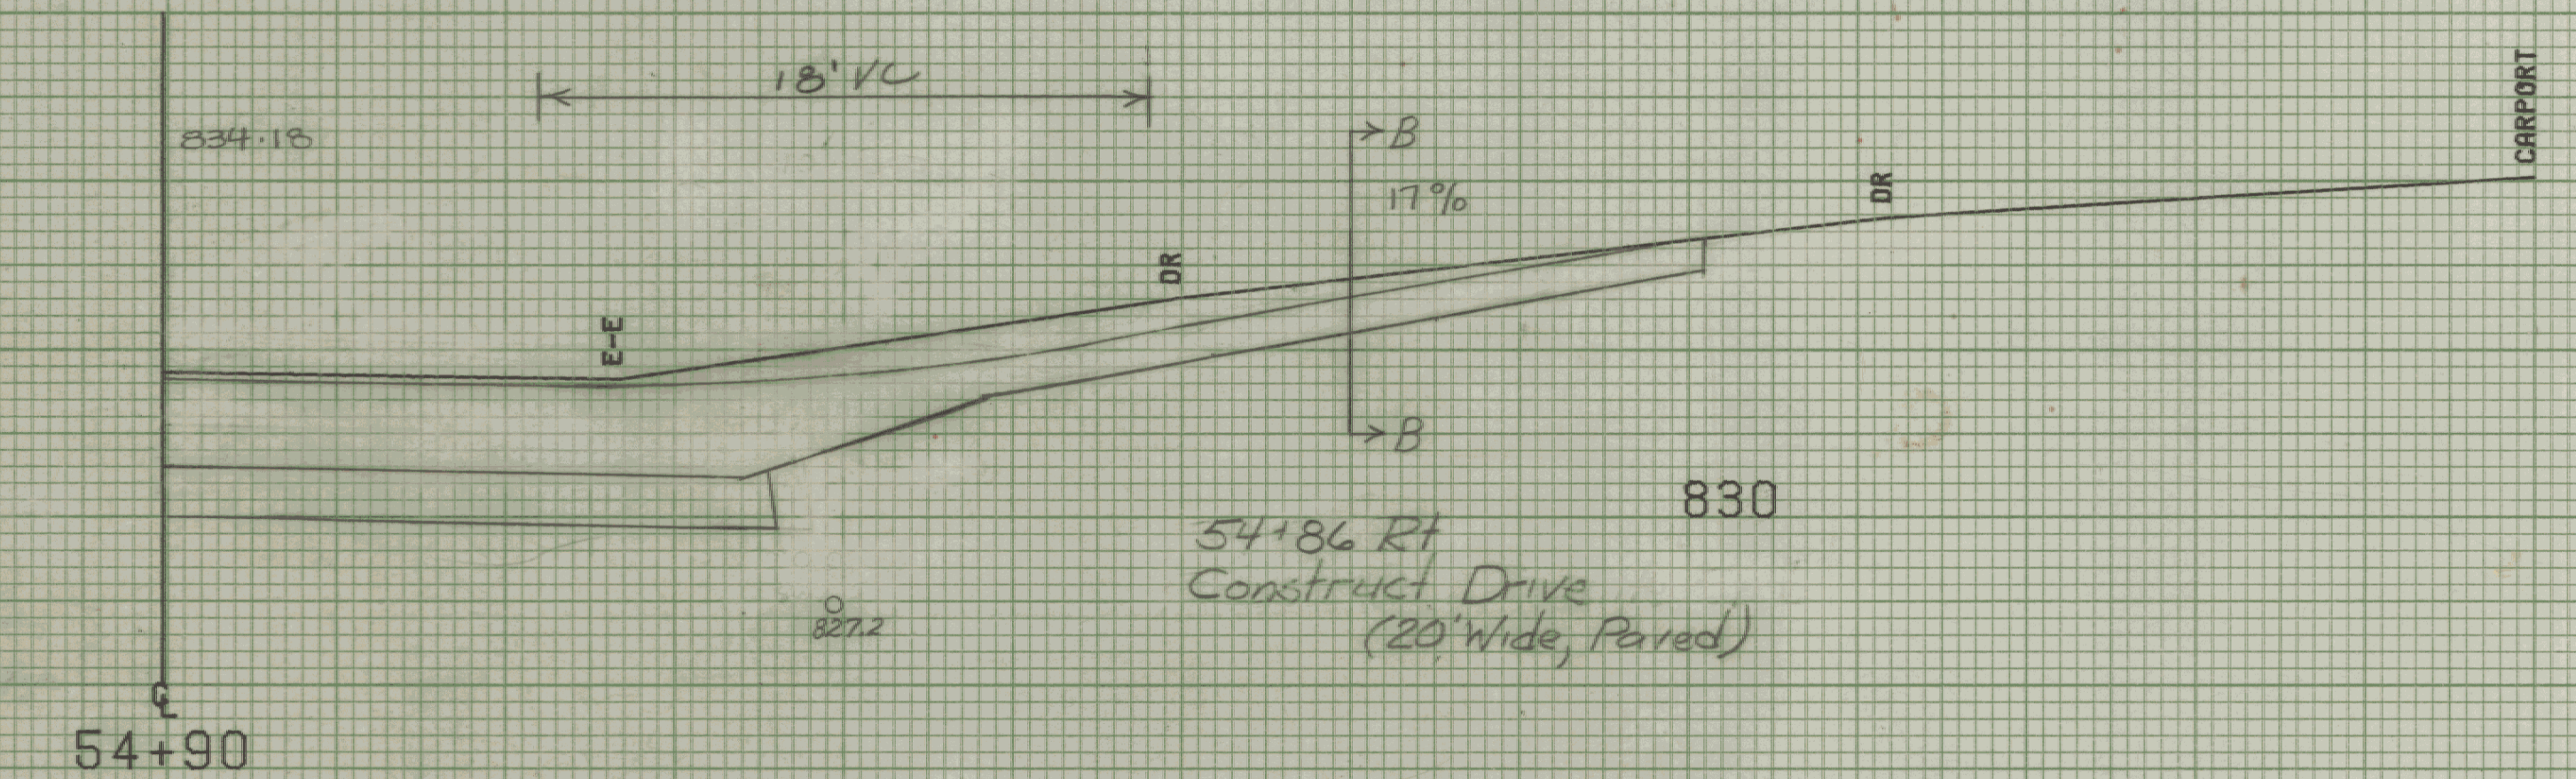
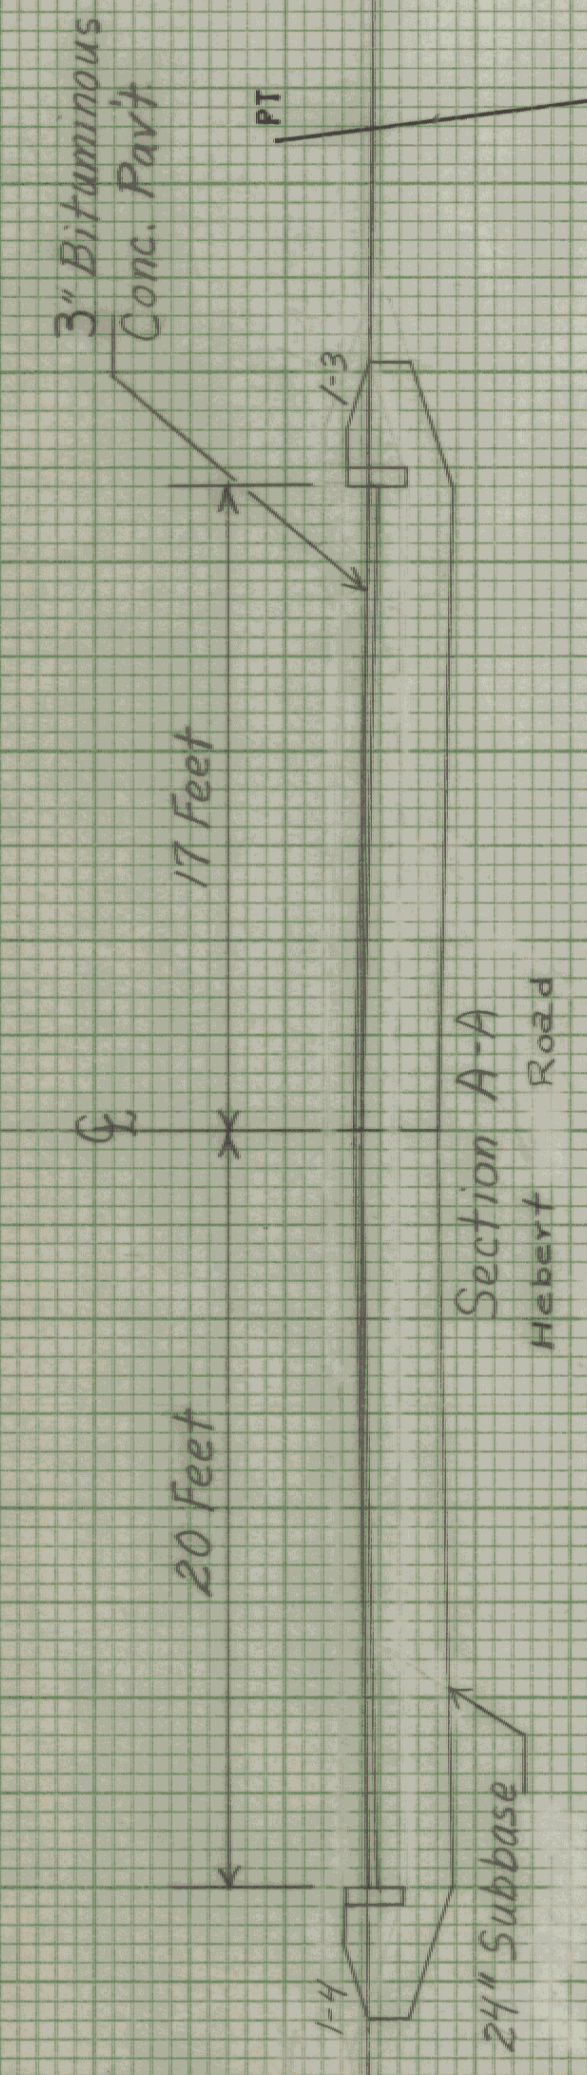


PT 55+20.49
 Dc 12° 00' RT
 N.C.
 55+20 RT
 End New 6" Underdrain
 w/ Flushing Basin @ 55+20 RT
 55+03 R6
 Relocate Mailbox, Single Support (1)

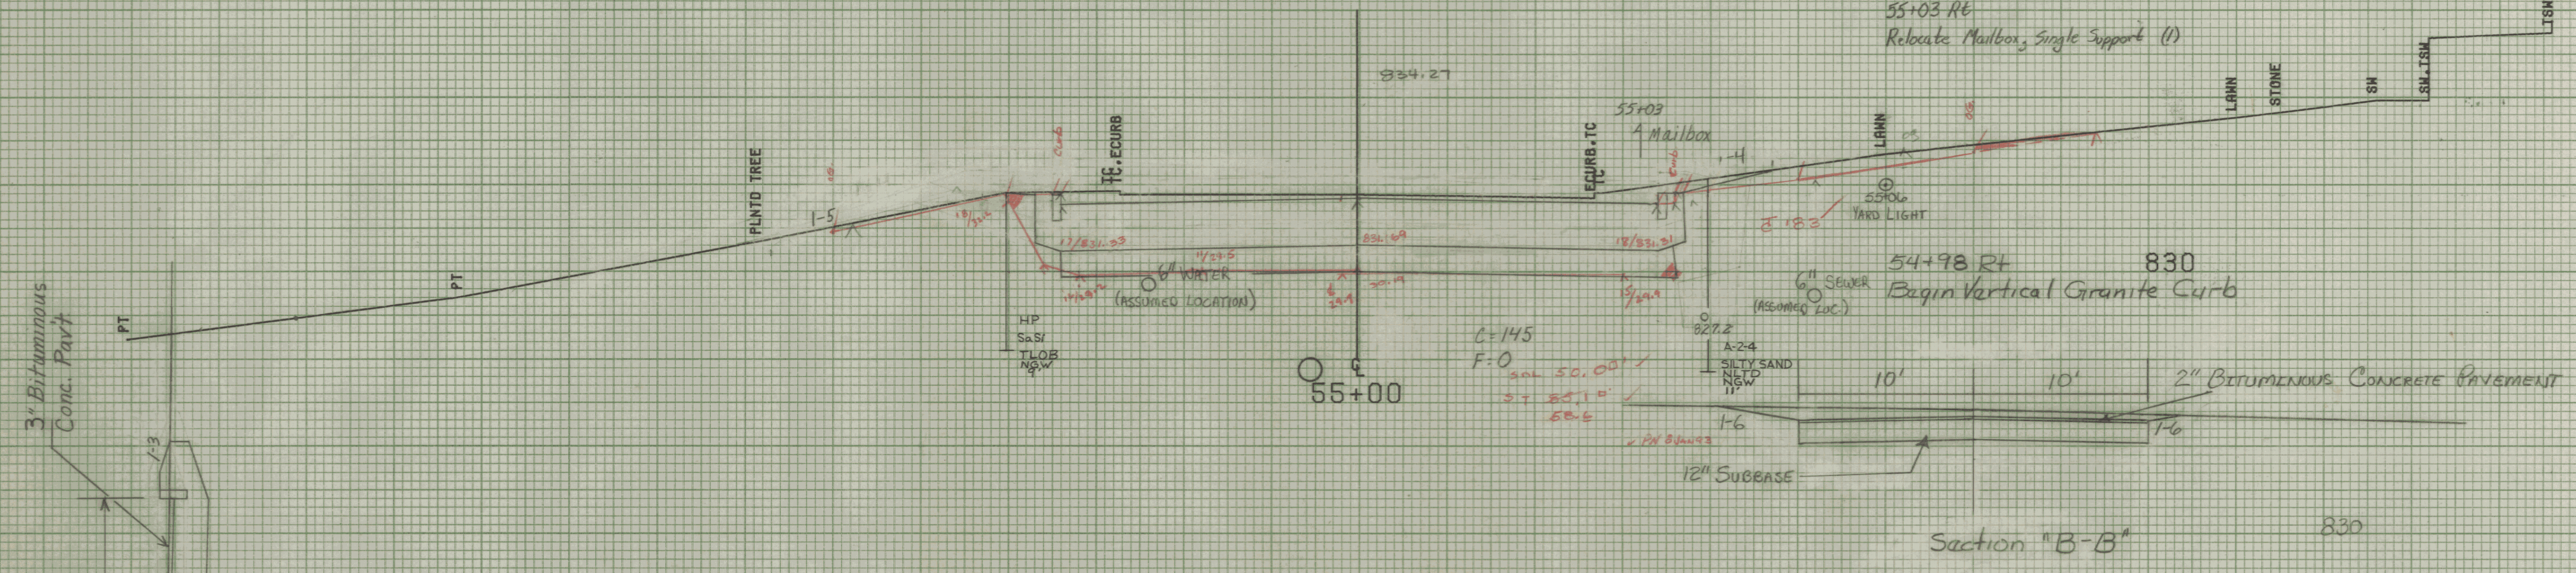

FROM STA. 54+50 TO STA. 55+00
 PROJECT NAME MONTPELIER MAINS
 NO. MEGC-16400(7) PLOTTED 08/07/85
 SURVEYED BY KASTNER MOREAU JUNE 1985
 SHEET 22 OF 335 SHEETS

SCALE 5 FEET

FINALS - C.R. 10/15/93

Plan by 12/06/93