


56+00 Lt ~ 56+40 Lt
 6" x 40' Underdrain
 w/ FB @ 56+00 Lt.

56+40 R
 New 18" x 30' PCCSP.064
 OR CAAP.060

56+40 Pt
 Begin 18" x 104' PCCSP.064 or CAAP.060

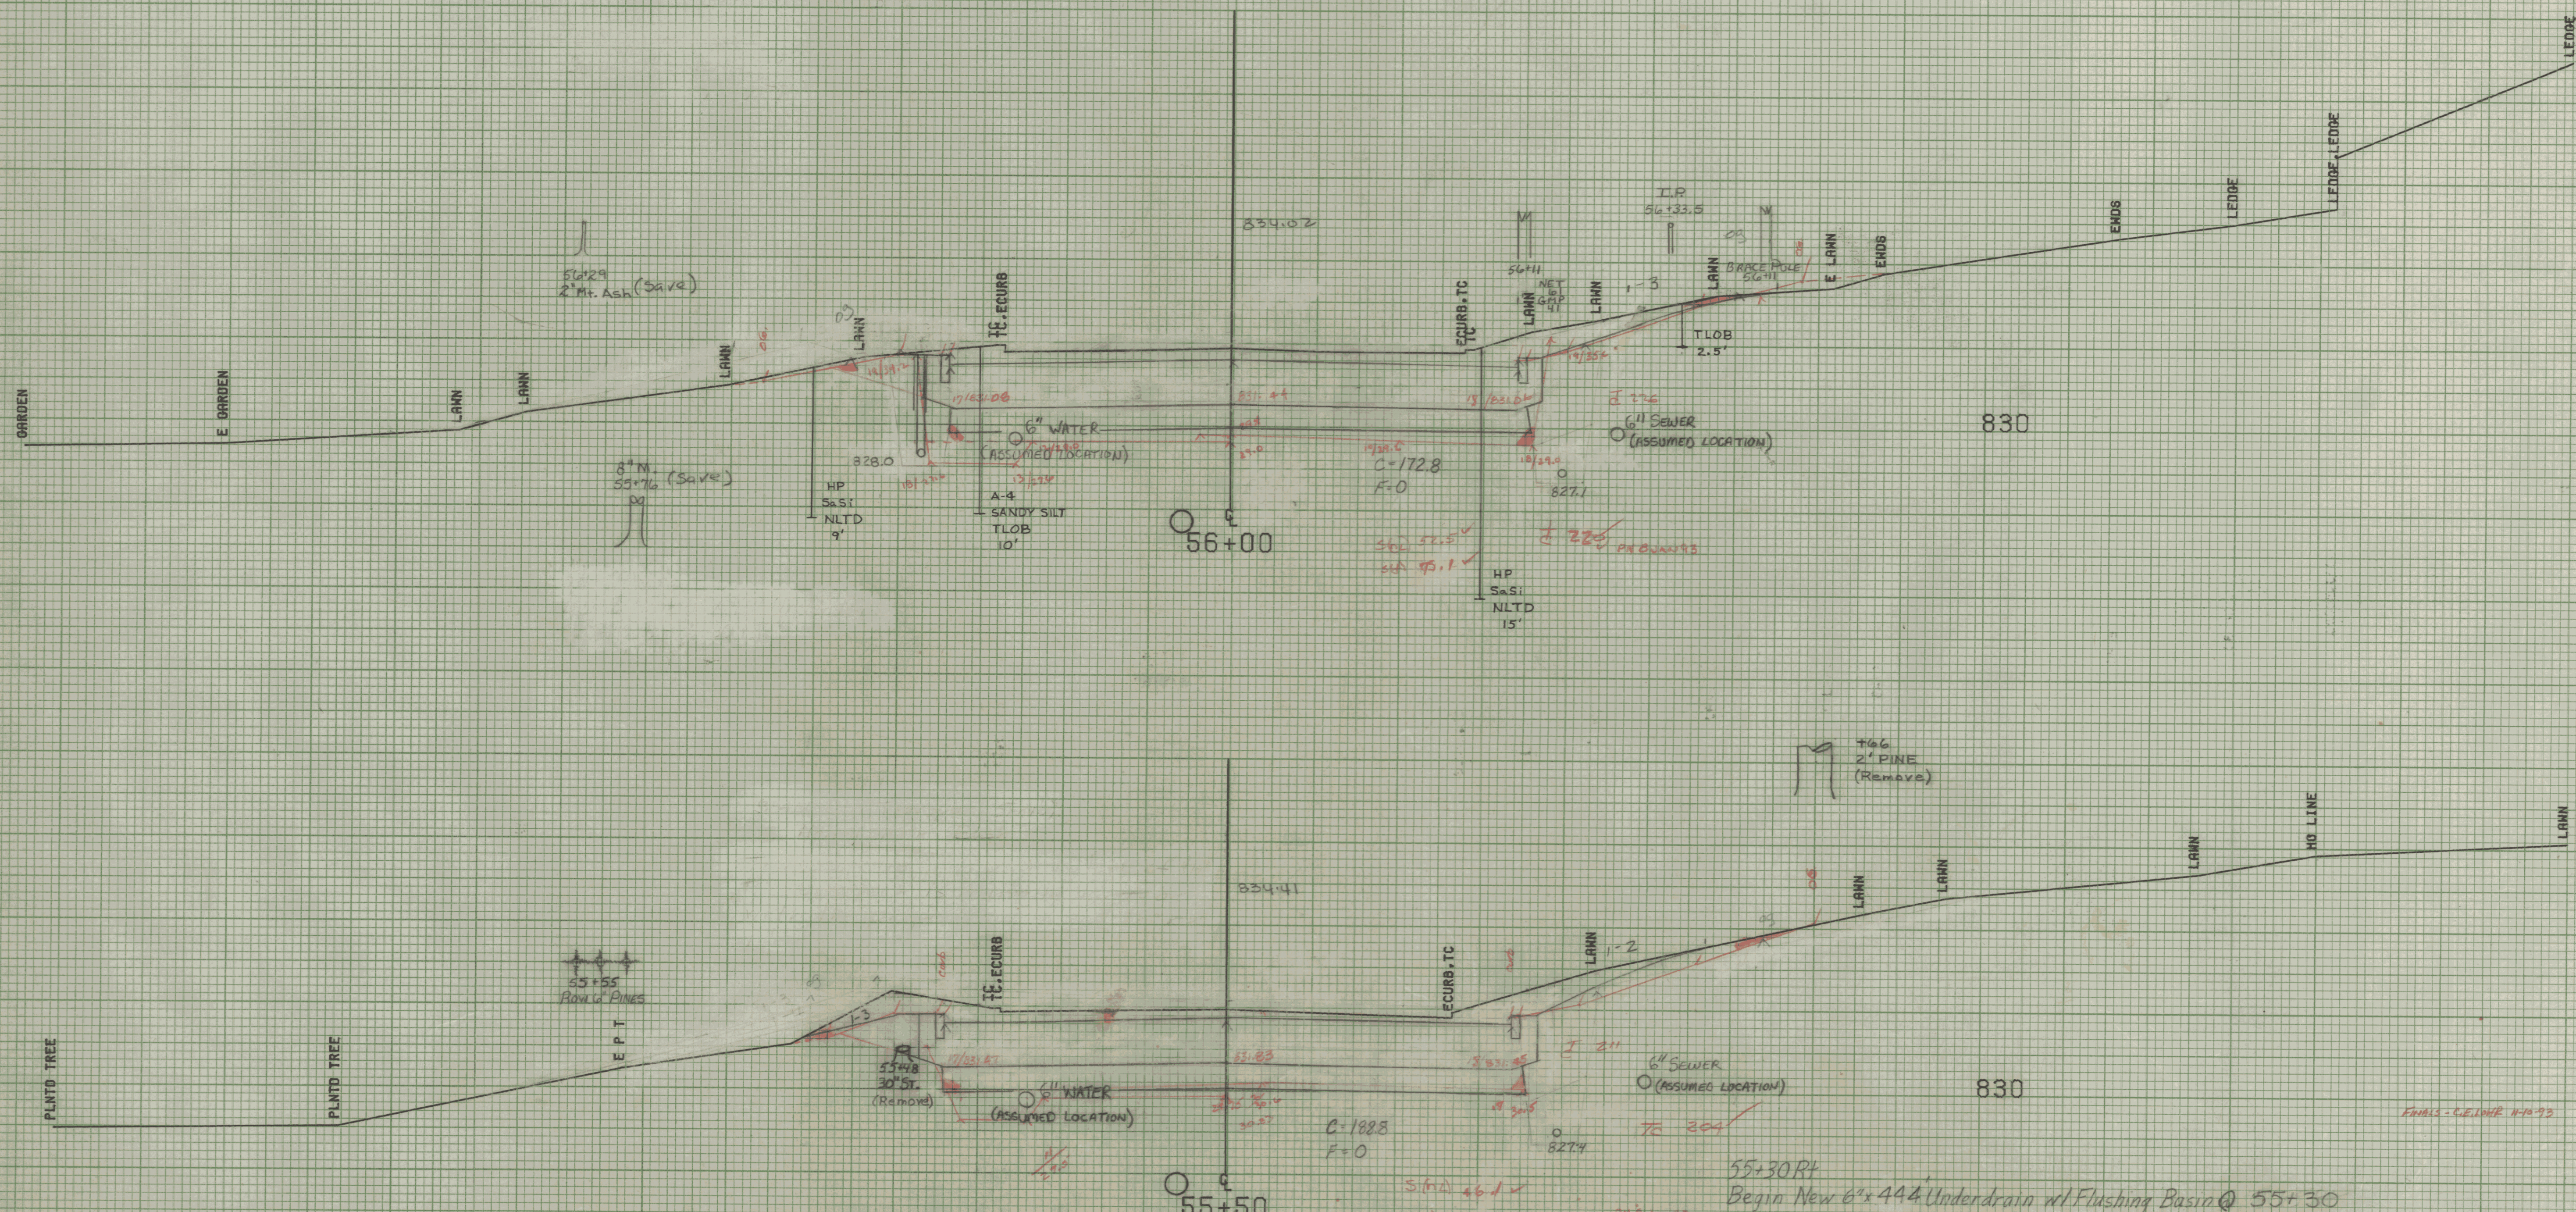

FROM STA.	55+50	TO STA.	56+00
PROJECT NAME	MONTPELIER MAIN		
NO.	MEGC-M6400(7)		
SURVEYED BY	KASTNER-MOREAU JUNE 1985		
SHEET	204	OF	335 SHEETS

SCALE 5 FEET

Plan 8/11/93

FINAL - 06/10/93