



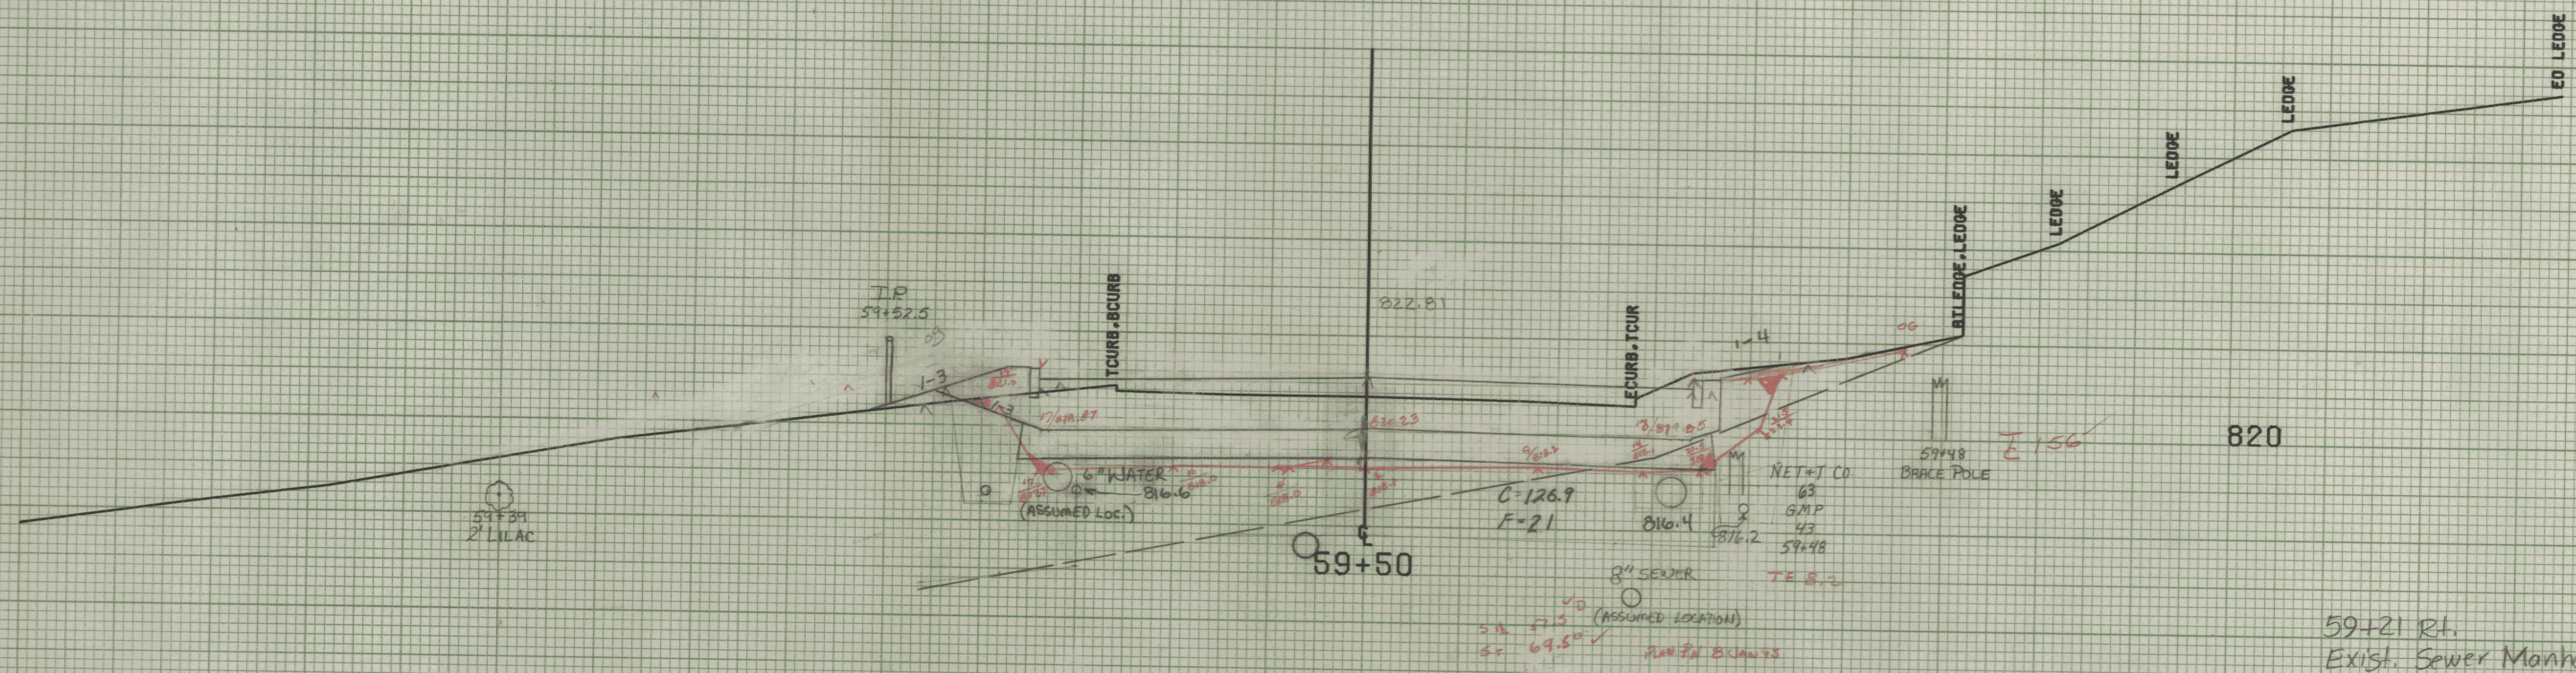

59+30 LT
Begin New 6"x50' Underdrain
w/ F.B. @ 59+30 LT.

59+21 RT.
Exist. Sewer Manhole - Retain
Adjust Elev. of Manhole
Non-Gov't. Participation

58+95 Lt. Remove and Reset Yard Light
The light shall be relocated outside of the
City's R.O.W. limits at a location mutually
agreeable with the resident engineer
and the property owner. The cost of
the work and necessary materials
shall be paid as Item 6.25 (1100).
Removing and Resetting Light
Pole and shall be Non-Gov't.
Participating.

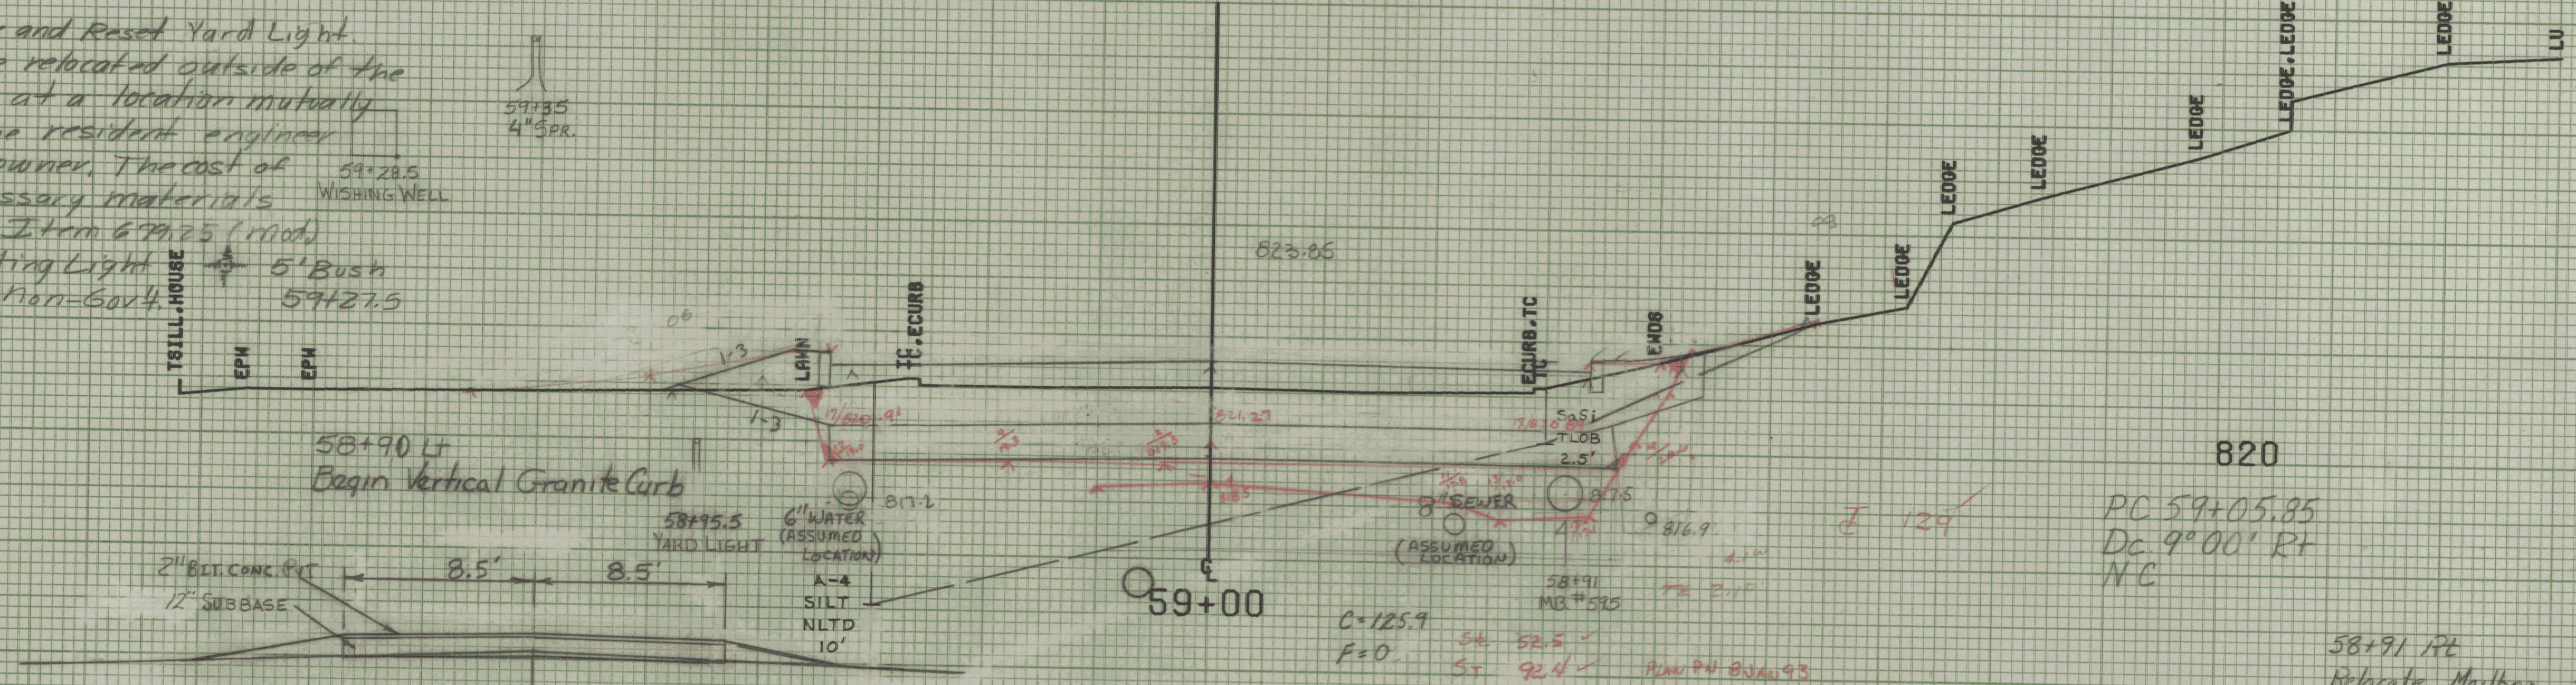


58+90 LT
Begin Vertical Granite Curb

820
PC 59+05.85
DC 9°00' RT
NC

58+91 RT
Relocate Mailbox, Single Support (1)

Section "A-A"

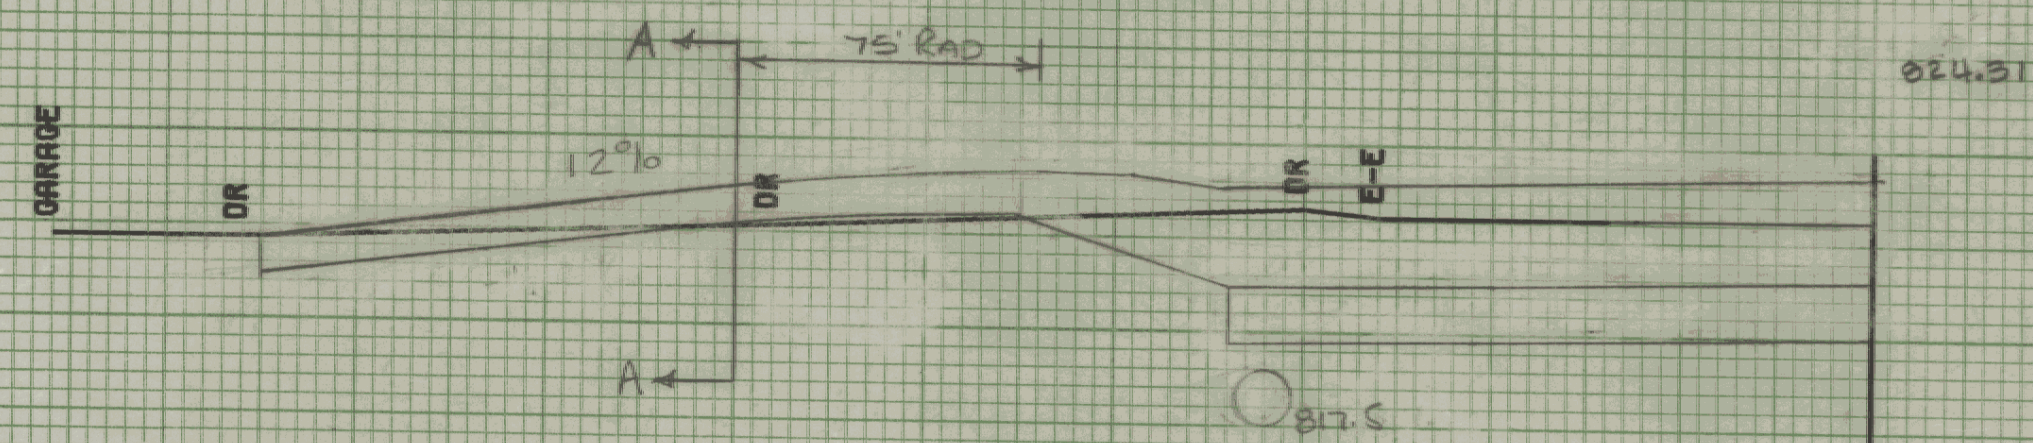

58+83 LT
Construct Drive
(17' wide, Paved)

58+73 LT
End Vertical Granite Curb

Plot F-3

11/26/84 12/10/87

SCALE 5 FEET

FROM STA.	58+83	TO STA.	59+50
PROJECT NAME	MONTPELIER MAIN7		
NO.	M1166-M6400(7)		
SURVEYED BY	KASTNER-MOREAU JUNE 1985		
SHEET	25	OF 335	SHEETS