


Rev. 64+80.58
CONSTRUCT APPROACH 28' WIDE (PAVED)
SHERWOOD DRIVE

Rev 65+12 Rt
Begin Vertical Granite Curb

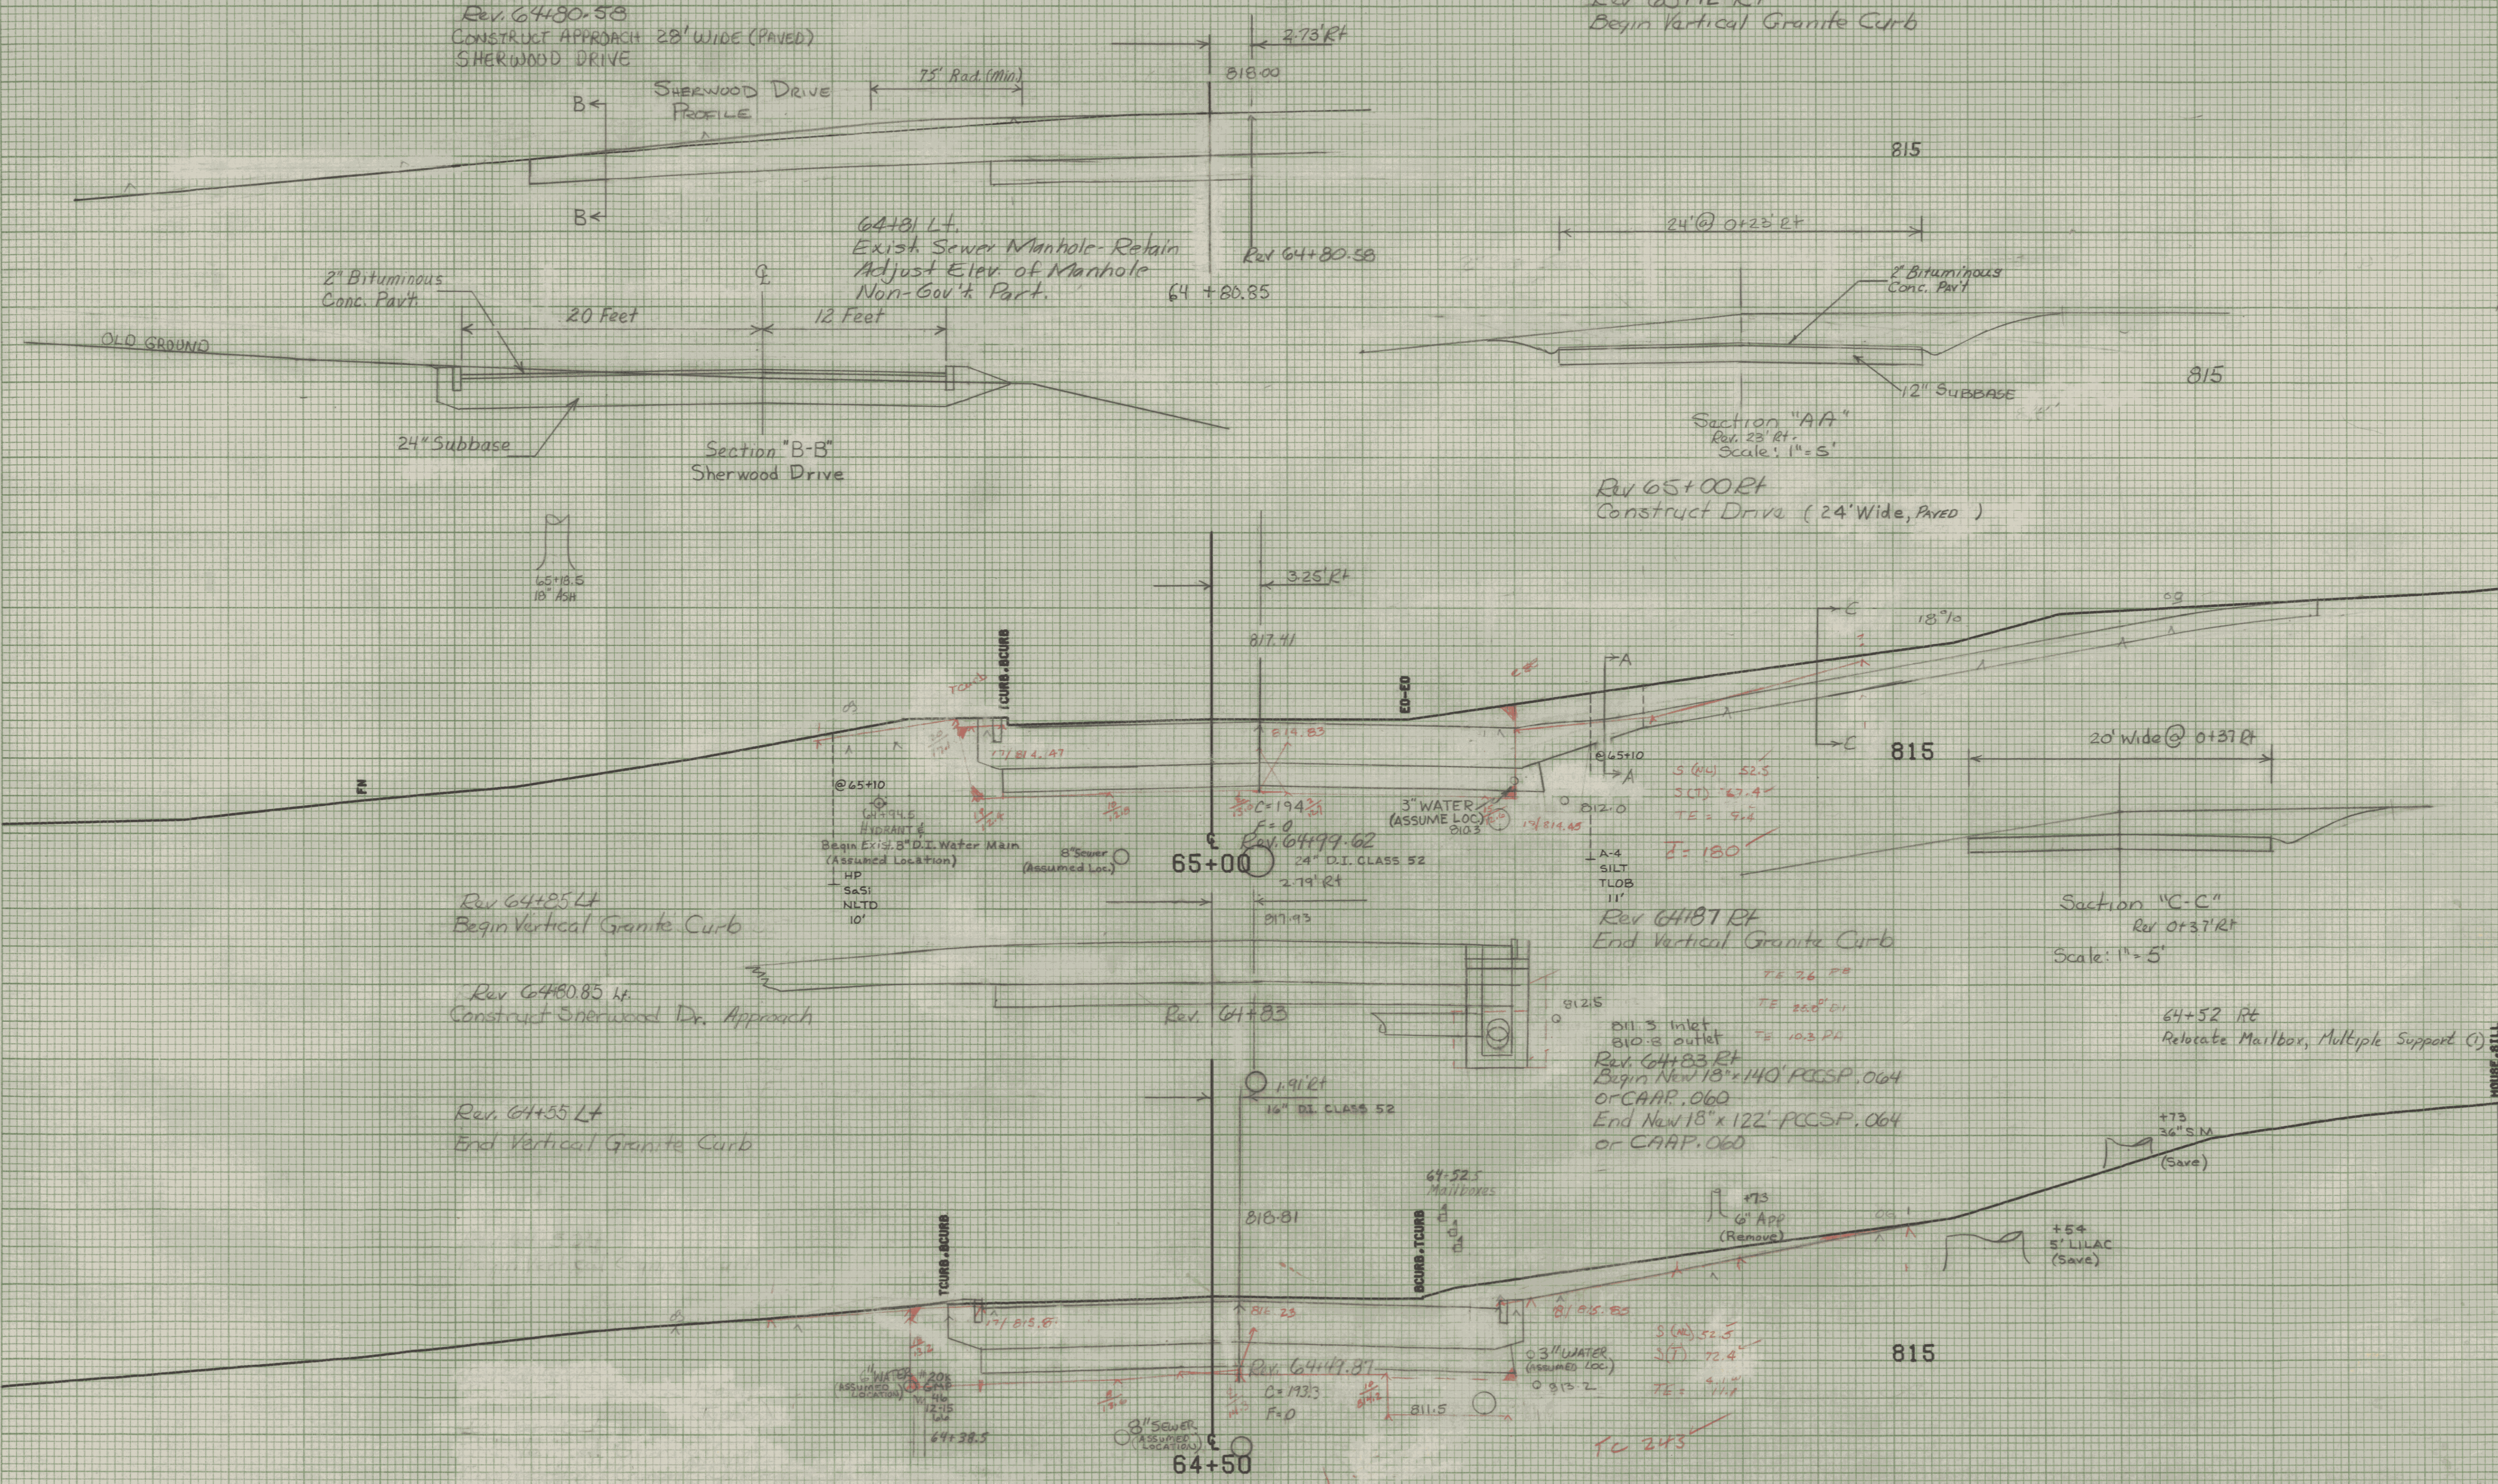

Rev 64+34 Lt
Begin Vertical Granite Curb

Plot E
✓ Plan 9/11/93 12/07/93

FROM STA.	64+50	TO STA.	65+00
PROJECT NAME	MONTPELIER MAIN		
NO.	M6400(7)		
SURVEYED BY	KASTNER-MOREAU JUNE 1985		
SHEET	235	OF	335 SHEETS
		PLOTTED 08/07/85	

SCALE 5 FEET