



Rev 65+75 Lt
 Begin New 6" x 50' Underdrain
 W/F.B. @ 65+75 Lt.

EXIST. 8" D.I. WATER MAIN
 (Assumed Location)
 808.0

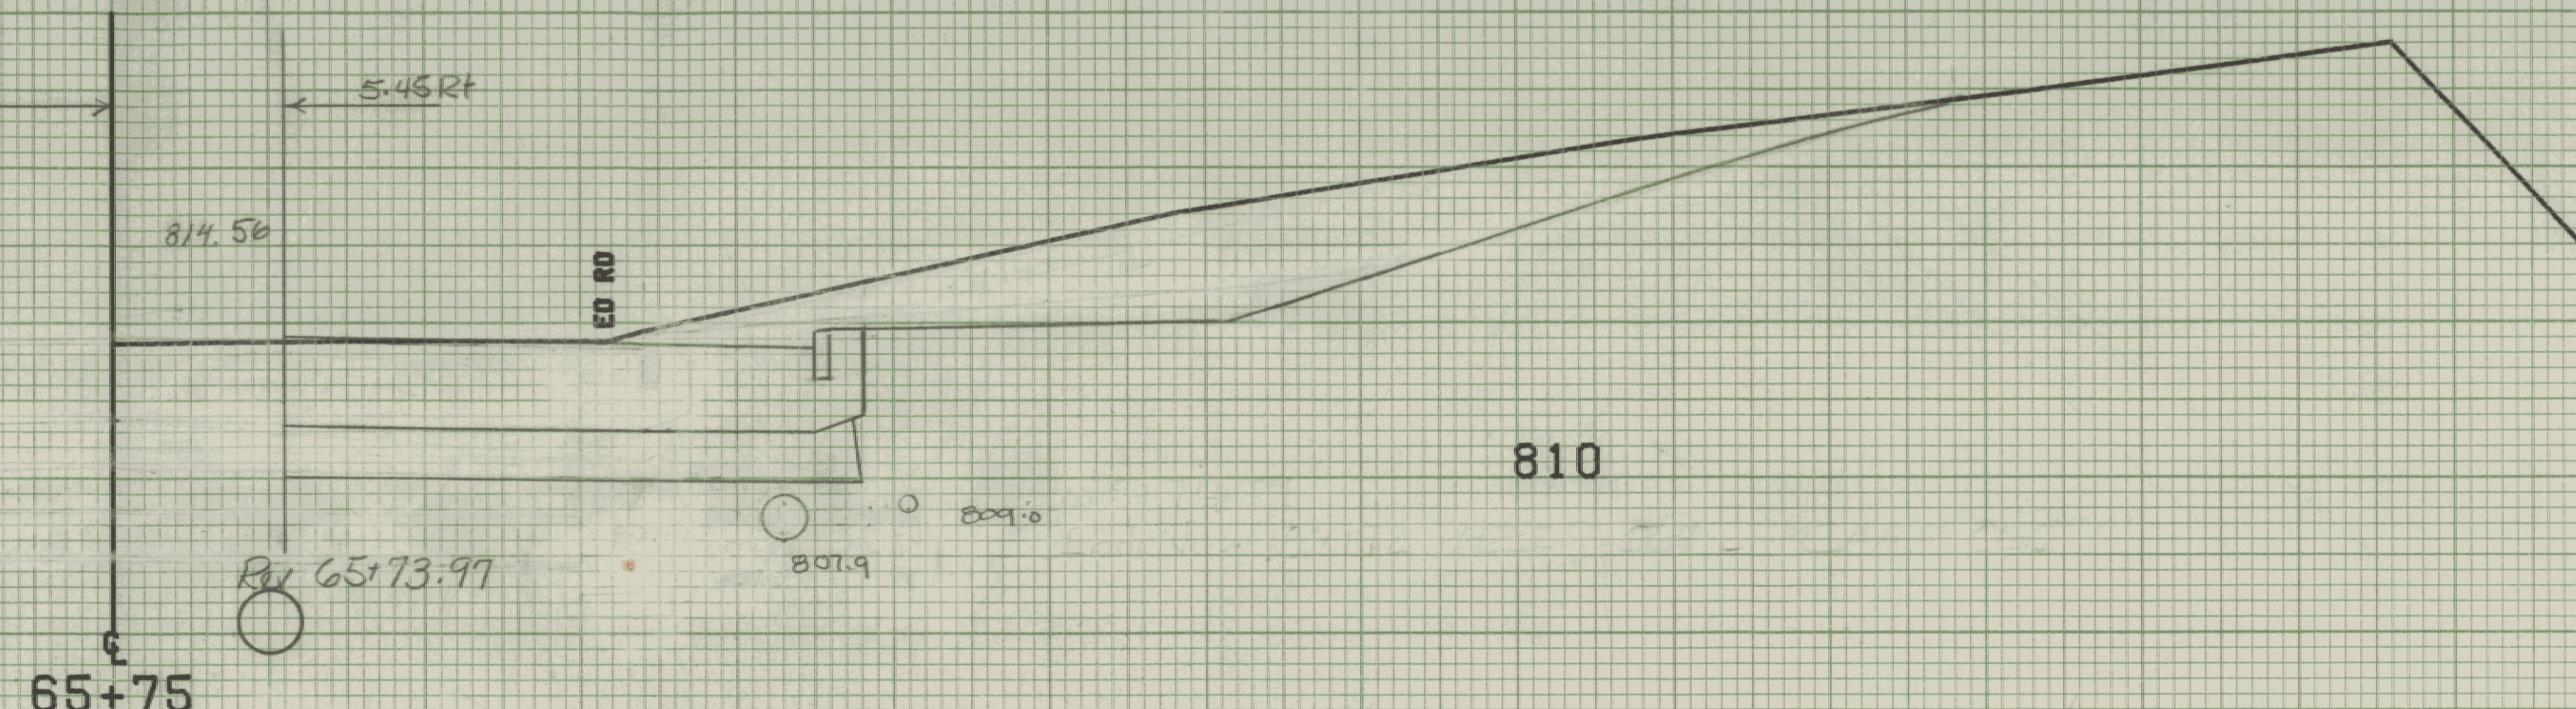


810

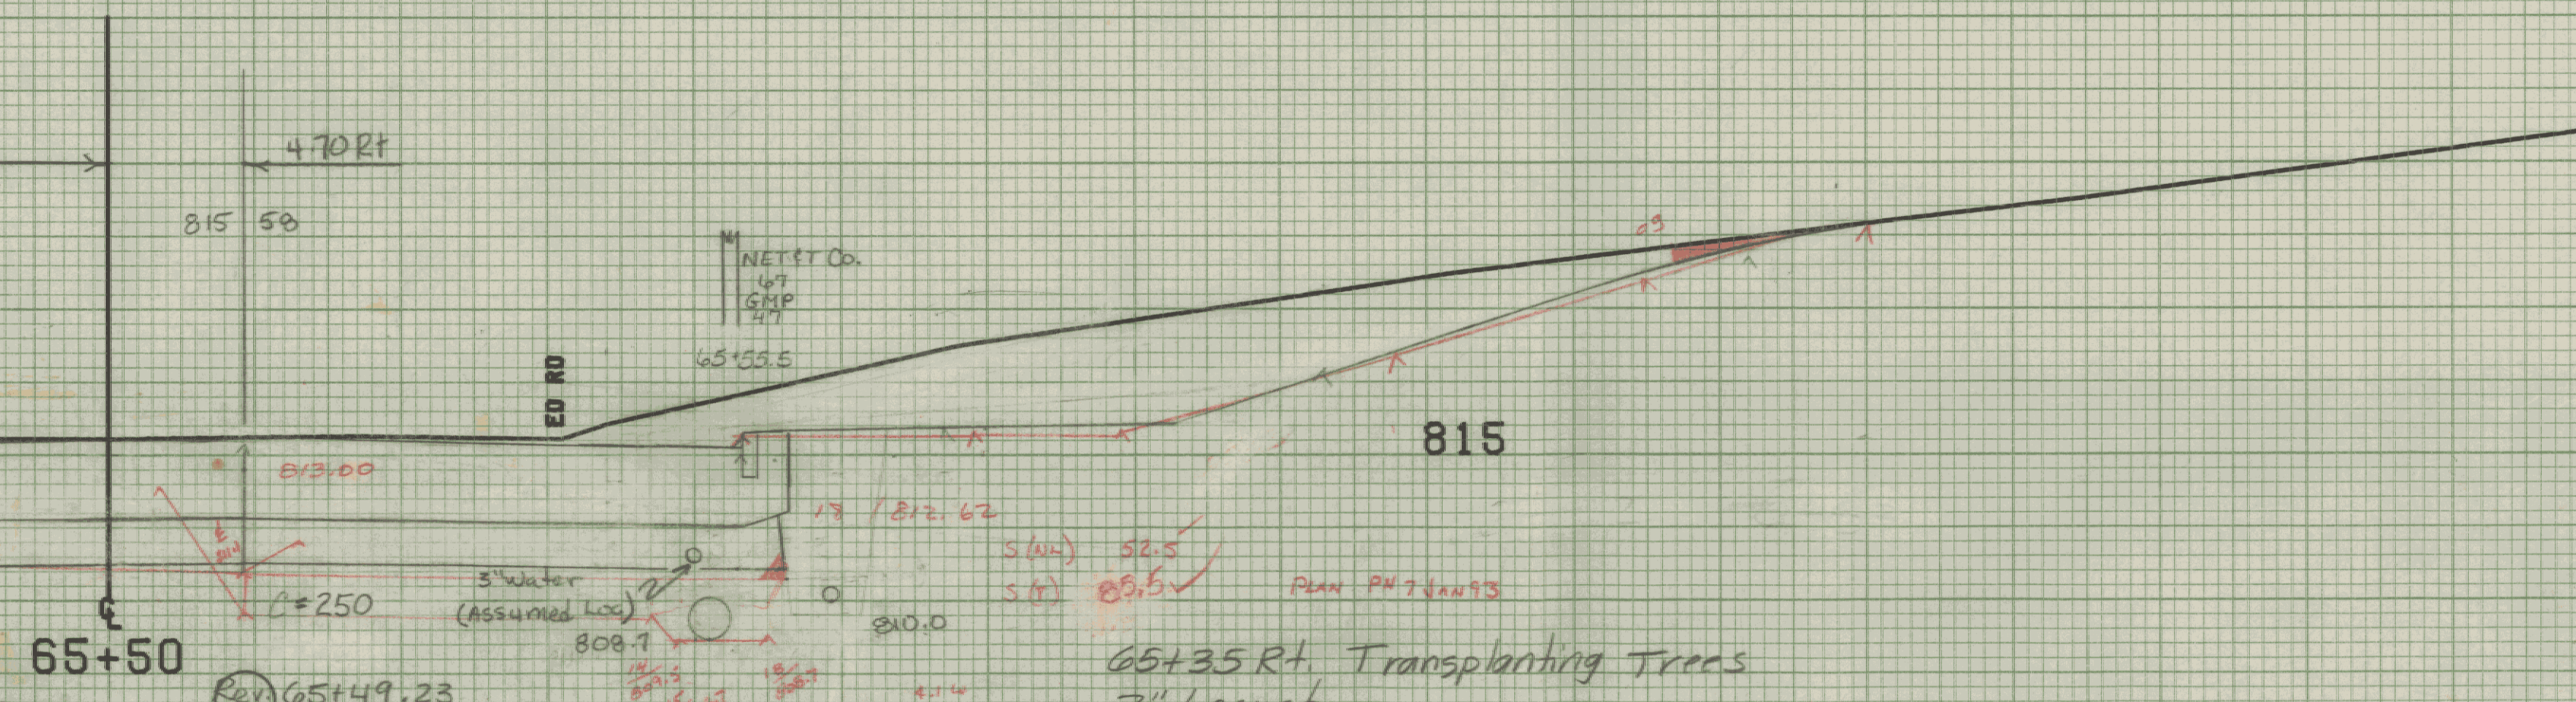

815

65+35 Rt. Transplanting Trees
 2" Locust
 Tree to be Transplanted Outside of the R.O.W. Limits in a
 location which is mutually agreeable with the property
 owner and the resident engineer.

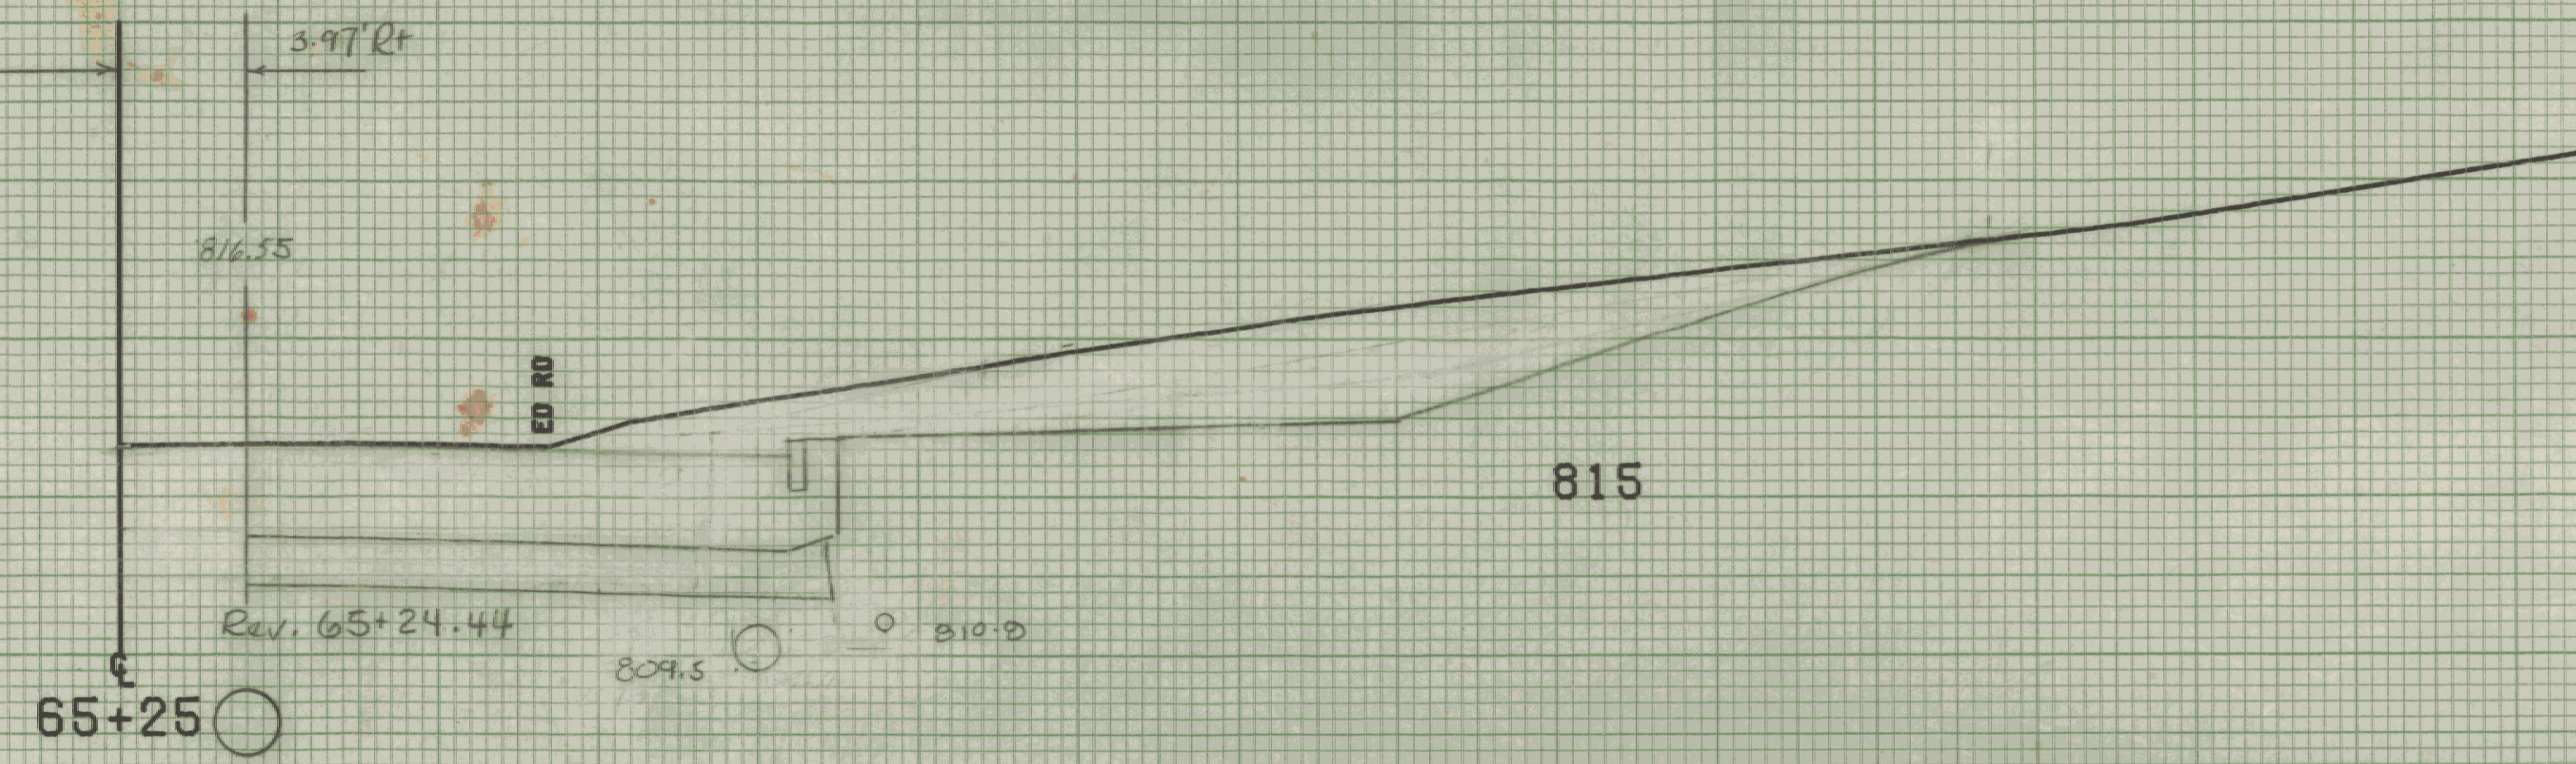

815

FROM STA. 65+25 TO STA. 65+75
 PROJECT NAME MONTPELIER MAIN 7
 NO. M6400(7) PLOTTED 06/07/85
 SURVEYED BY KASTNER-MOREAU JUNE 1985
 SHEET 236 OF 335 SHEETS

SCALE 6 FEET

Plan 8/12/85