
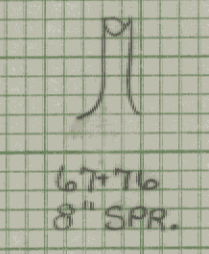


REV. 67+70 LT.
CONSTRUCT DRIVE 24' WIDE (GRAVEL)

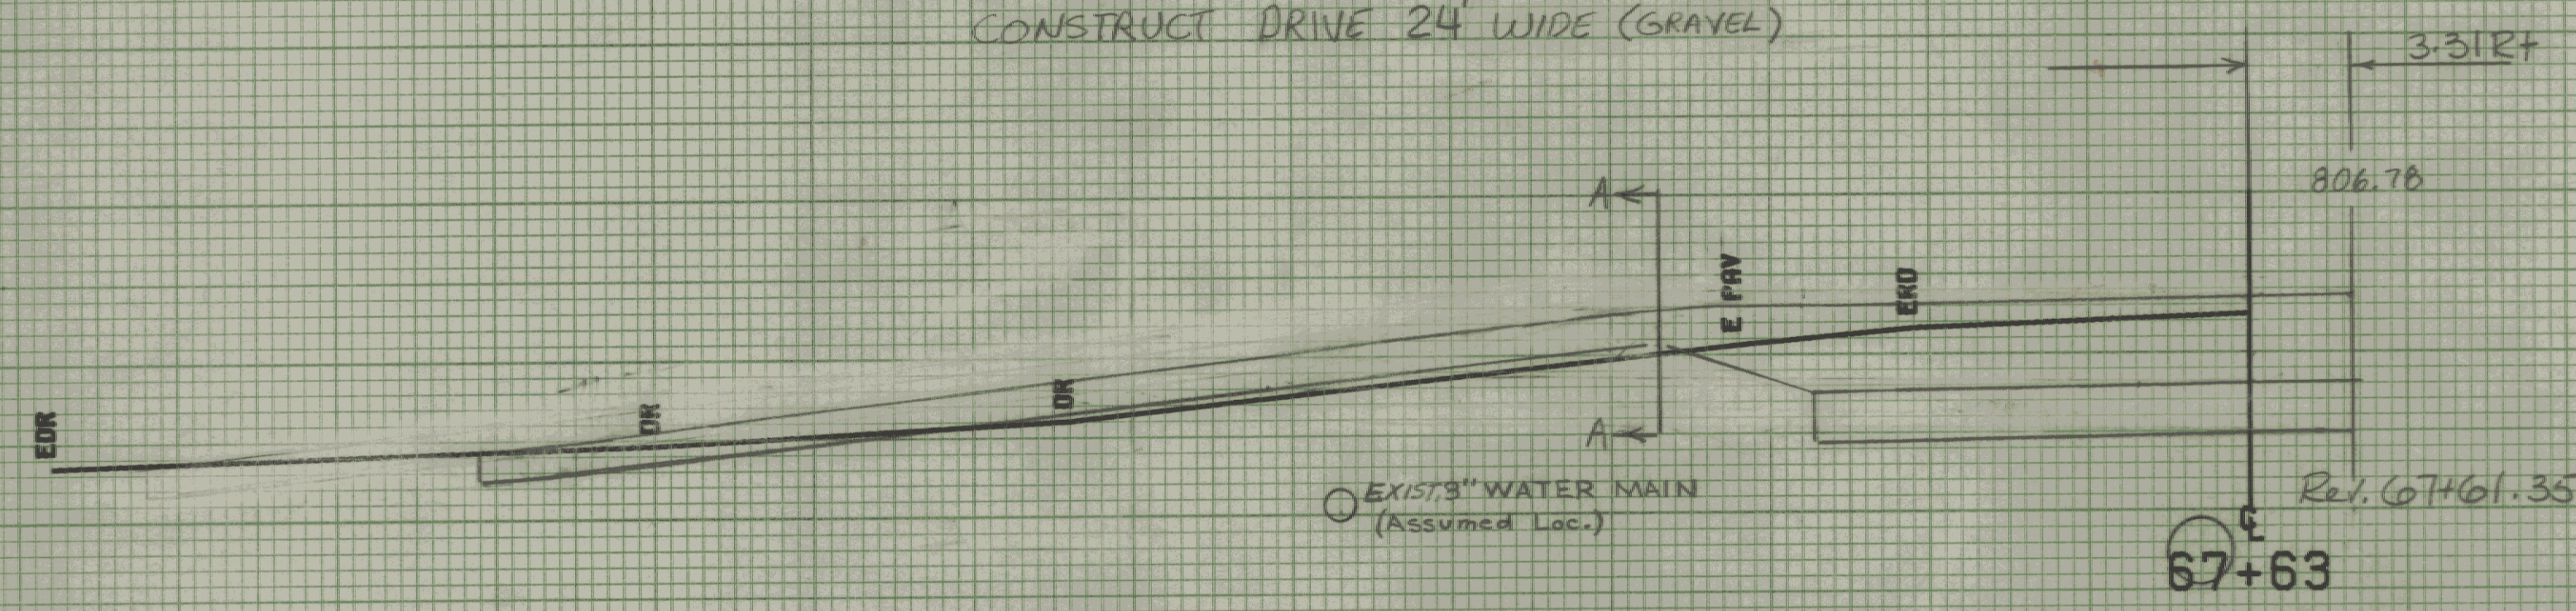

805


67+60 RT
End Vertical Granite Curb

REV. 67+57 LT
End Vertical Granite Curb

REV. 67+58.74
End Project MEGC-M6400(7)
Begin Approach

REV. 67+52 RT ~ 67+94 RT
Relay 40' Existing 18" RCP
Connect to New RCDI @ REV. 69+52 RT

67+53.50 RT
Remove Existing 4' x 4' RCDI

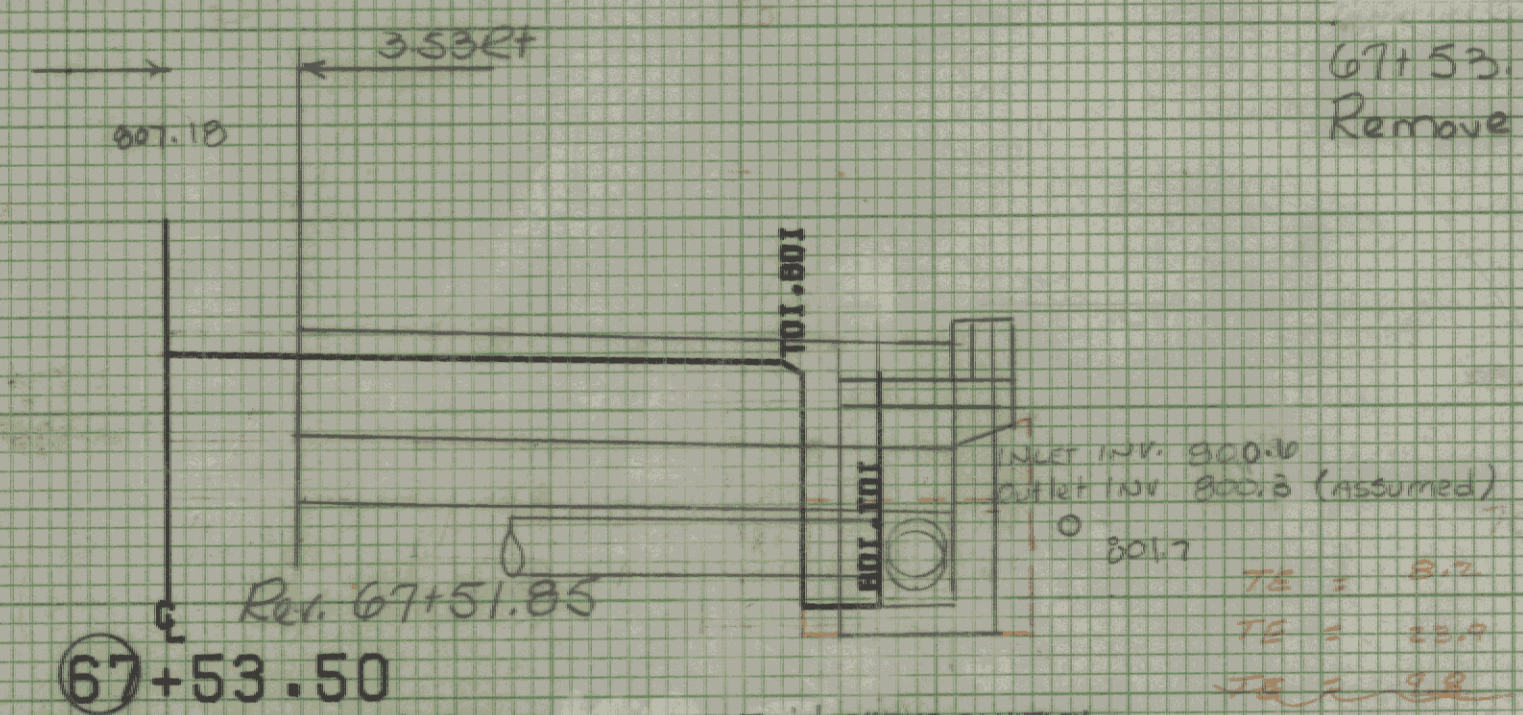


805

Remove Existing 18" x 28" RCP
REV. 67+50 LT ~ 67+52 RT
New 18" x 30" PCCSP.064 or
CAAP.060

REV. 67+52 RT
End 18" x 128" PCCSP.064
or CAAP.060

REV. 67+51.5 LT
Remove Existing RCDI

EXIST. 8" D.I. WATER MAIN (Assumed Loc.)

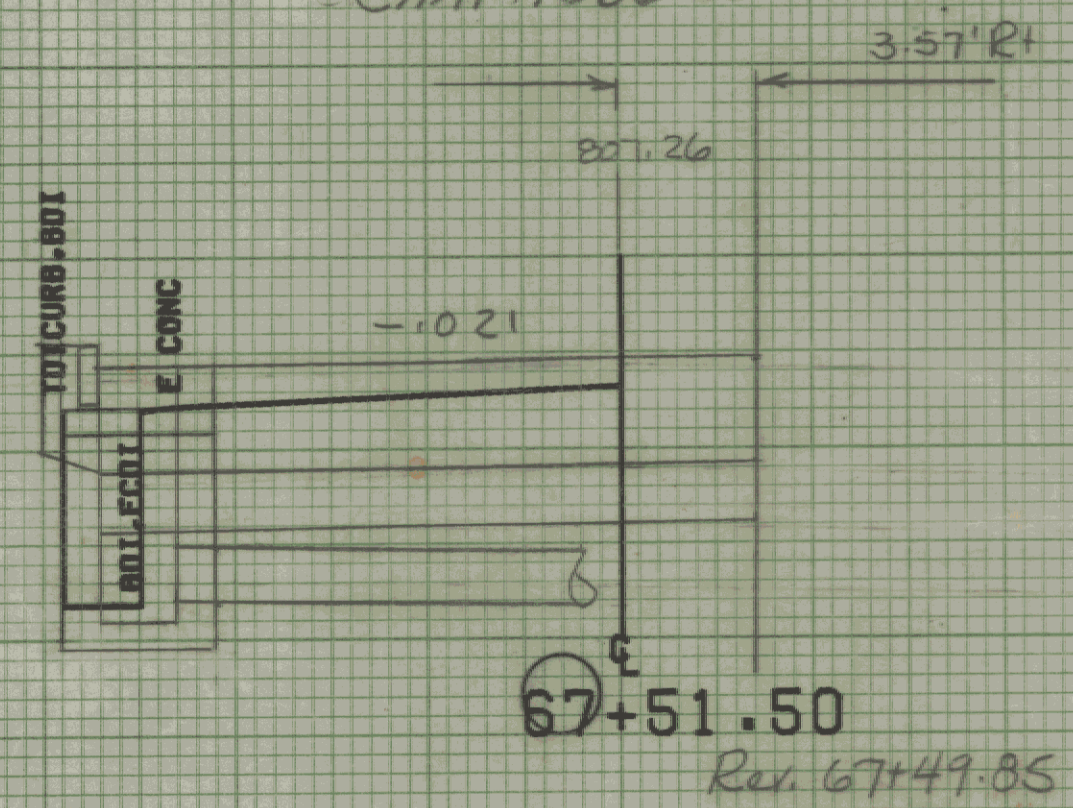

805

REV. 67+49.85