


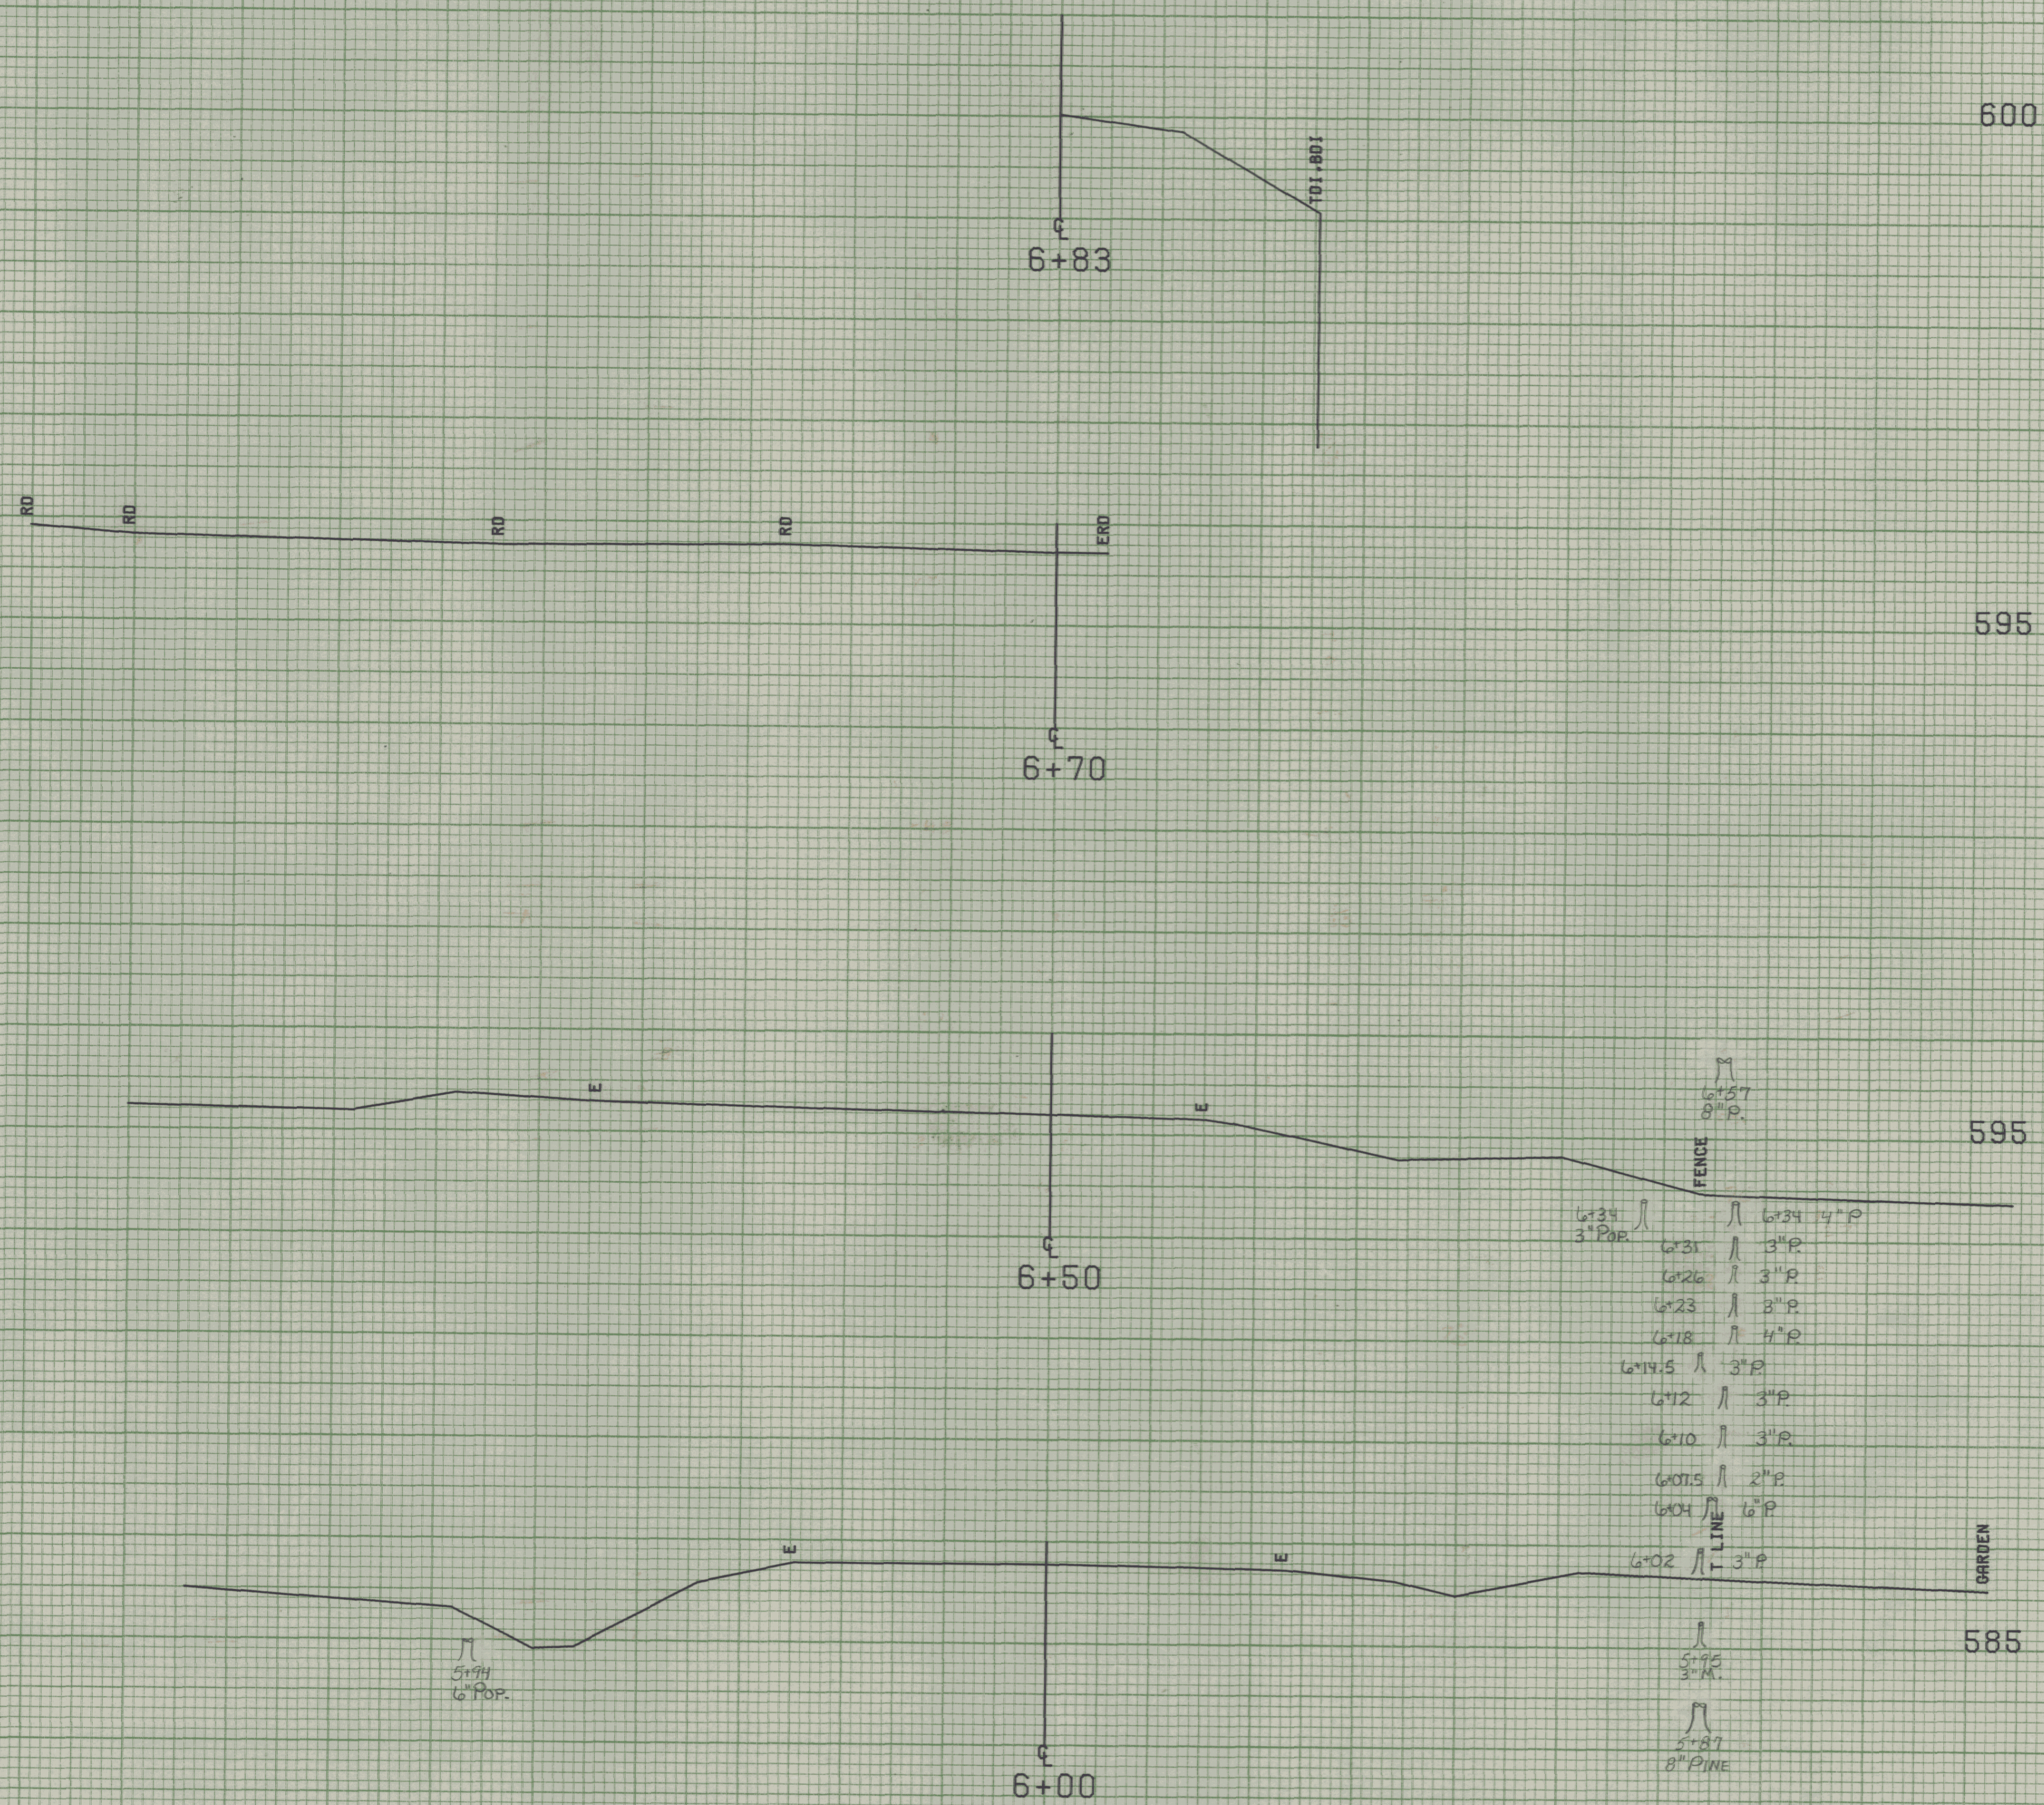

FROM STA. 6+00 TO STA. 6+83
PROJECT NAME MONTPELIER OCTOBER
NO. M6400(7) PLOTTED 08/05/85
SURVEYED BY KASTNER-MOREAU JUNE 1985
SHEET 256 OF 335 SHEETS

SCALE $\overline{\hspace{1.5cm}}$ 5 FEET