


Wilson St. 15+50 RT ~ 16+29+44 RT
New 12'x60' CSP .064 @ CAPP.060

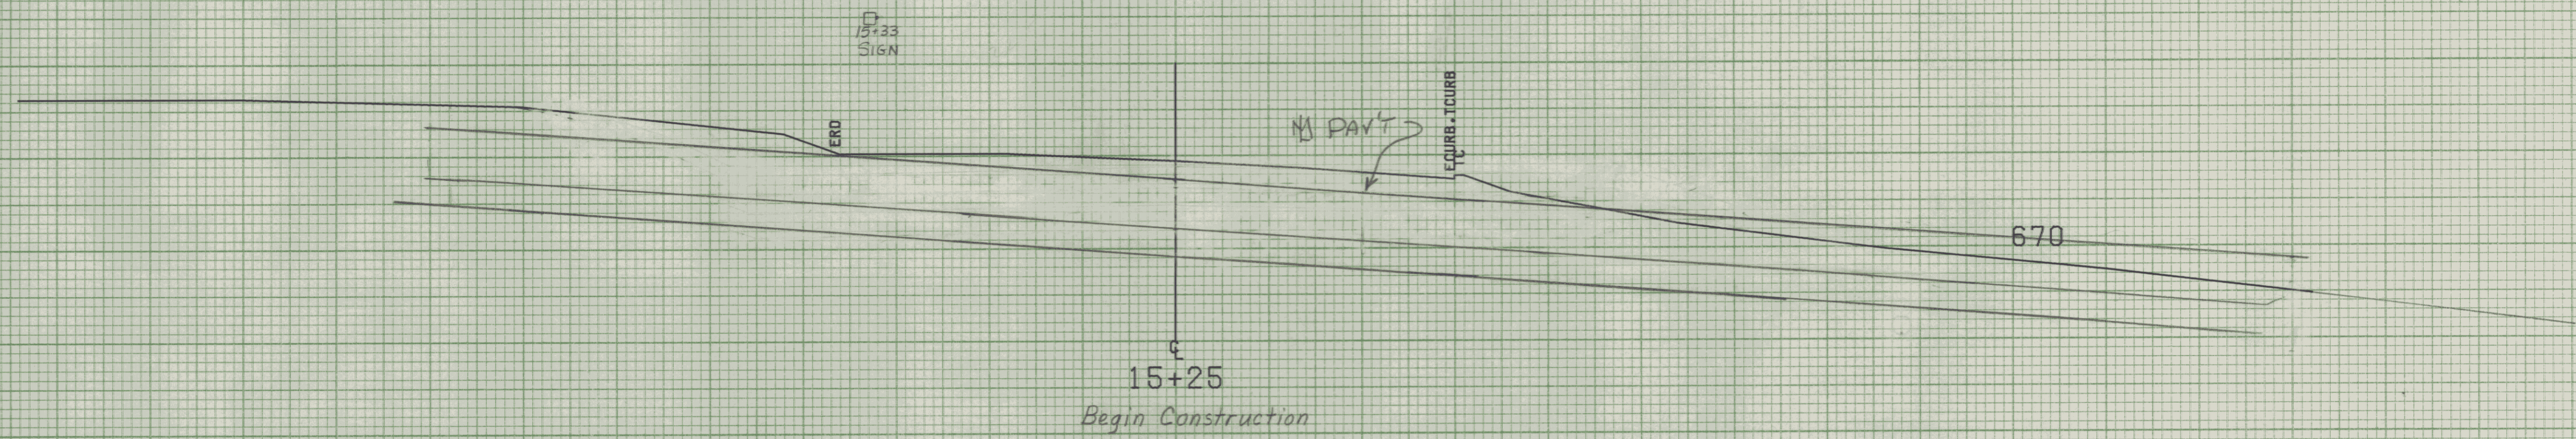

15+25
Begin Construction

LEAD
15+14

15+00

Surv. POST 30+10.22 =
S.L. POT 15+00.00

670

670

670

FROM STA.	15+00	TO STA.	16+25
PROJECT NAME	MONTPELIER WILSON		
NO.	M6400(7)	PLOTTED	08/05/85
SURVEYED BY	KASTNER-MOREAU		JUNE 1985
SHEET	261	OF	335 SHEETS

SCALE 5 FEET