



Wheelock St 25+24 LH
 Existing Sewer Manhole
 w/8" (?) Inlet and 8"
 Clay Pipe Outlet
 Retain Existing Pipes
 and Adjust Elev. of
 Manhole Non-Gov't. Part.

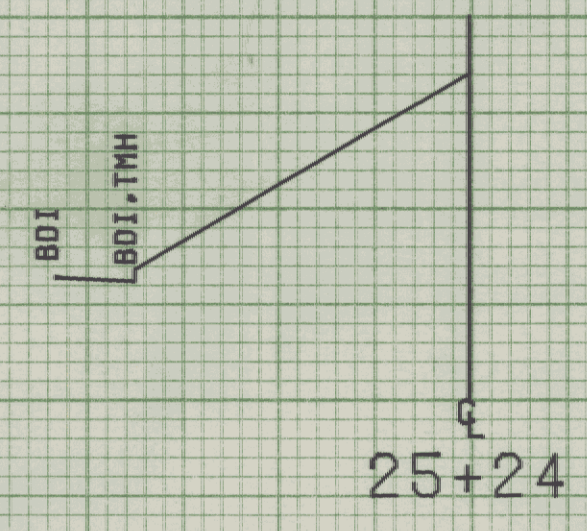

25+12
 Begin Construction

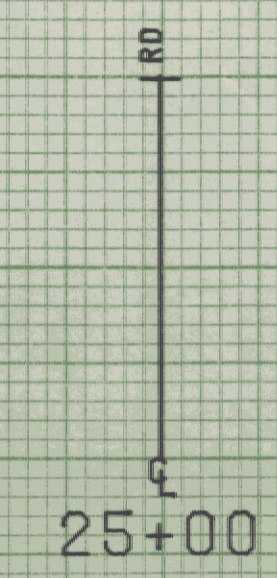

M.L. POT 41+57.15=
 S.L. POT 25+00.00

740

740

740

FROM STA.	25+00	TO STA.	25+25
PROJECT NAME	MONTPELIER WHEELOCK		
NO.	M6400(7)	PLOTTED	08/05/85
SURVEYED BY	KASTNER-MOREAU JUNE 1985		
SHEET	267	OF	335 SHEETS

SCALE 5 FEET