
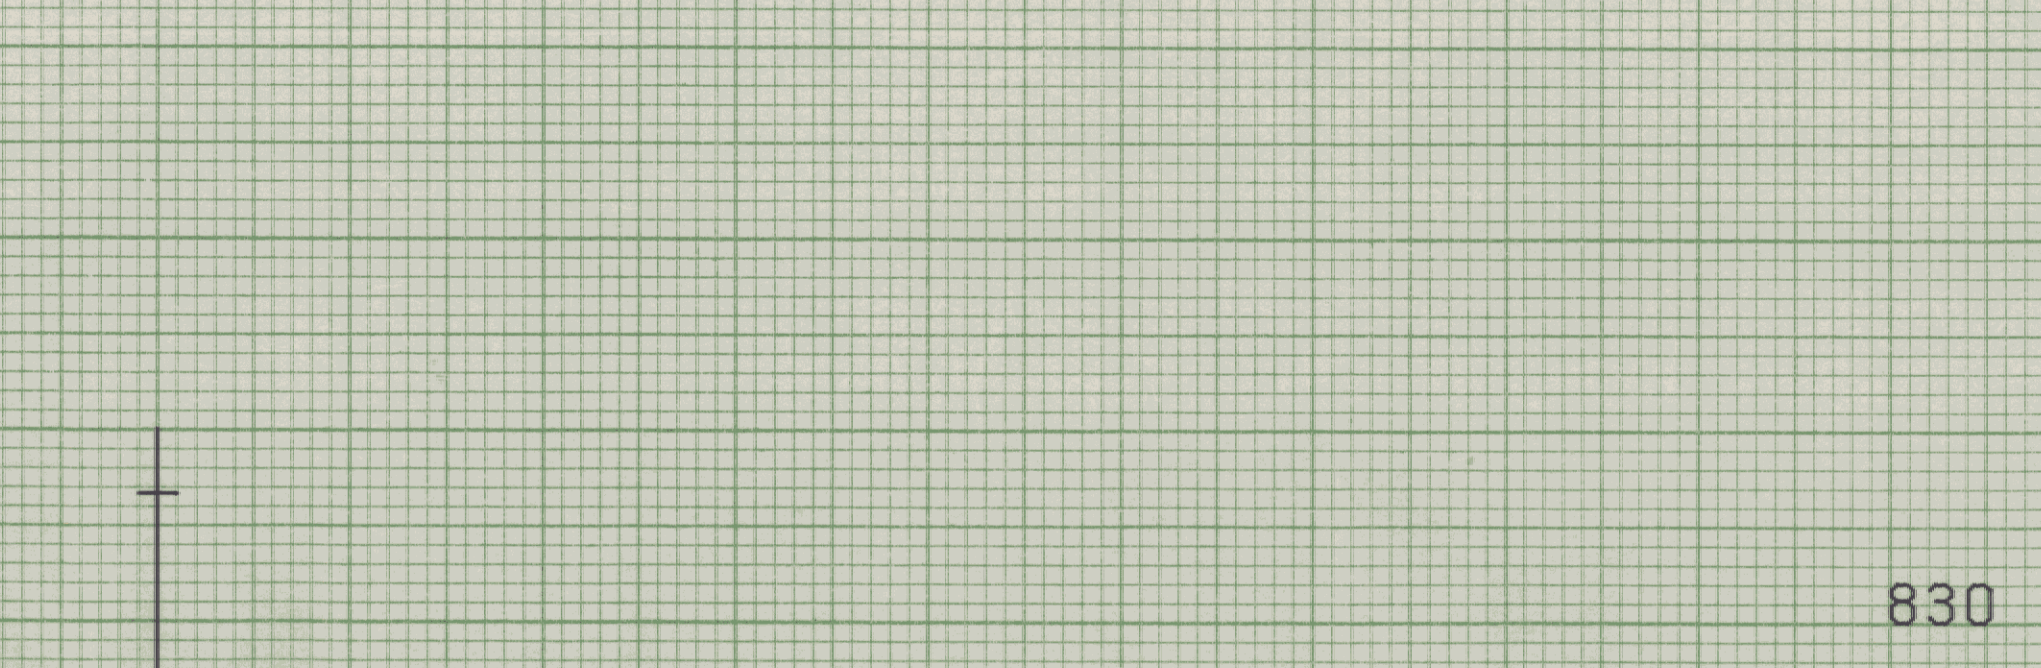


35+12
Begin Construction

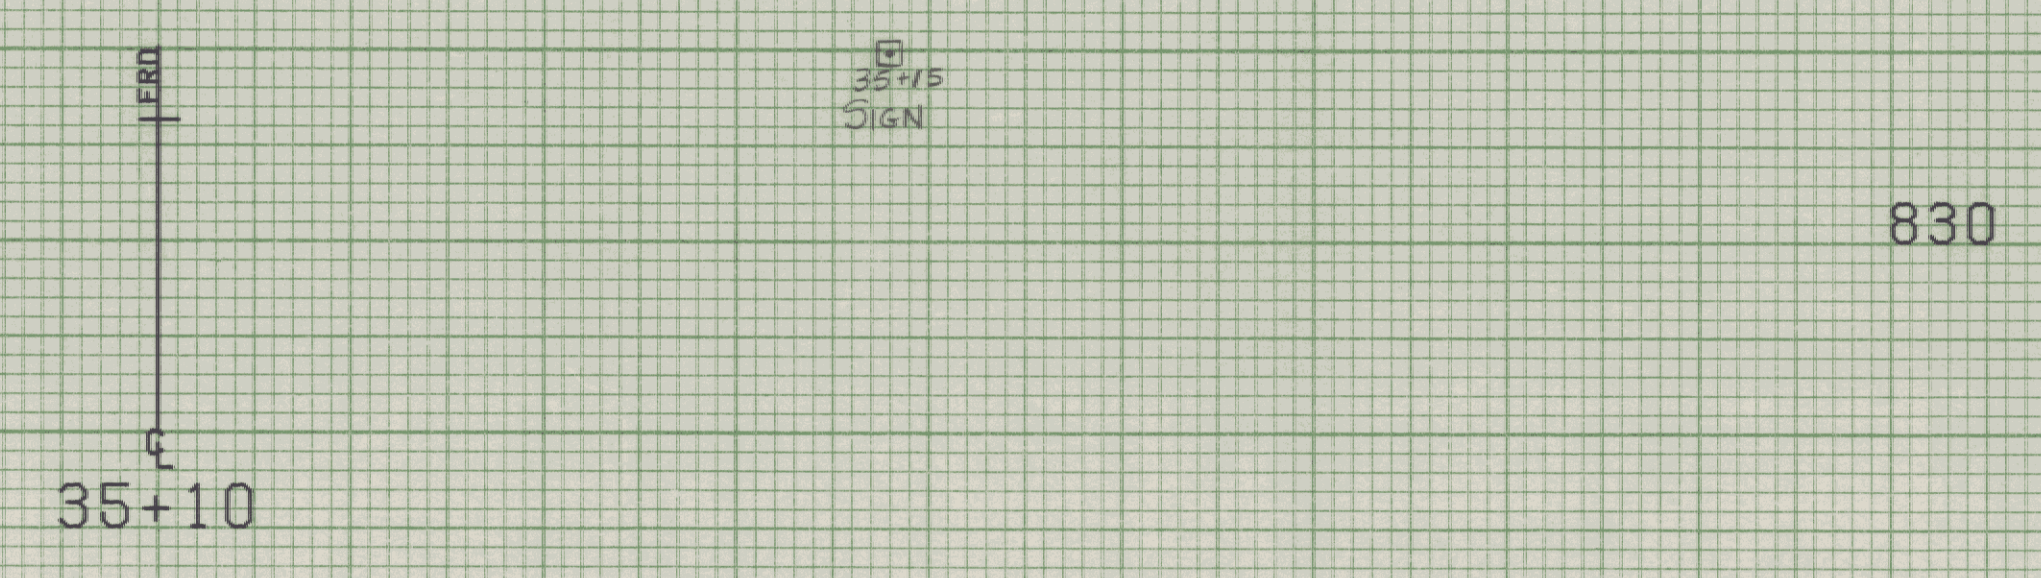

M.L.P.I. 54+51.70 =
S.L.POT 35+00.00

FROM STA. 36+00 TO STA. 35+50
 PROJECT NAME MONTPELIER HEBERT
 NO. M6400(7) PLOTTED 08/05/85
 SURVEYED BY KASTNER-MOREAU JUNE 1985
 SHEET 273 OF 335 SHEETS

SCALE 5 FEET