


DATE	
BY	
REVIEWED	
NOTED	
NO.	


DATE	
BY	
REVIEWED	
NOTED	
NO.	

DATE	
BY	
REVIEWED	
NOTED	
NO.	

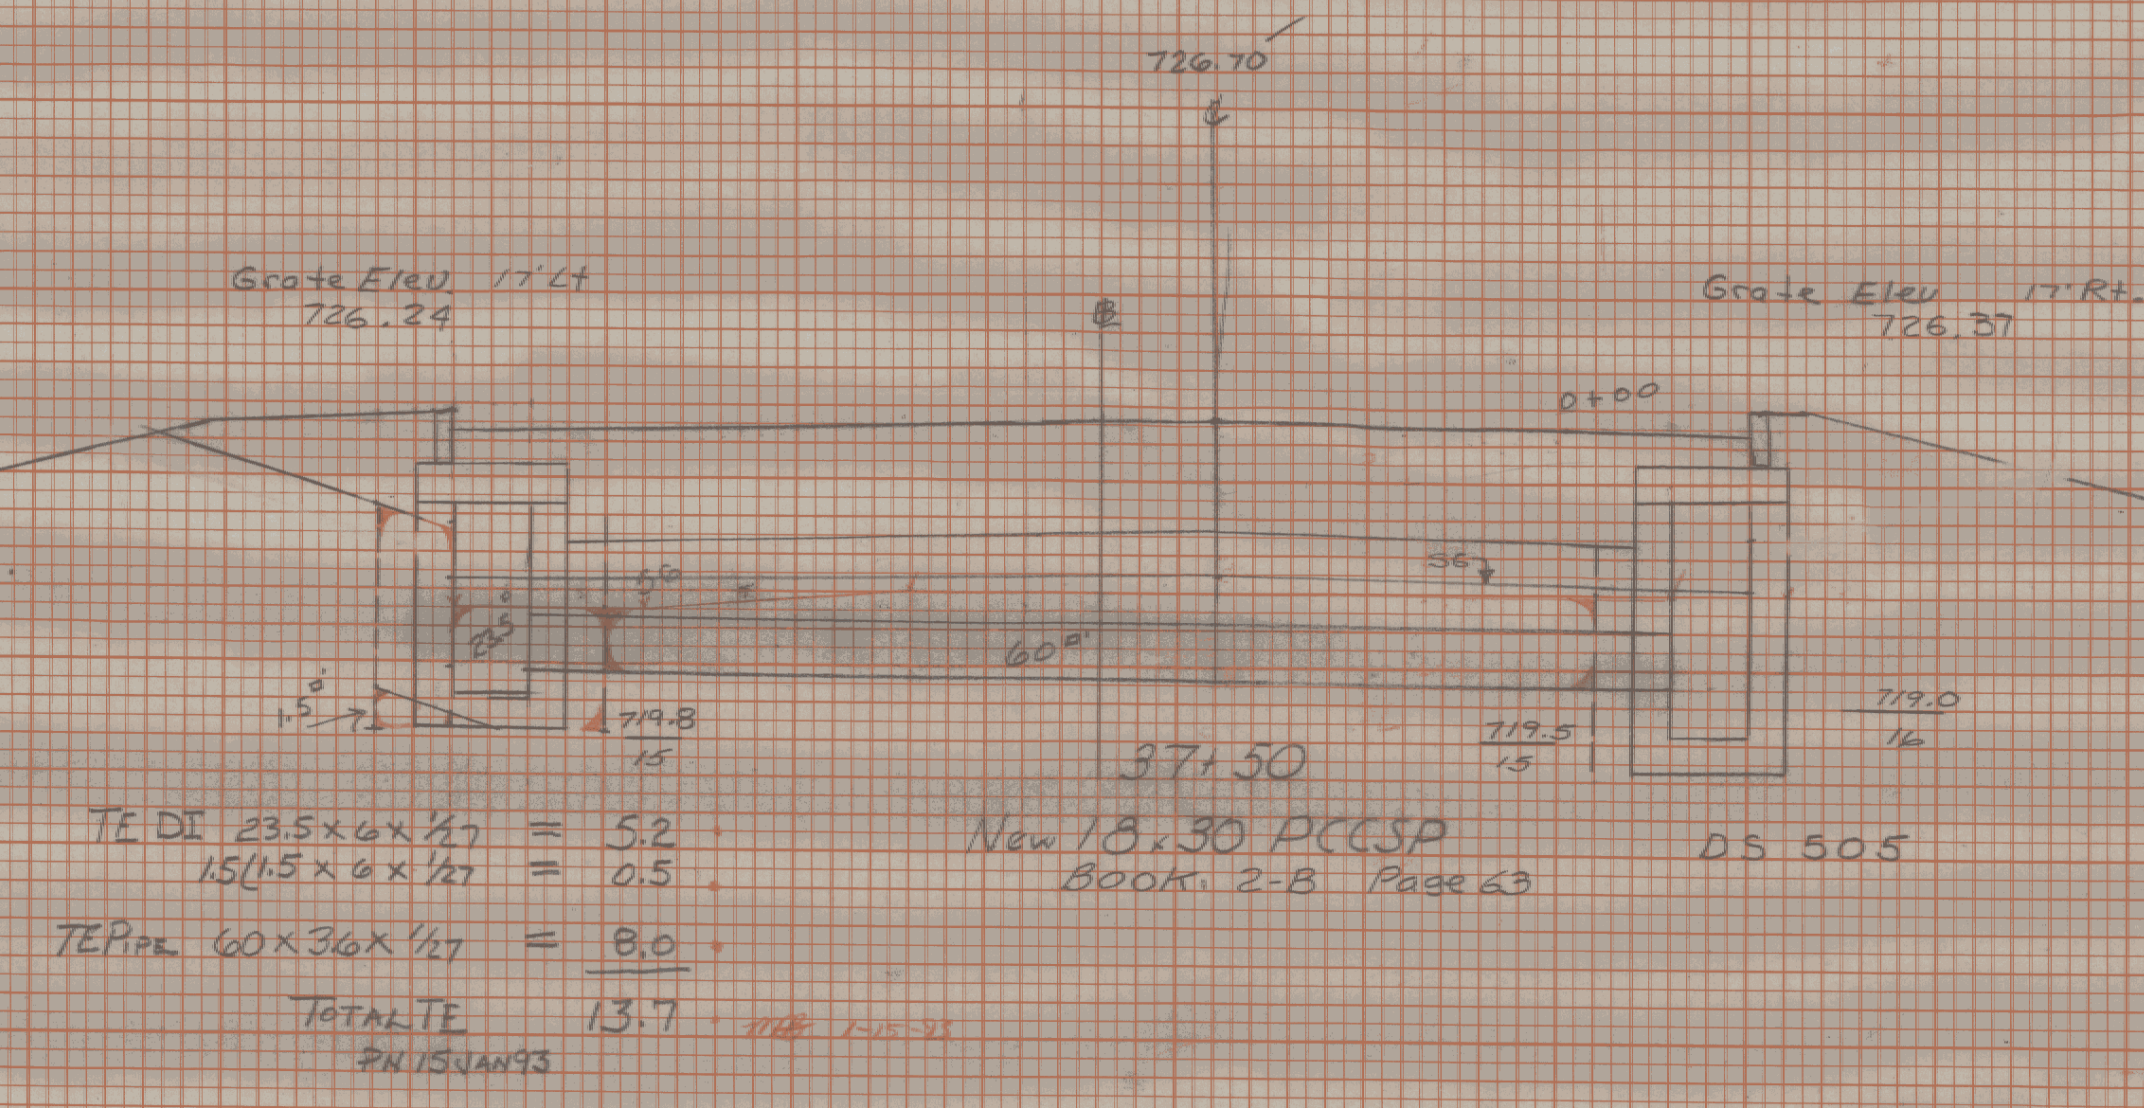


0+00	9.54	
0+10	10.26	3.67
0+20	9.00	5.71
0+30	24.3	3.56
0+40	23.7	
0+50	34.5	
0+60	34.5	2.72

15.46
 FS 10-20-92

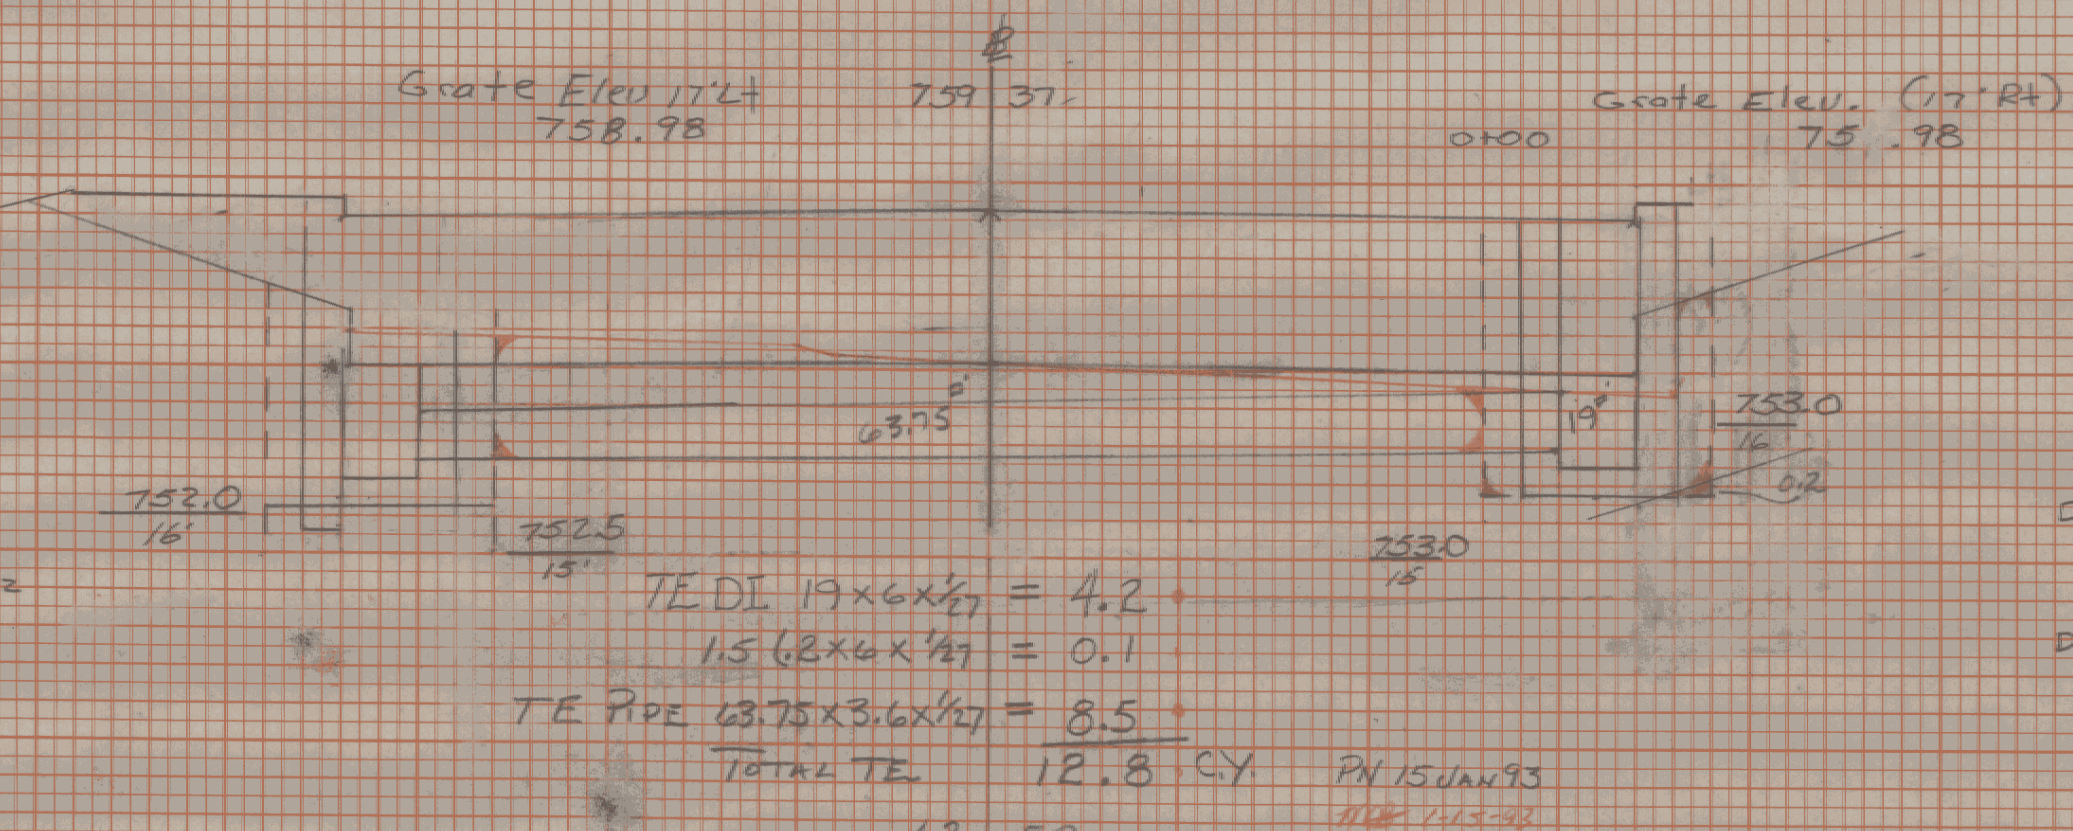


0+00	7.54	3.94
0+10	8.82	
0+20	9.54	4.42
0+30	22.8	
0+40	23.1	3.40
0+50	31.8	
0+60	31.0	2.67

14.38 CY
 FS 10-20-92

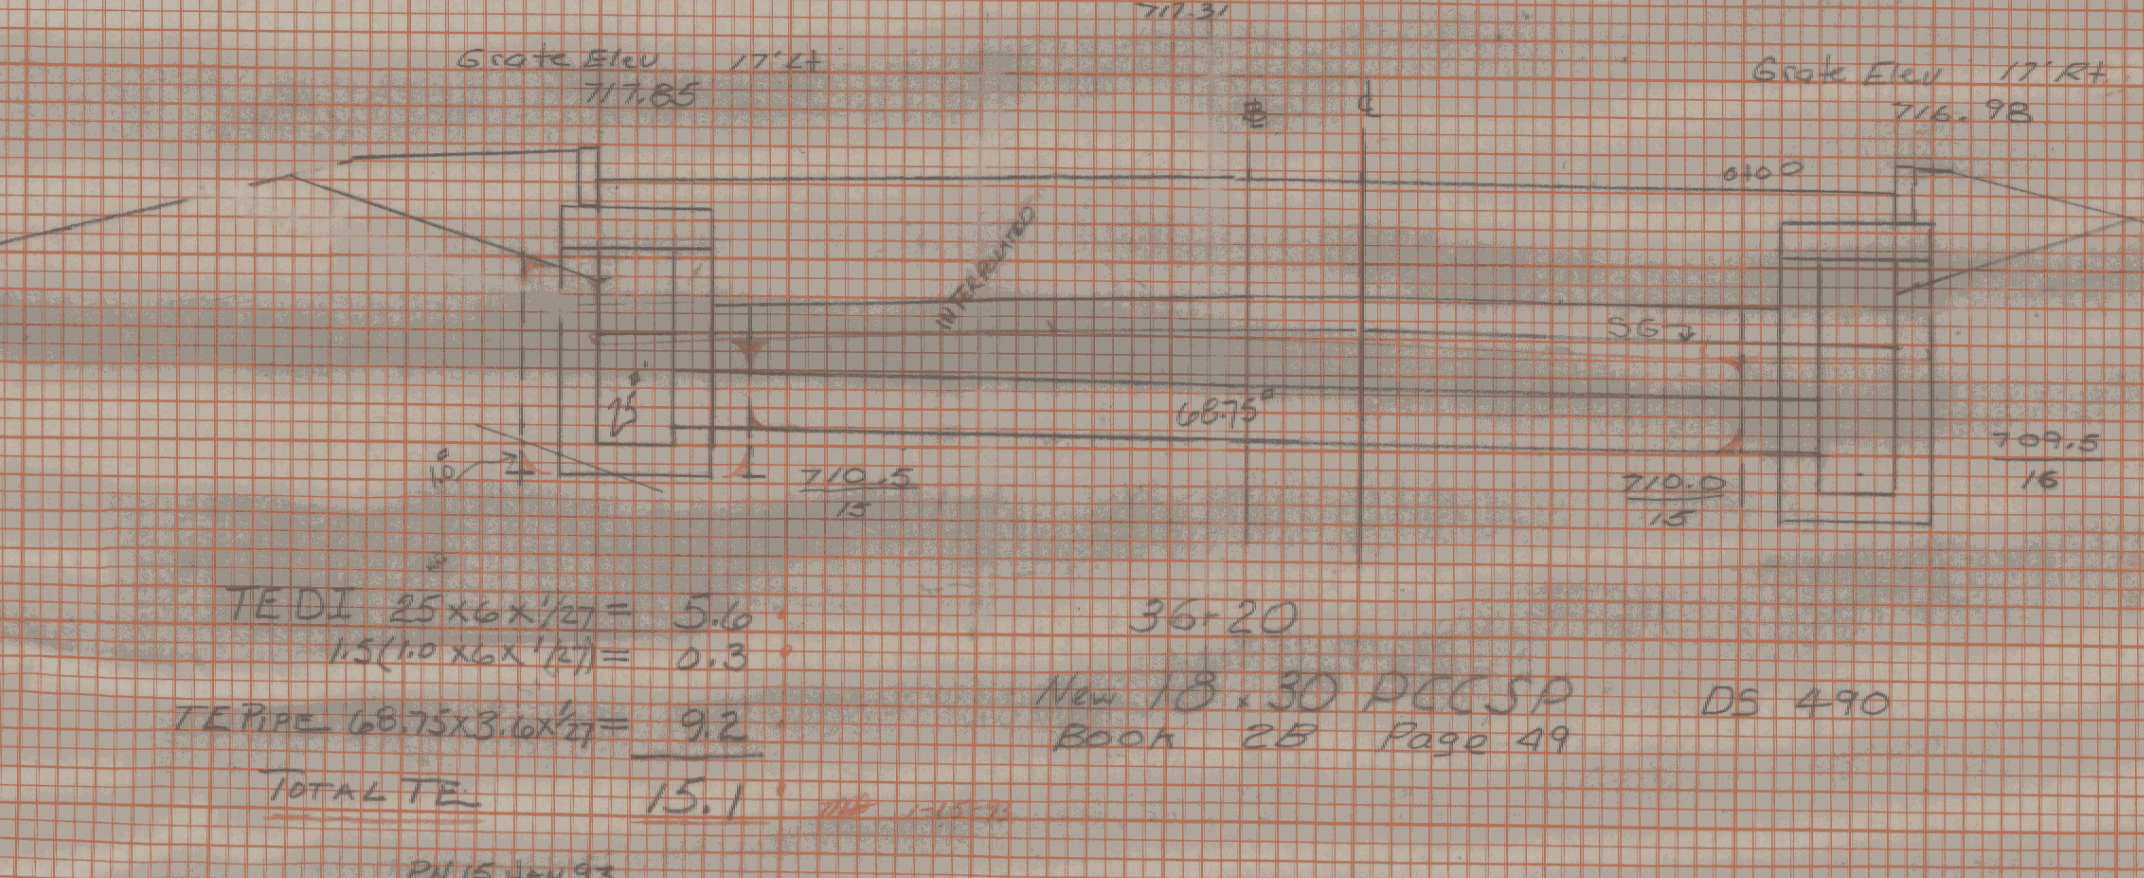


0+00	10.80	
0+10	11.00	4.04
0+20	9.00	5.93
0+30	22.8	1.68
0+40	22.50	
0+50	31.8	
0+60	37.2	5.11

16.76
 FS 10-20-92

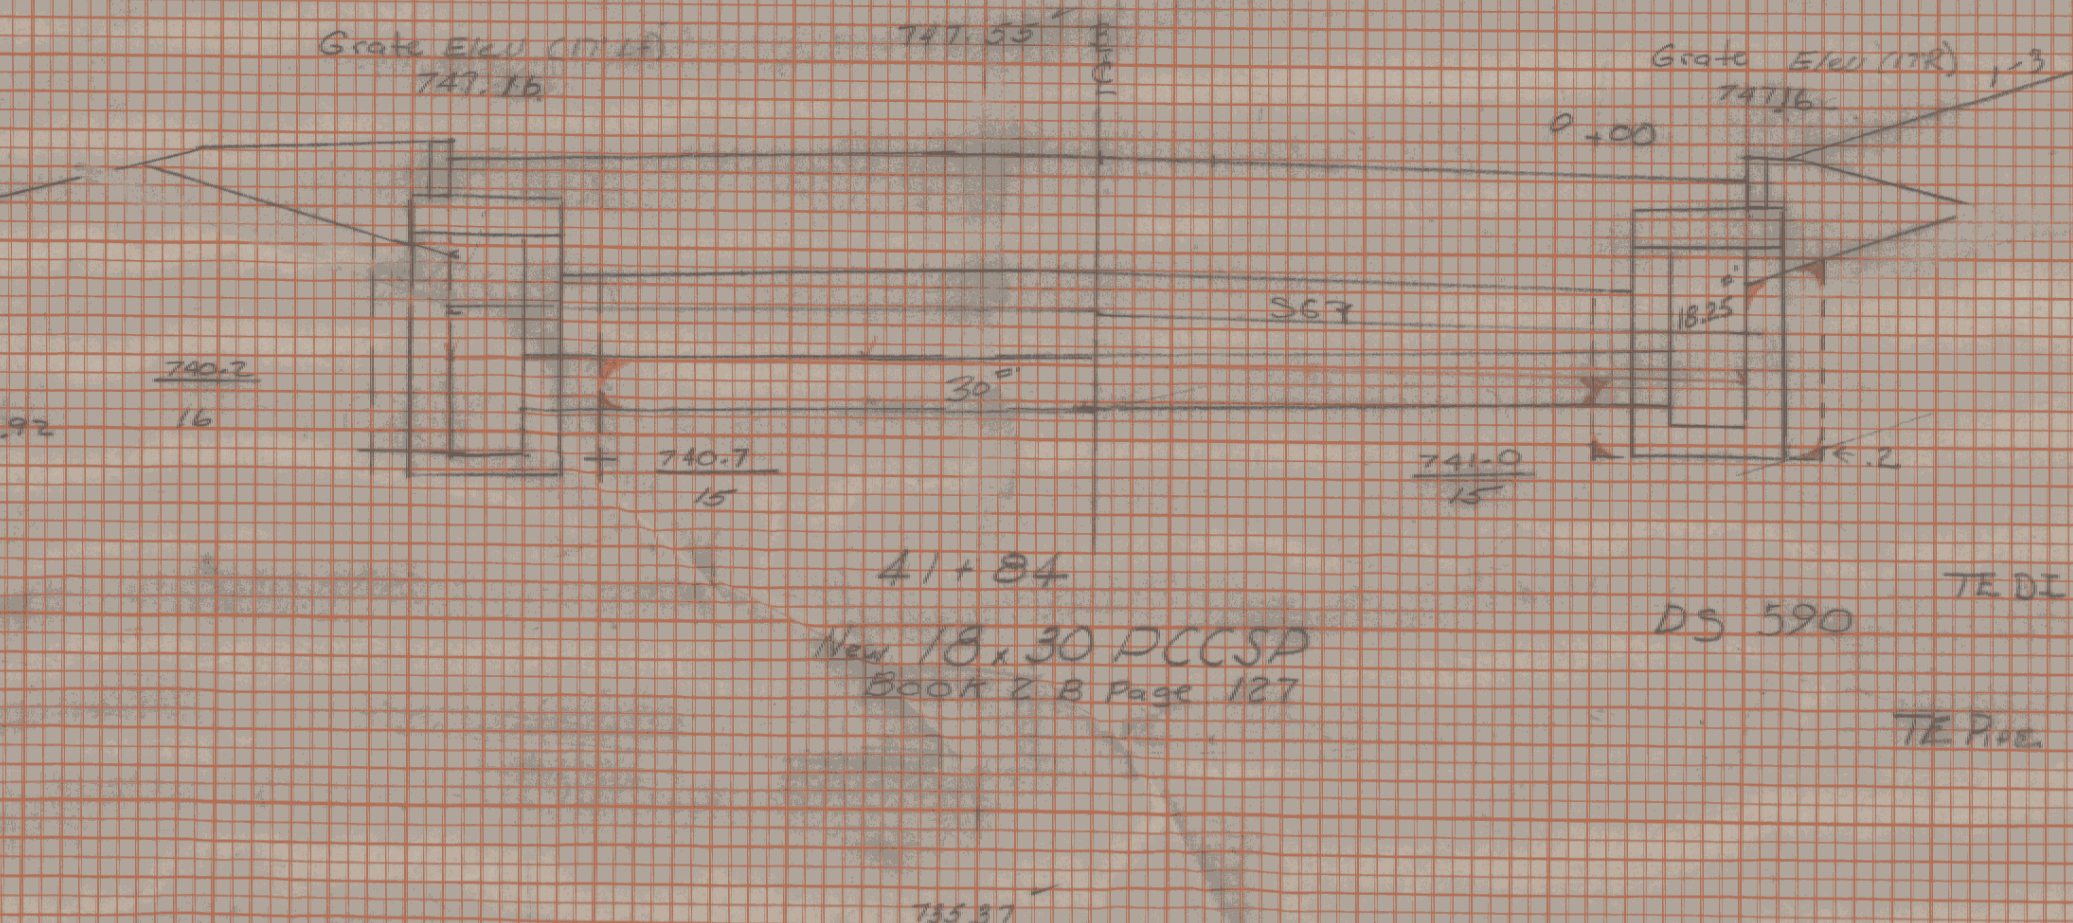


0+00	7.20	2.93
0+10	8.64	5.39
0+20	9.54	
0+30	22.80	
0+40	22.70	4.11
0+50	36.20	2.54

14.99 CY
 FS 10-20-92

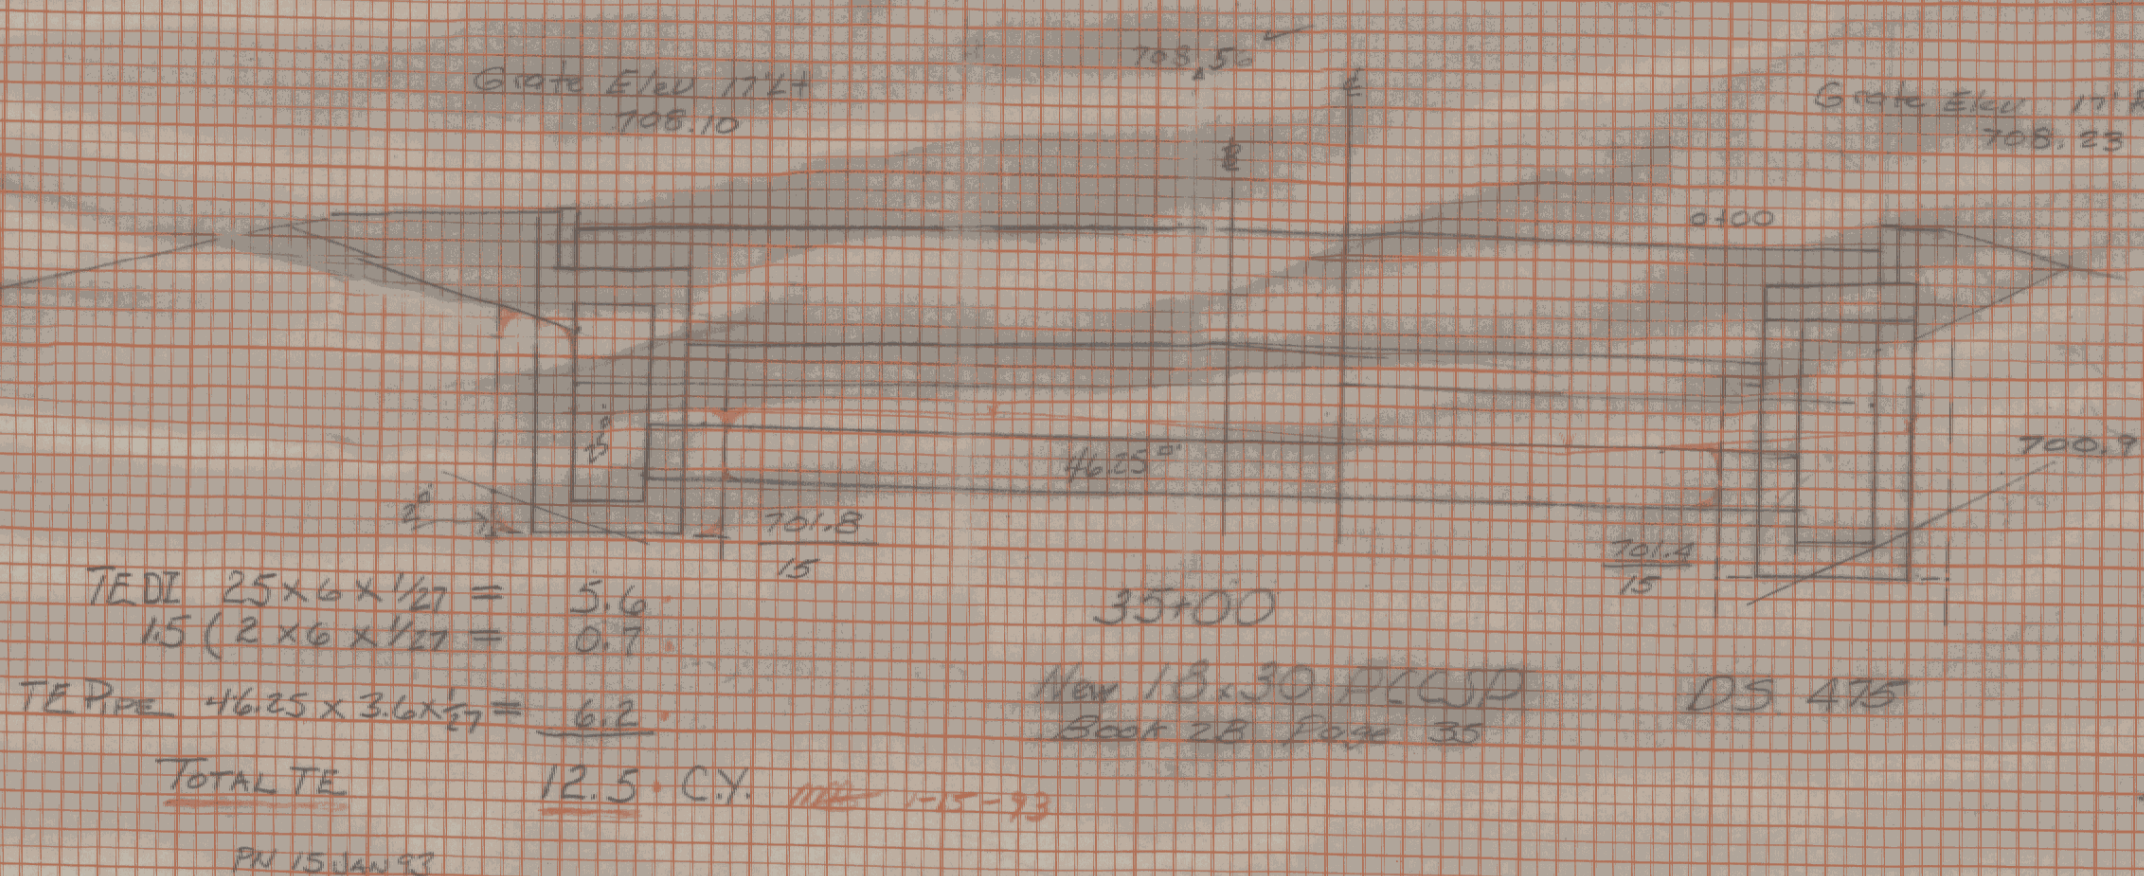

0+00	10.8	4.00
0+10	10.8	6.03
0+20	9.54	
0+30	24.0	
0+40	24.0	3.26
0+50	29.0	
0+60	30.3	2.59

16.76
 FS 10-20-92

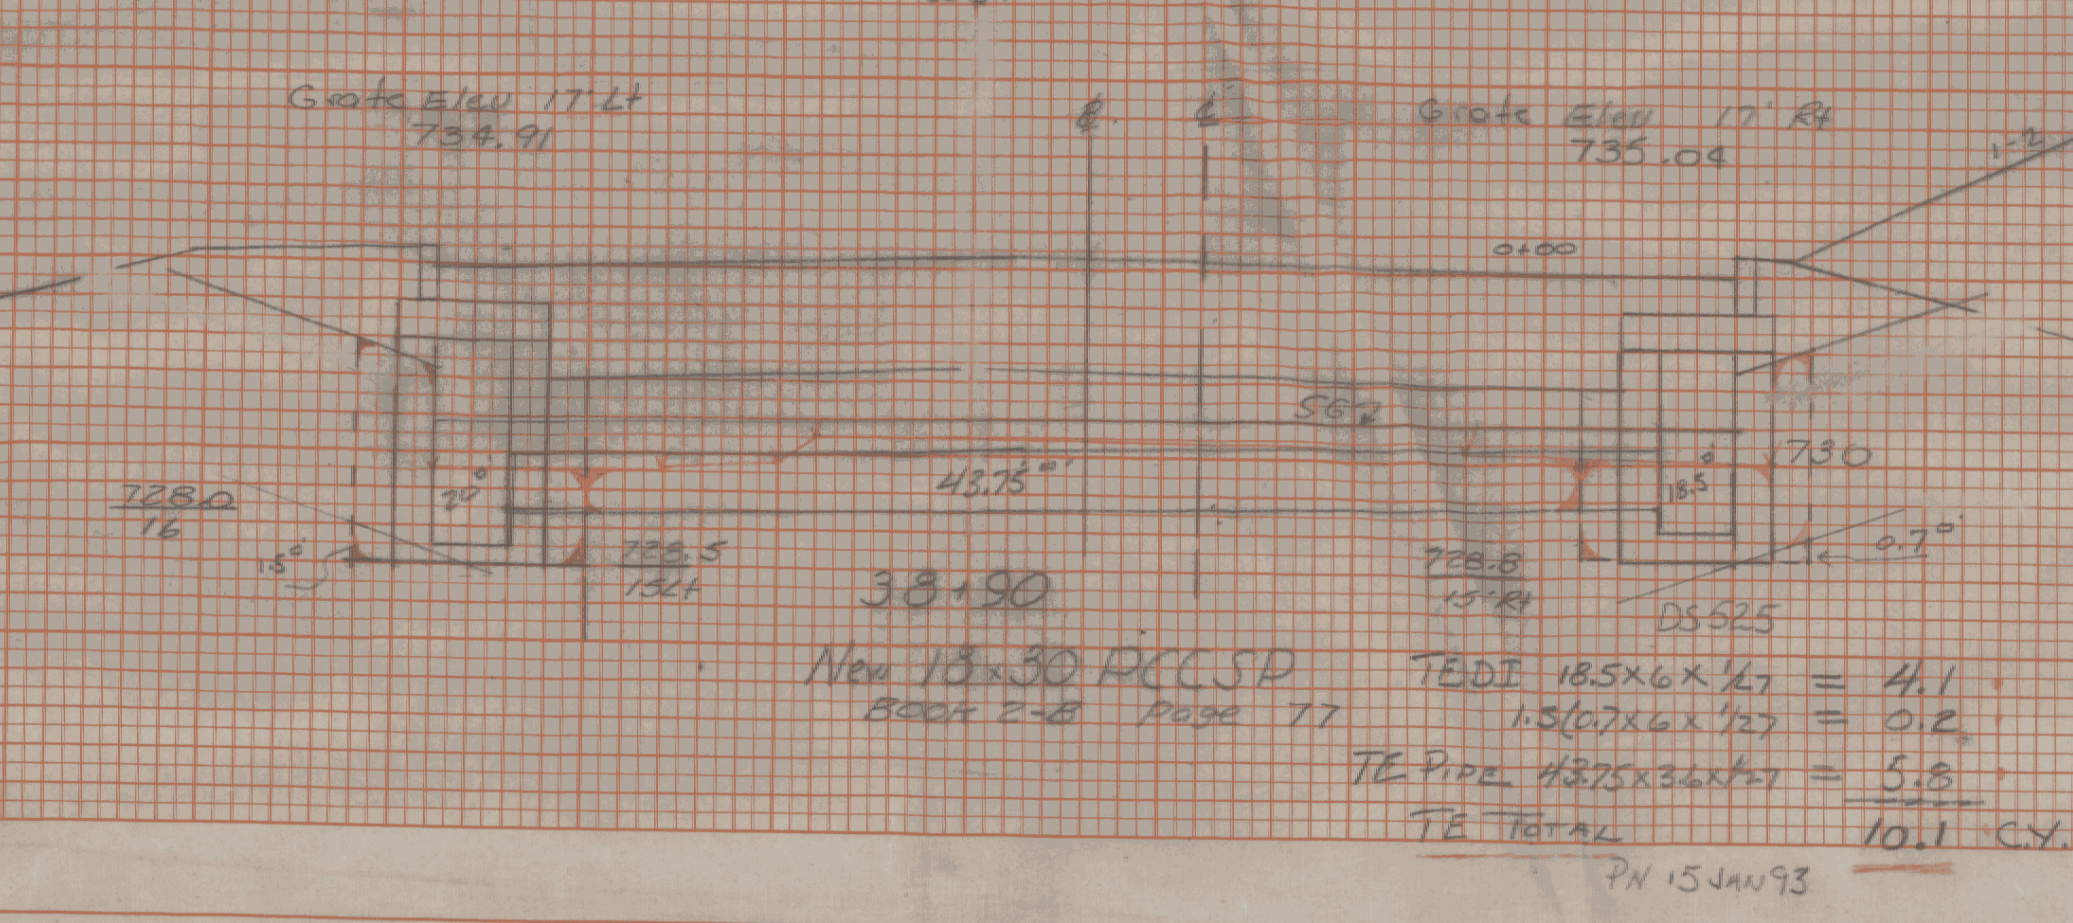

0+00	7.92	3.07
0+10	8.64	5.22
0+20	9.00	
0+30	22.8	3.33
0+40	22.2	
0+50	21.8	2.84

14.46 CY
 FS 10-20-92