


DATE	
BY	
REVIEWED	
PLOTTED	
TEMPLATE	
AREA CHECKED	
FINAL SURVEY NOTE BOOK No.	

DATE	
BY	
REVIEWED	
PLOTTED	
TEMPLATE	
AREA CHECKED	
ORIGINAL SURVEY NOTE BOOK No.	

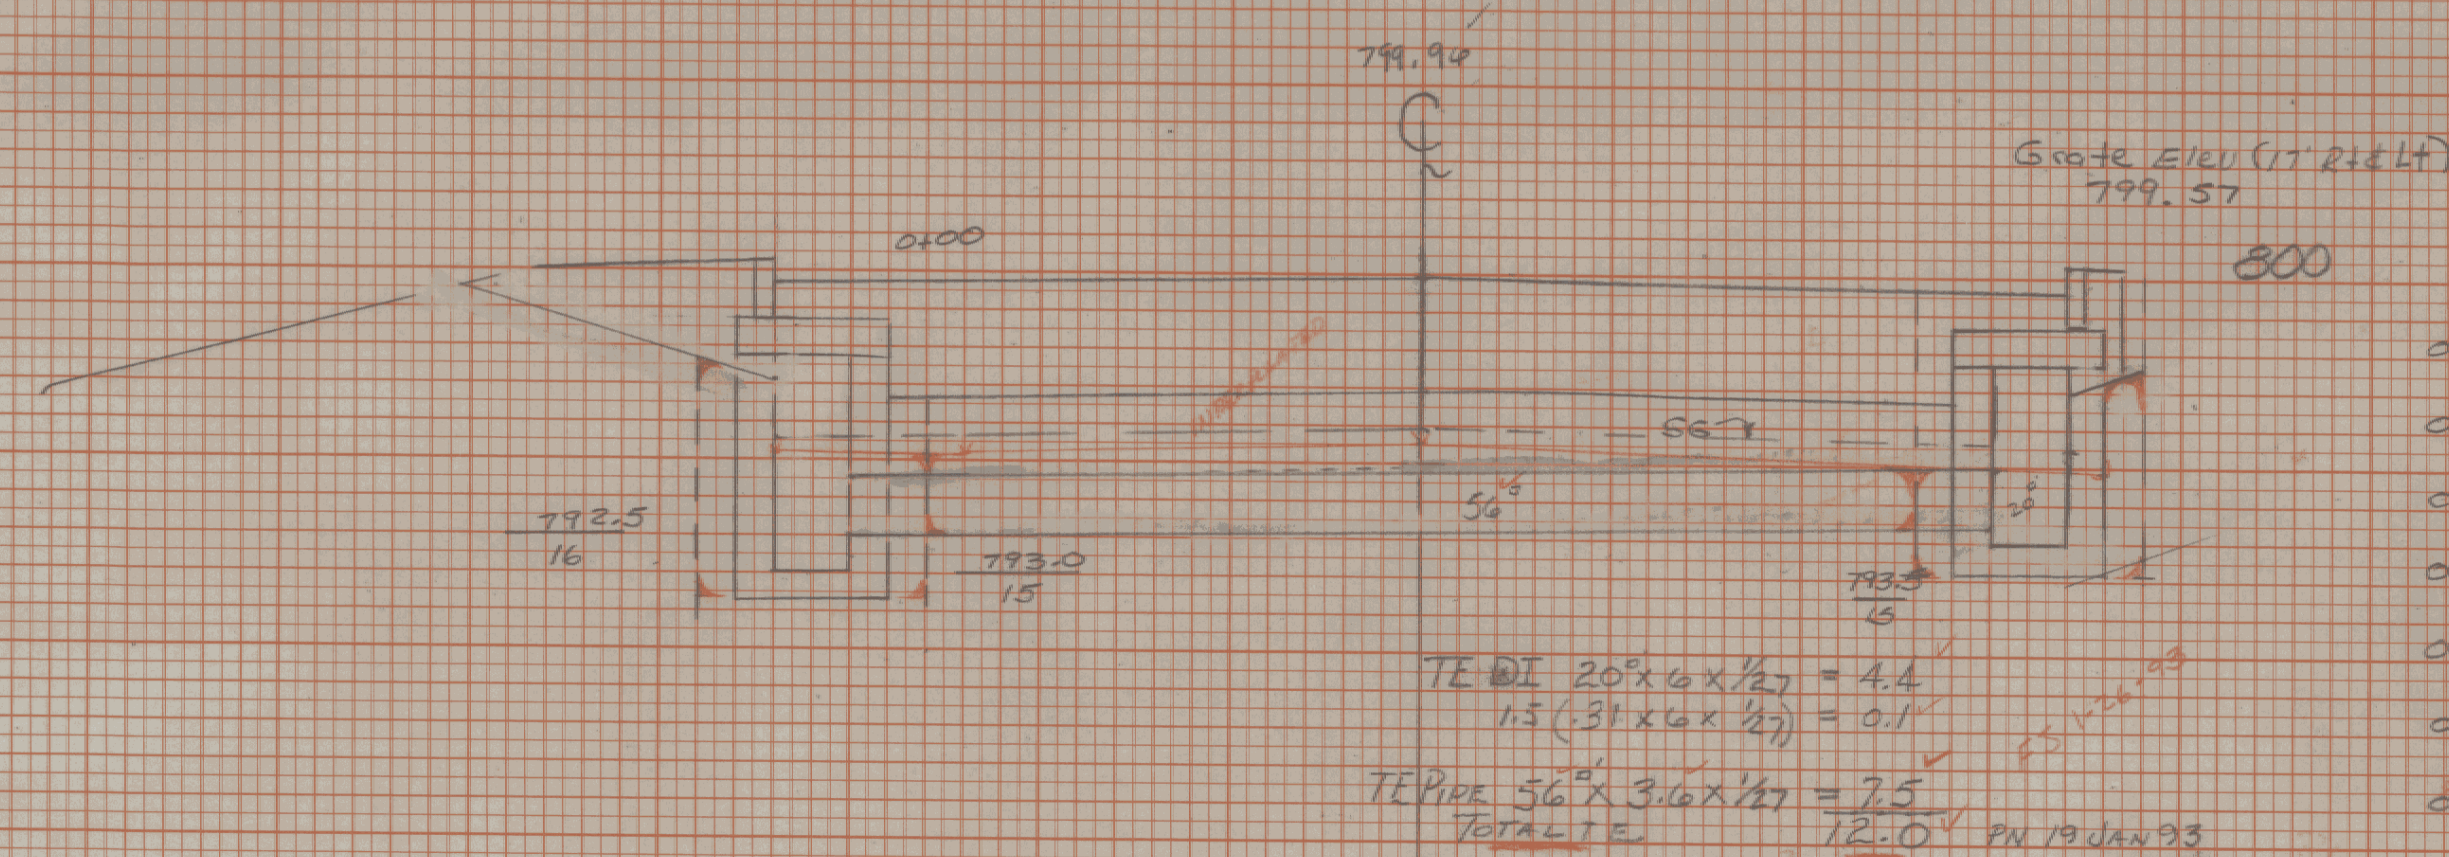


0+00	9.36	4.68
0+13	10.08	4.42
0+26	8.28	3.07
0+30	21.0	2.31
0+30	20.10	
0+30	28.8	
0+32	33.6	

14.48 CY FS 11-03-92

48+05
 New 18"x30" PCCSP
 Book 2-C Page 31

DS 665

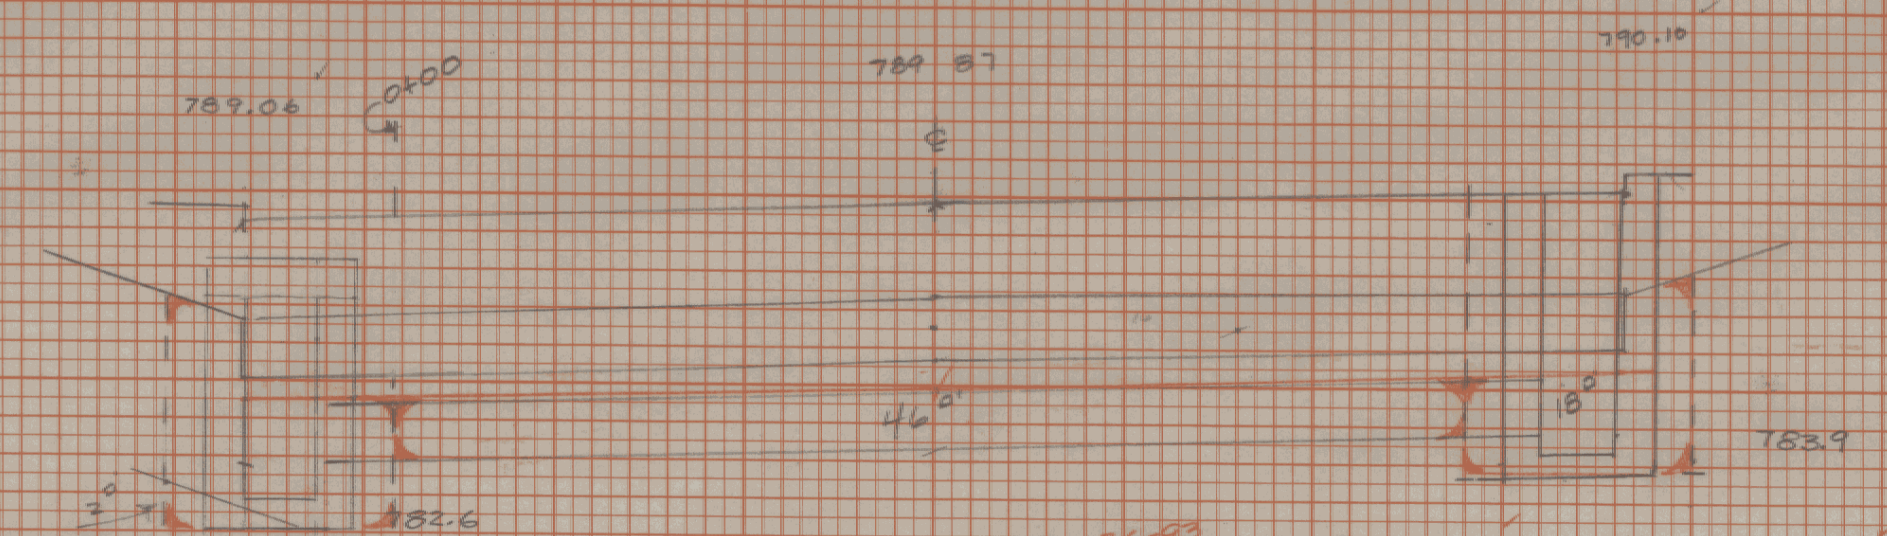


0+00	14.2	8.78	4.45
0+14.2		8.64	4.35
0+28.4		8.28	3.02
0+32.4		29.4	2.27
0+32.4		29.4	
0+39.4		31.8	

14.19 CY FS 11-3-92


DS 645

46"x10" ~ 26"x33"
 New 18"x30" PIPE
 See Book 2-C Page 17

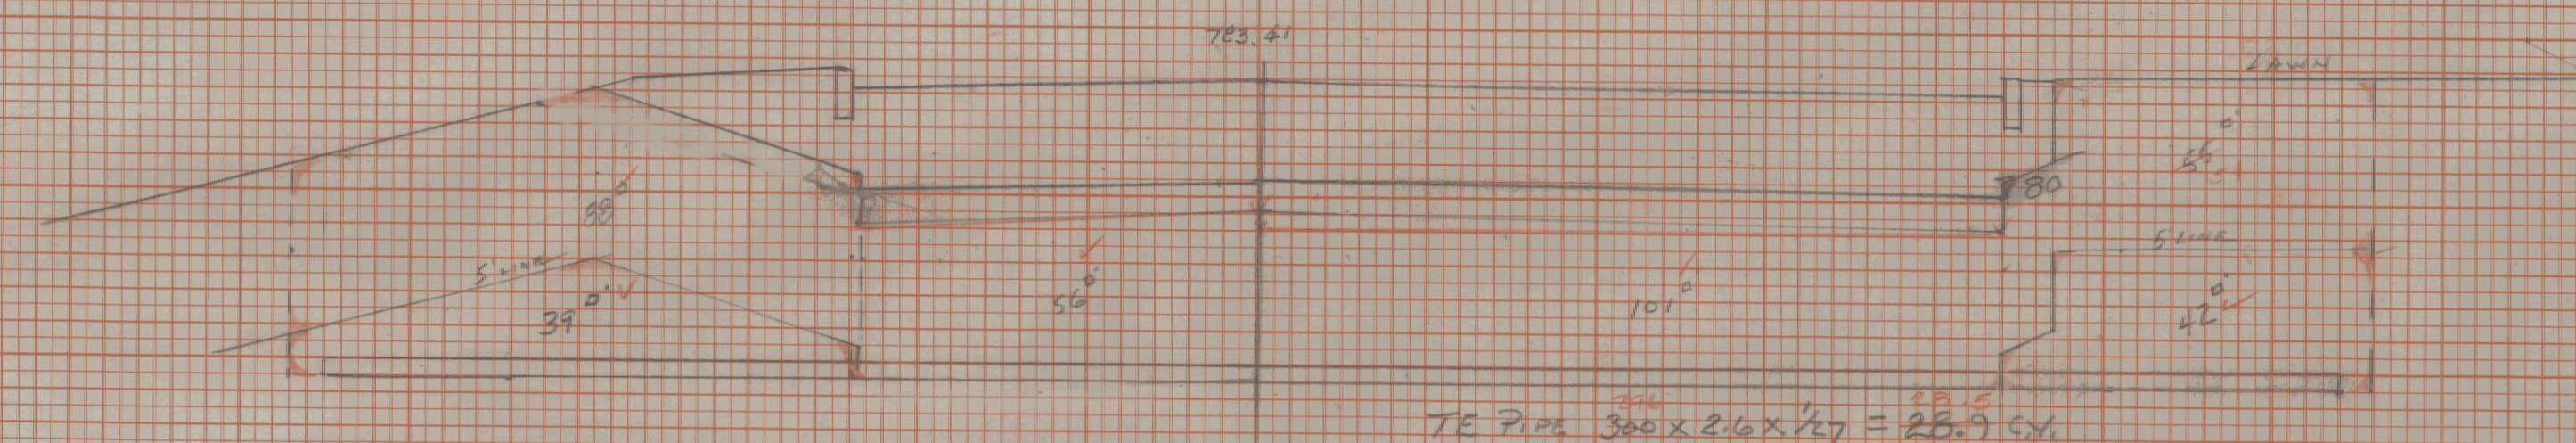

56+40
 New 18"x30" PCCSP
 Book 2-C Pg 89

DS 745

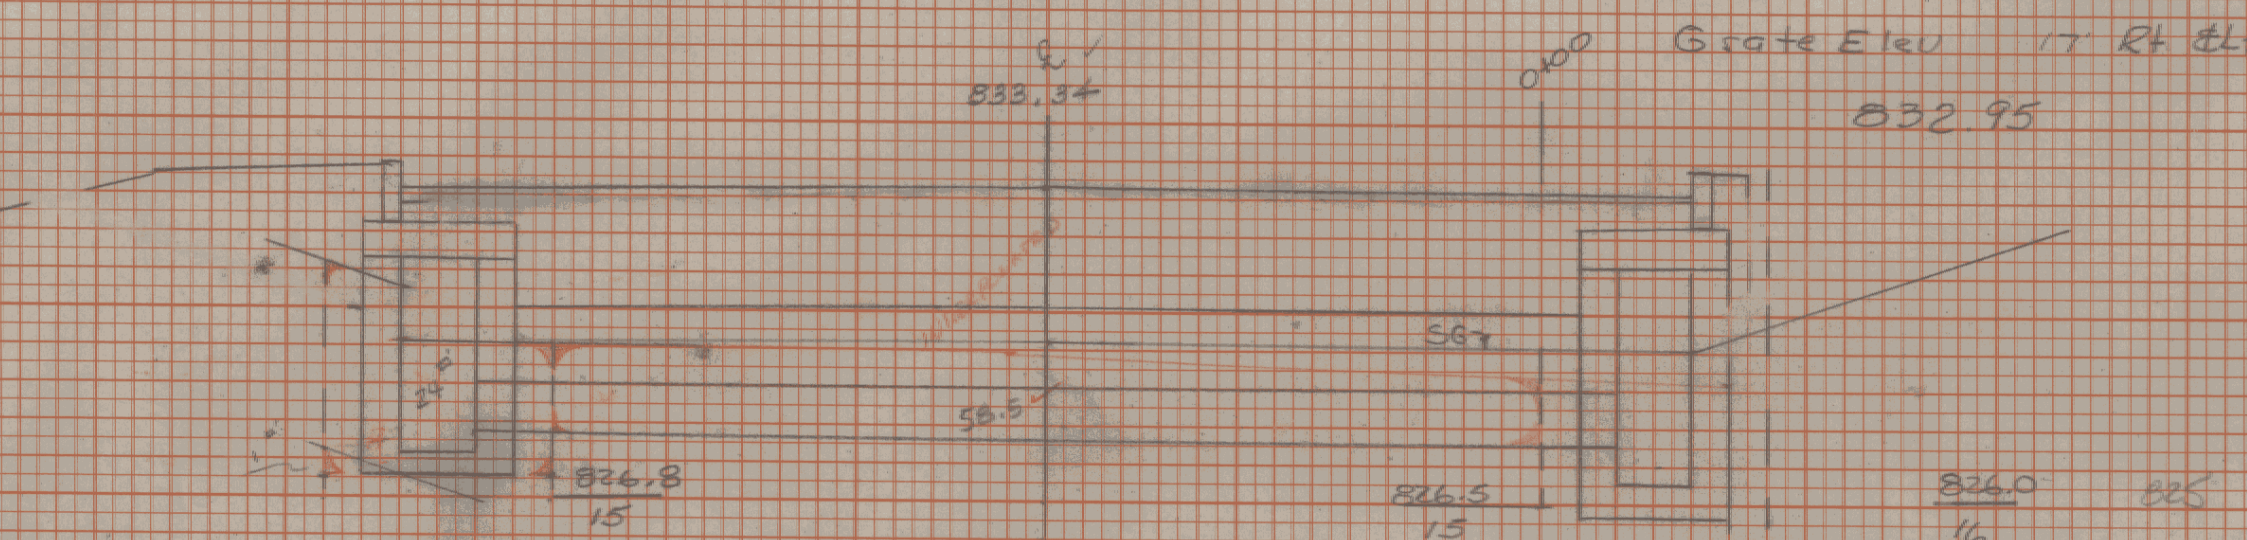


0+00	9.36	4.51
0+13	9.36	4.29
0+26	8.46	3.2
0+30	21.6	2.42
0+30	29.1	
0+32	36.30	

14.42 CY FS 11-03-92

46+00
 New 6"x60" Sleeve for Utilities (Water Line)
 Book 2-C Page 15

DS 640

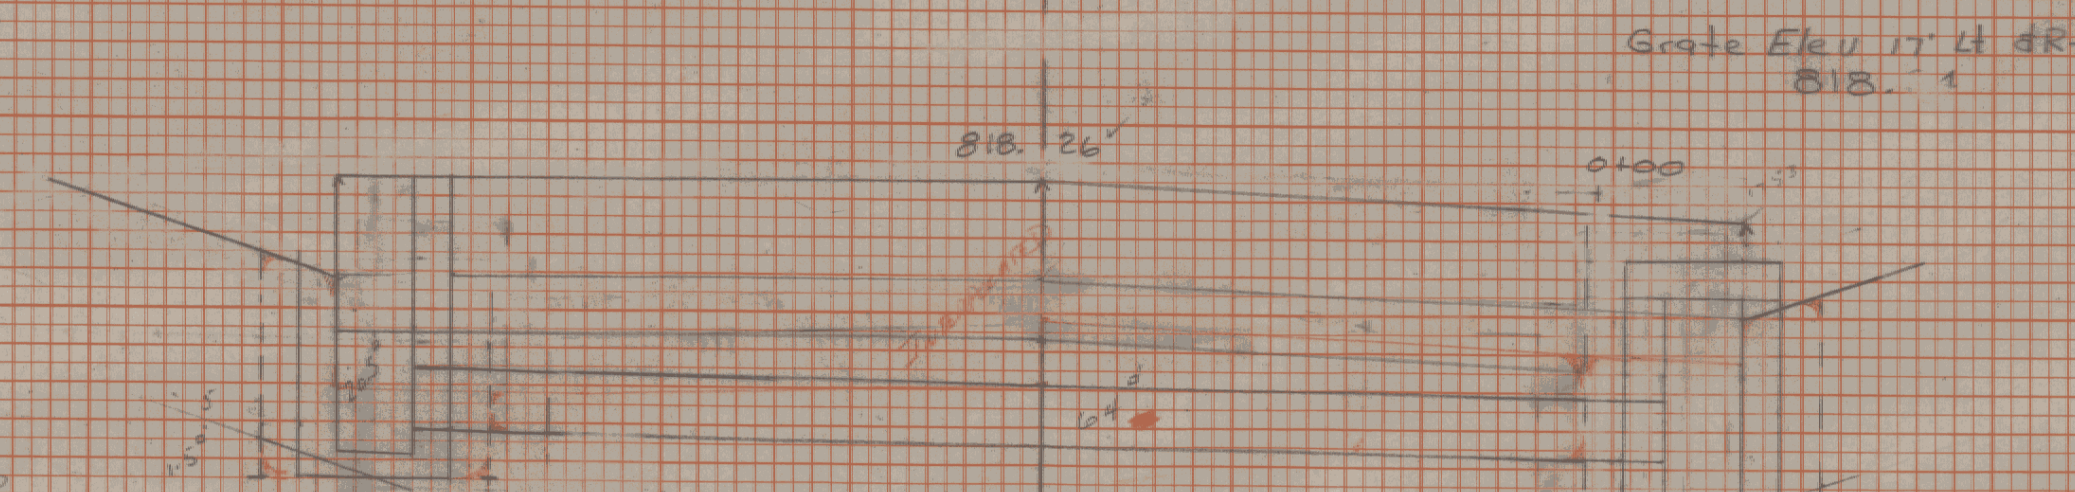


0+00	8.46	4.98
0+14.5	10.08	5.27
0+29.0	9.54	3.42
0+29.0	23.10	2.30
0+33	28.10	
0+35	39.00	

15.97 CY FS 11-03-92

50+85 - 51+00
 New 78"x38" PCCSP
 Book 2-C Pg 71

DS 720

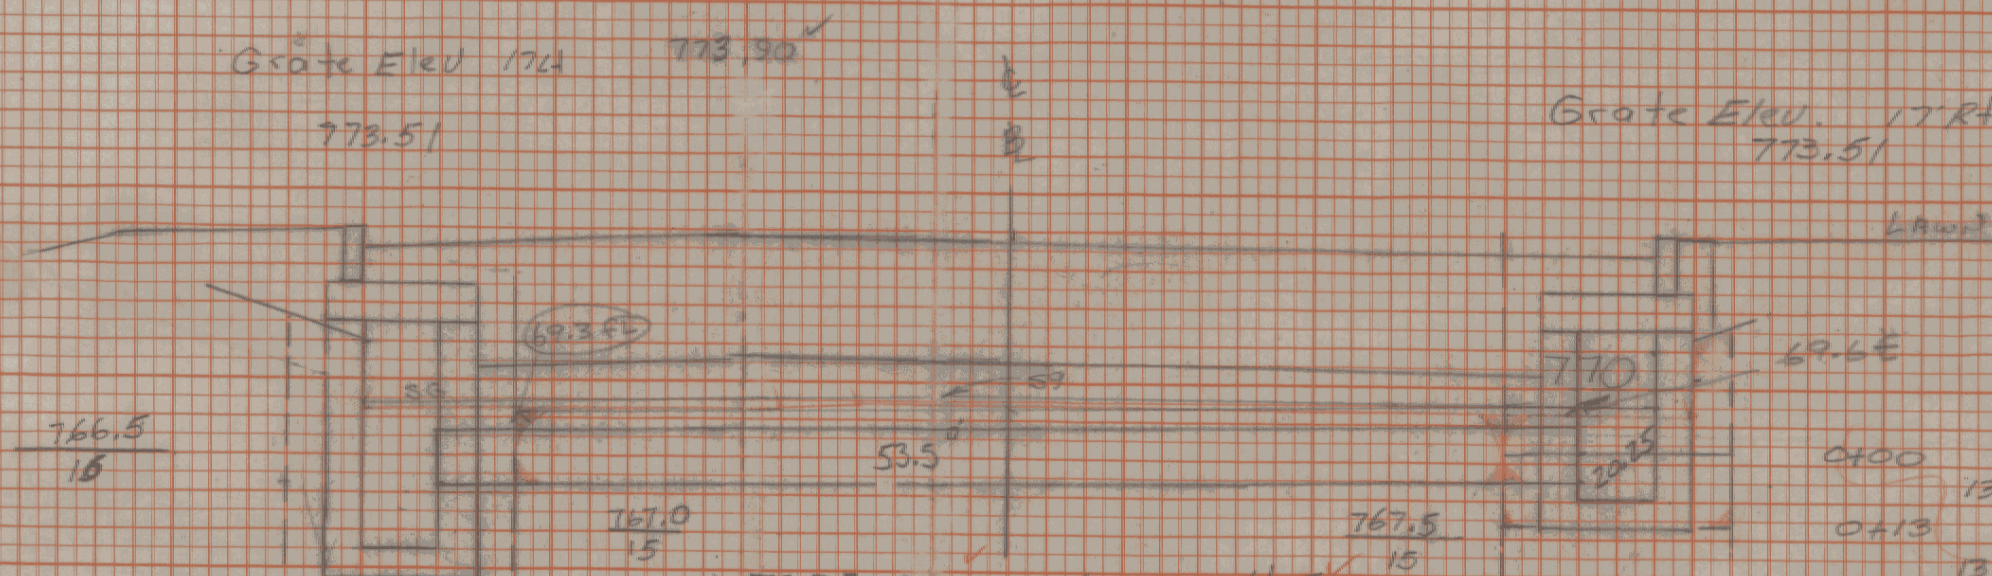


0+00	13	0.69
0+13	1.44	0.32
0+26	0.72	
0+30	7.8	1.15
0+30	2.3	
0+30	19.9	
0+32	19.8	

36.6 CY FS 11-03-92

45+00
 New 18"x30" PCCSP
 Book 2-C Page 9

DS 630

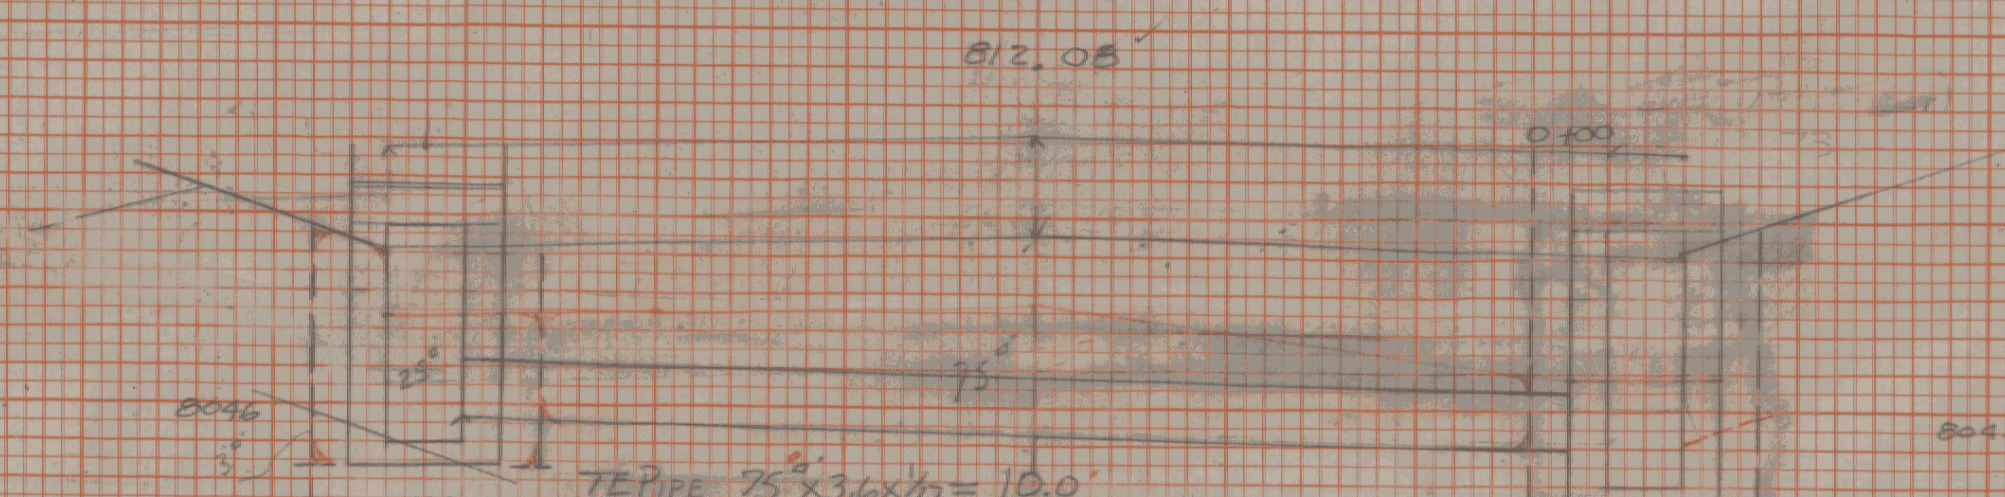

0+00	13.96	5.25
0+13	12.96	3.81
0+26	16.16	3.82
0+30	25.8	
0+30	31.2	
0+32	41.7	

15.87 CY FS 11-03-92

75+45 - 75+75
 New 78"x38" PCCSP
 Book 2-C Page 51

DS 685

MONTPIELER
 MEGAN 6400(7)

DRINKER STREET 6

341 DS