


FINAL SURVEY NOTE BOOK No. \_\_\_\_\_ DATE \_\_\_\_\_ BY \_\_\_\_\_

ORIGINAL SURVEY NOTE BOOK No. \_\_\_\_\_ DATE \_\_\_\_\_ BY \_\_\_\_\_

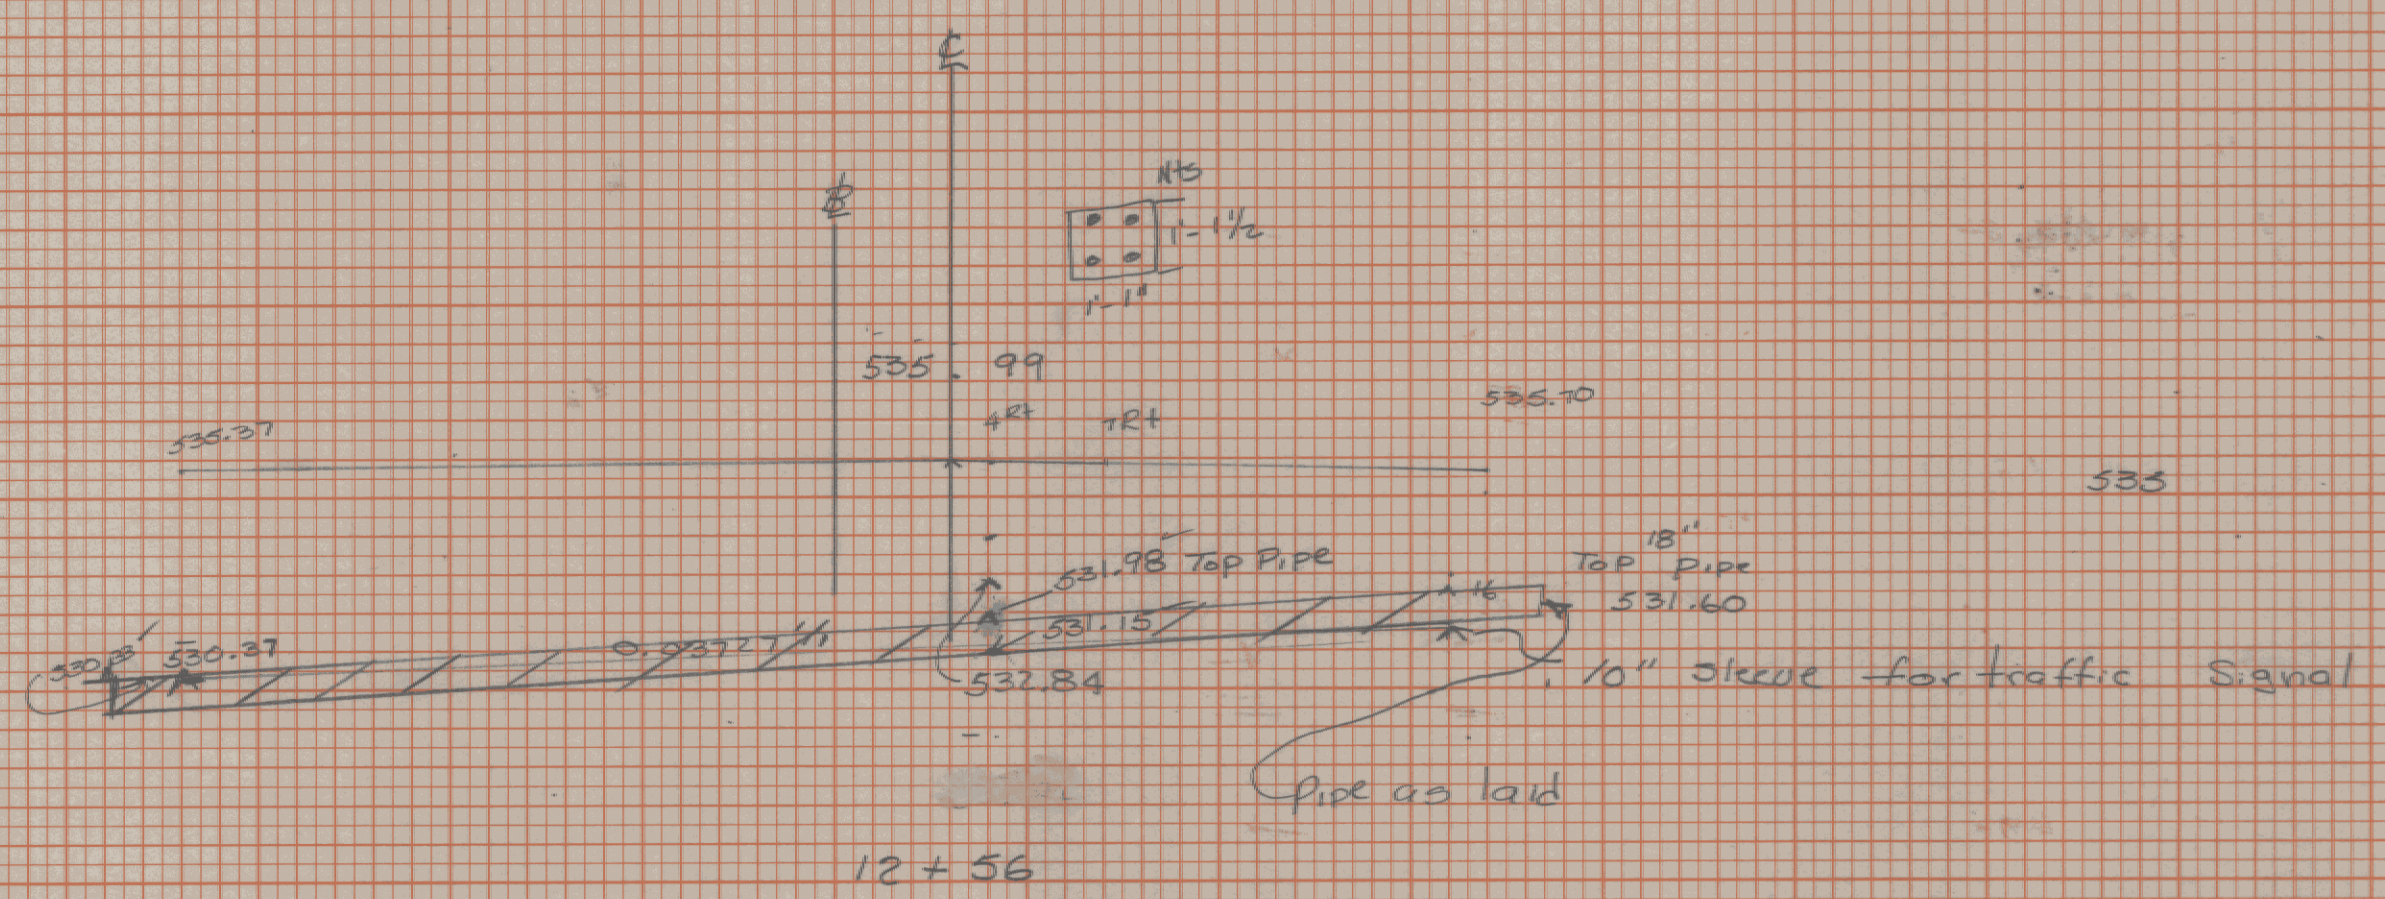

1- 1" dia  
1- 1/2" H+3H

5  
16  
18  
34

M. D. P. 100