




Struct Excav.
A: 43.7
B: 44.4
44.0

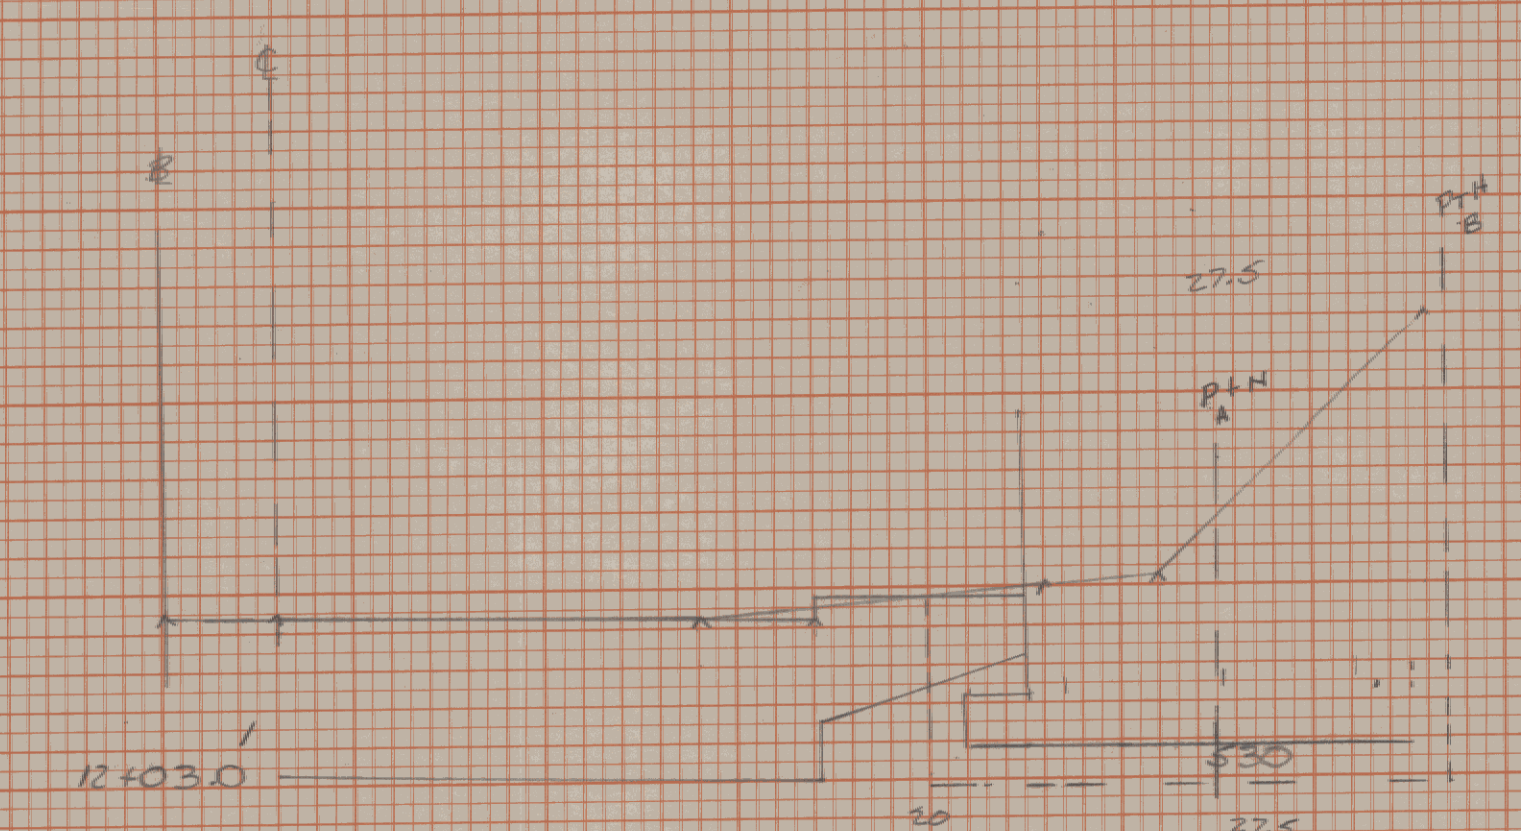


str AB 39.3
str AA 41.5
35.7

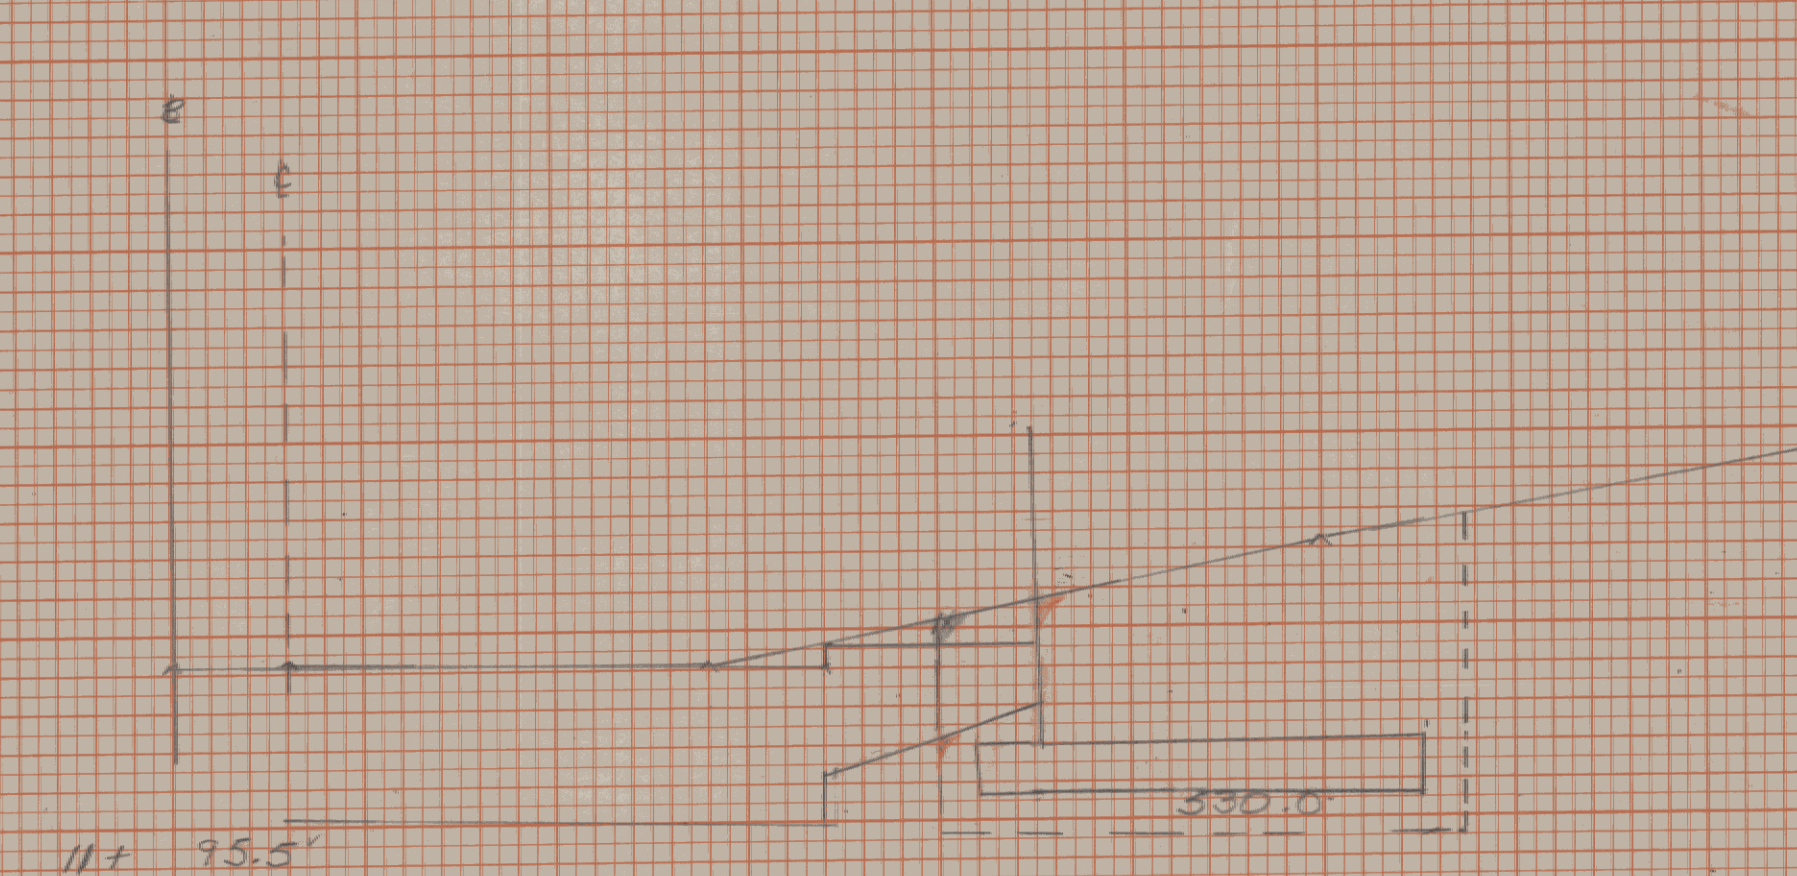


Area = 35.0

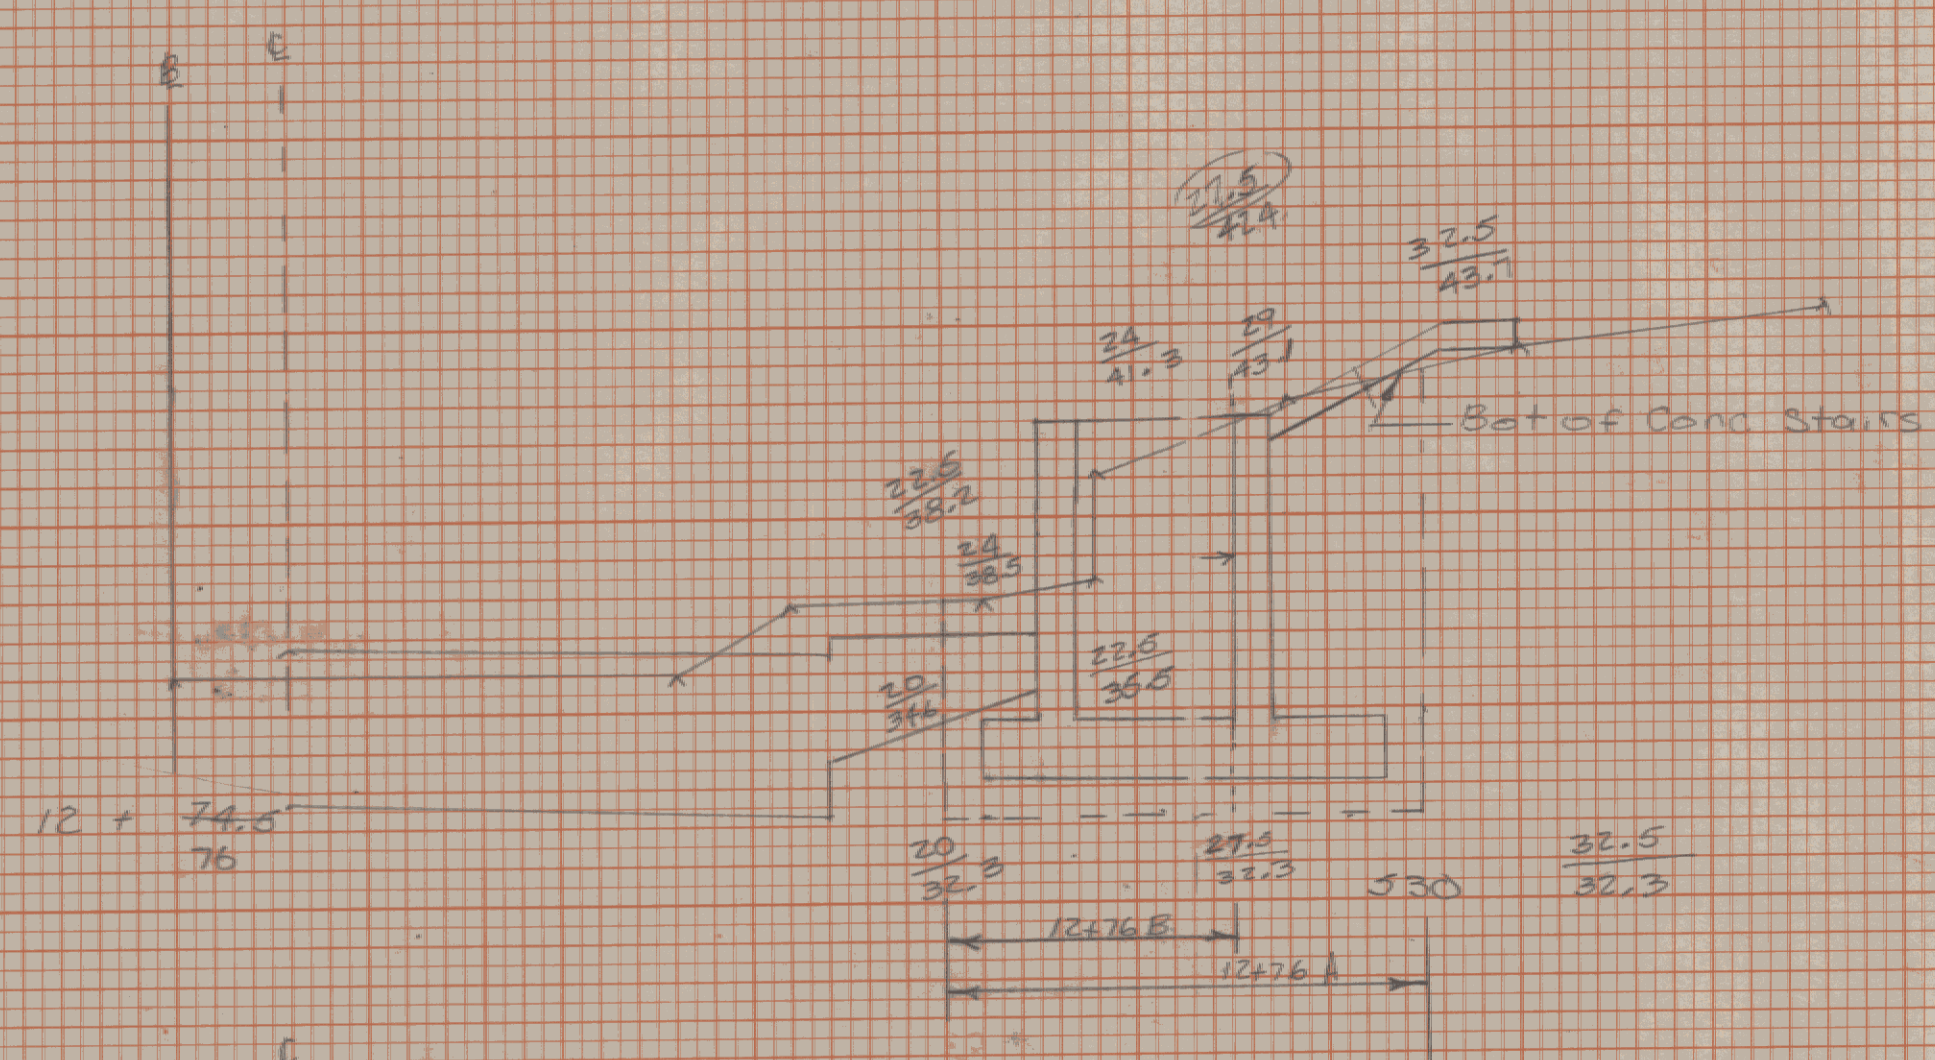

Structure Excavation = 104.3
49.4 B

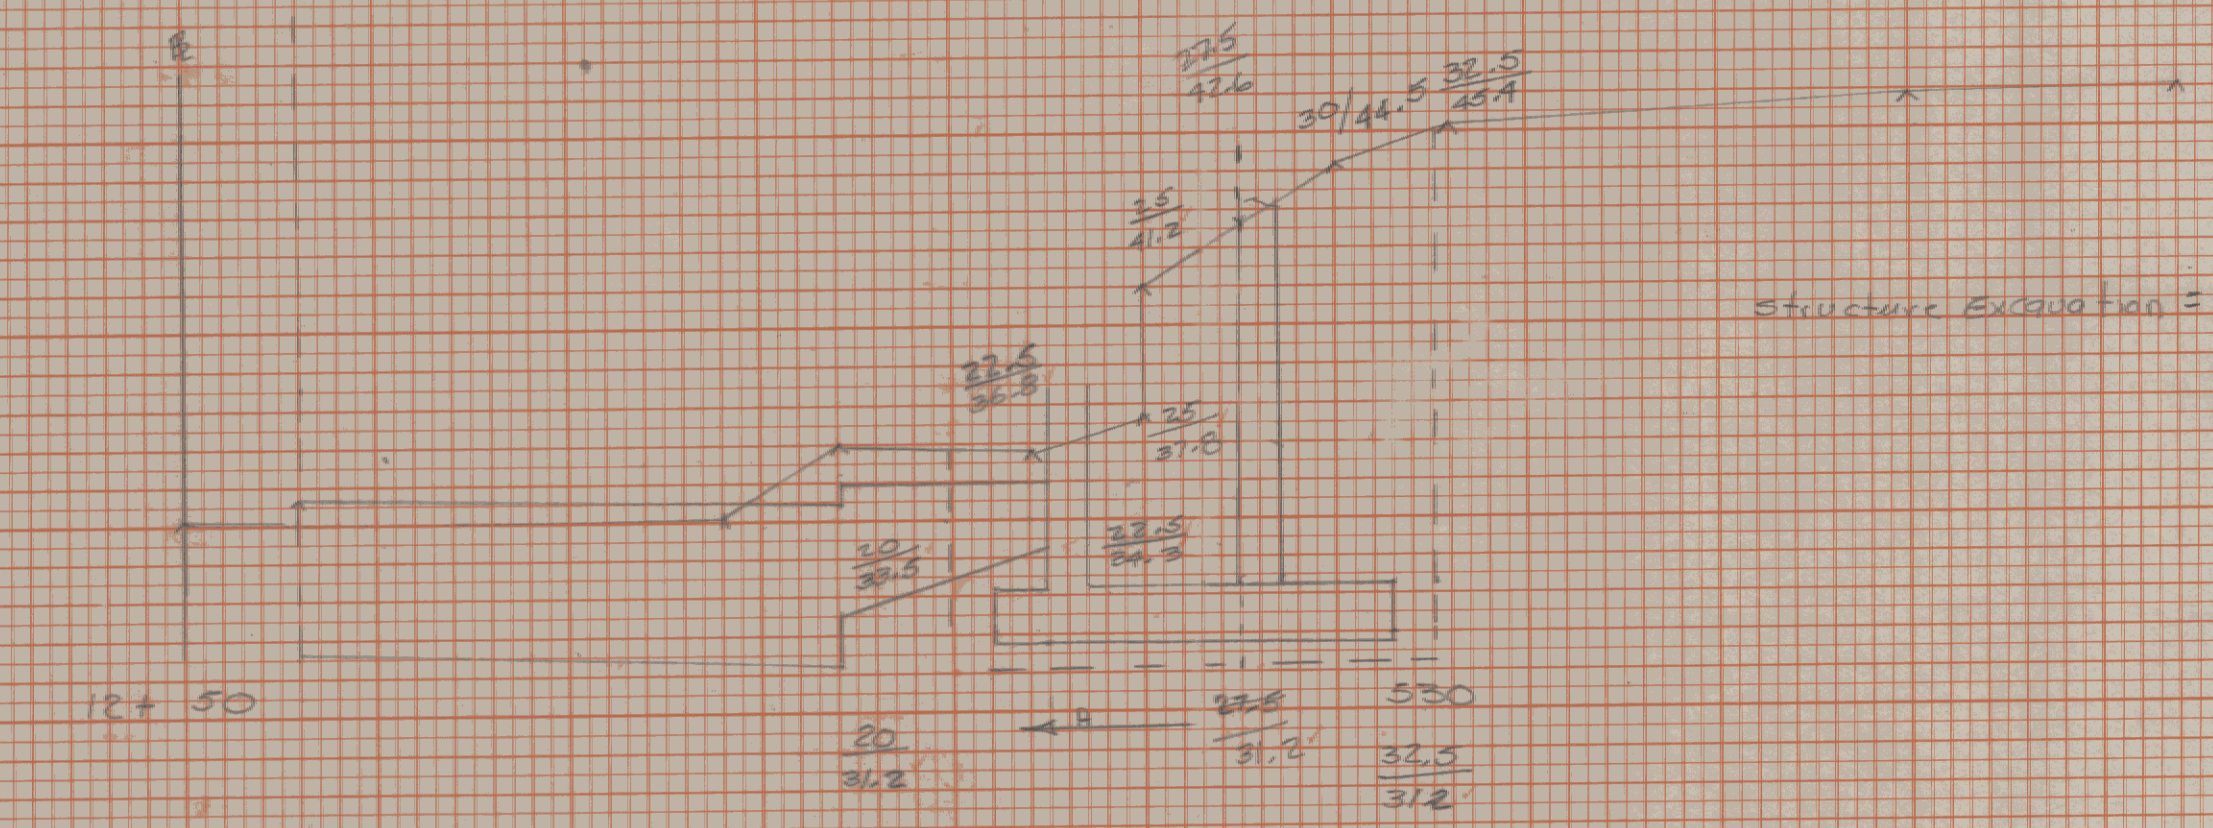

Structure Excavation = 48.8 A
114.6 B

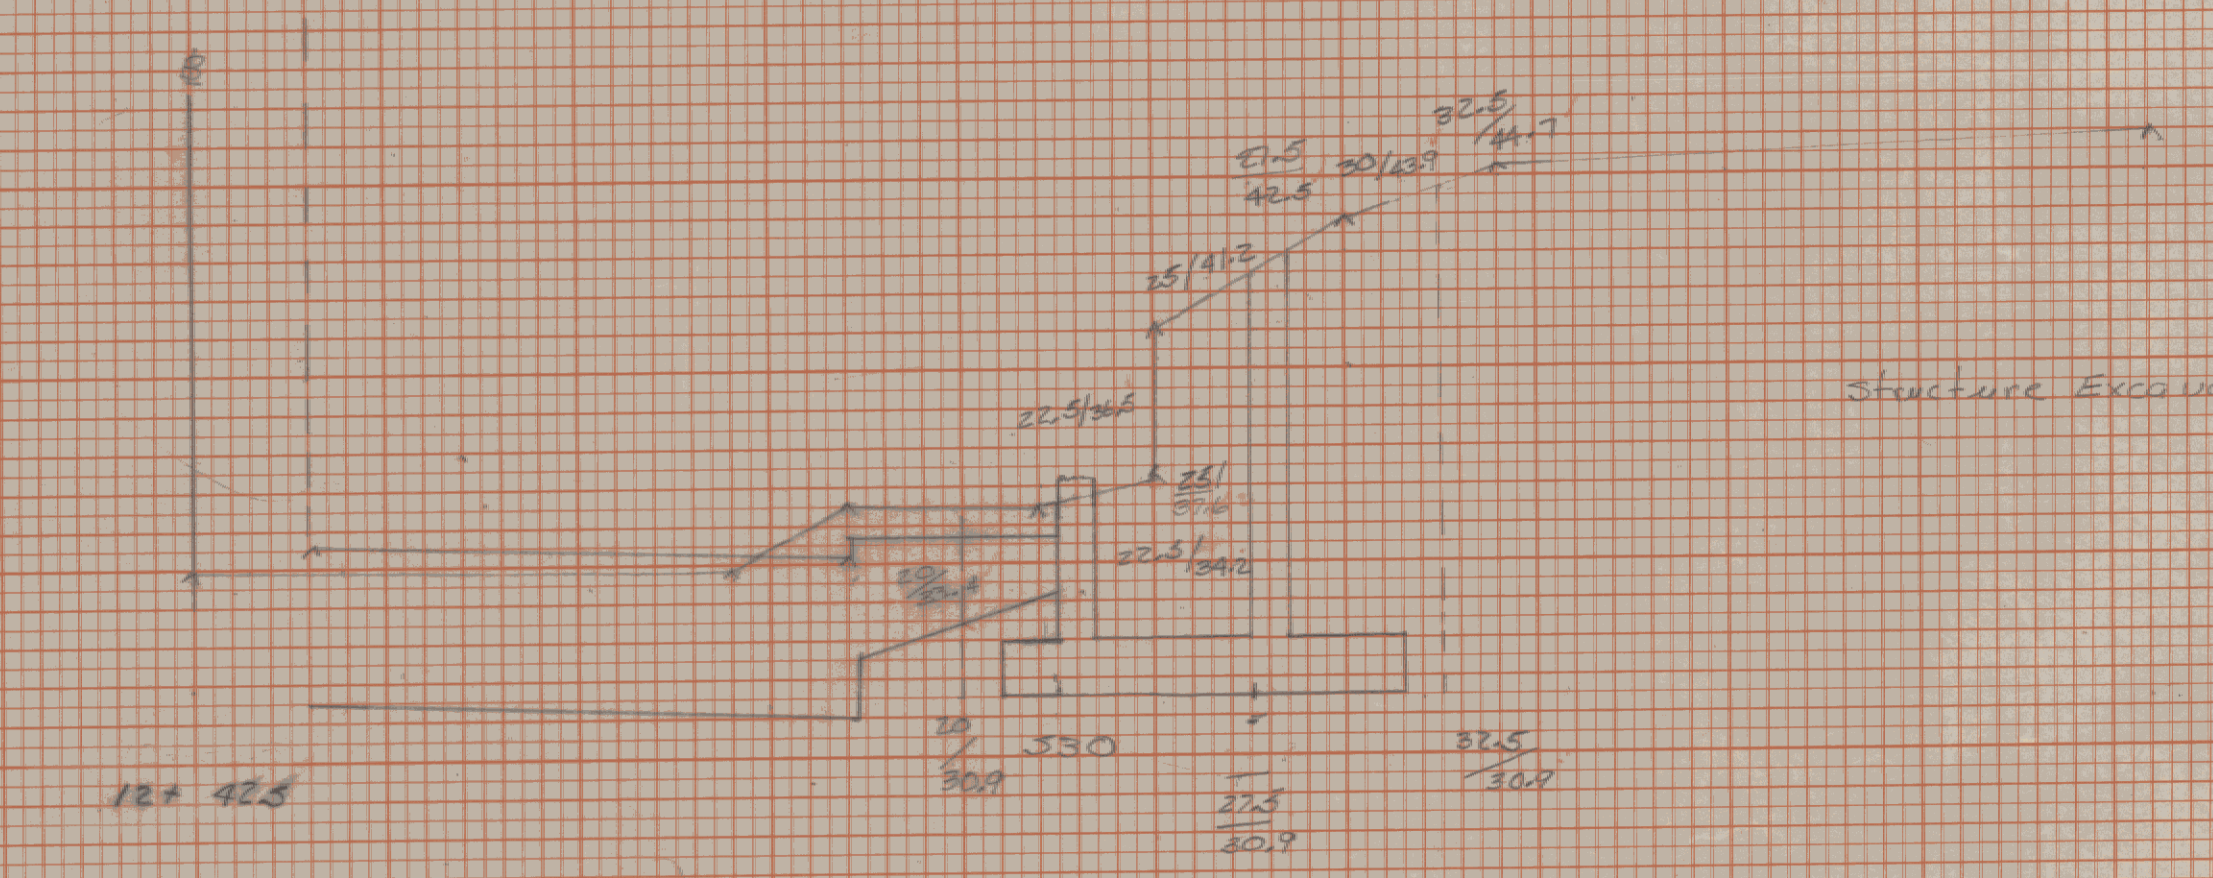

Structure Excavation = 114.4 A

Structure Excavation			
11+95.5	7.5	95.0	21.0
12+03 B	21	41.5	33.4
12+03 A	21	41.5	33.4
12+24 B	21	41.5	33.4
12+24 A	21	41.5	33.4
12+42.5	18.5	114.4	72.7
12+50 B	7.5	114.6	31.8
12+50 A	26	49.8	47.2
12+76 B	26	49.8	47.2
12+76 A	1A	104.3	52.2
12+90 B	6.5	176.3	43.0
12+90 A	6.5	176.3	43.0
12+96.3	6.5	176.3	43.0
Total Structure wall #2		301.6	305.2 cy FS

Book 2 Page 9
DN 8 FEB 93

Maripeles MEGC (1640061)
Wall #2 11+98-12+96
Structure sections