
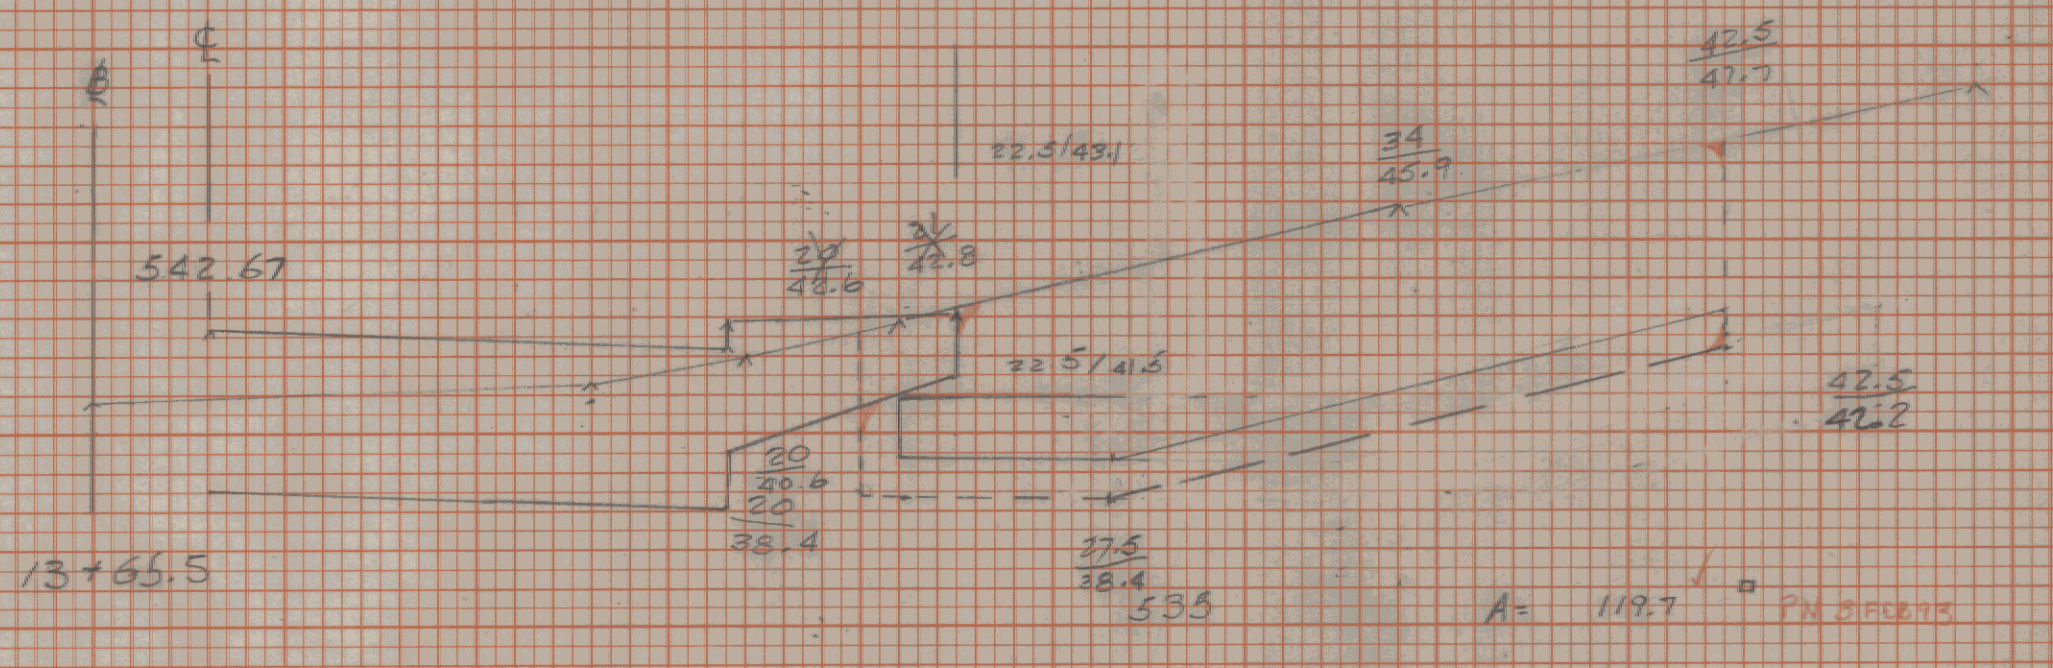
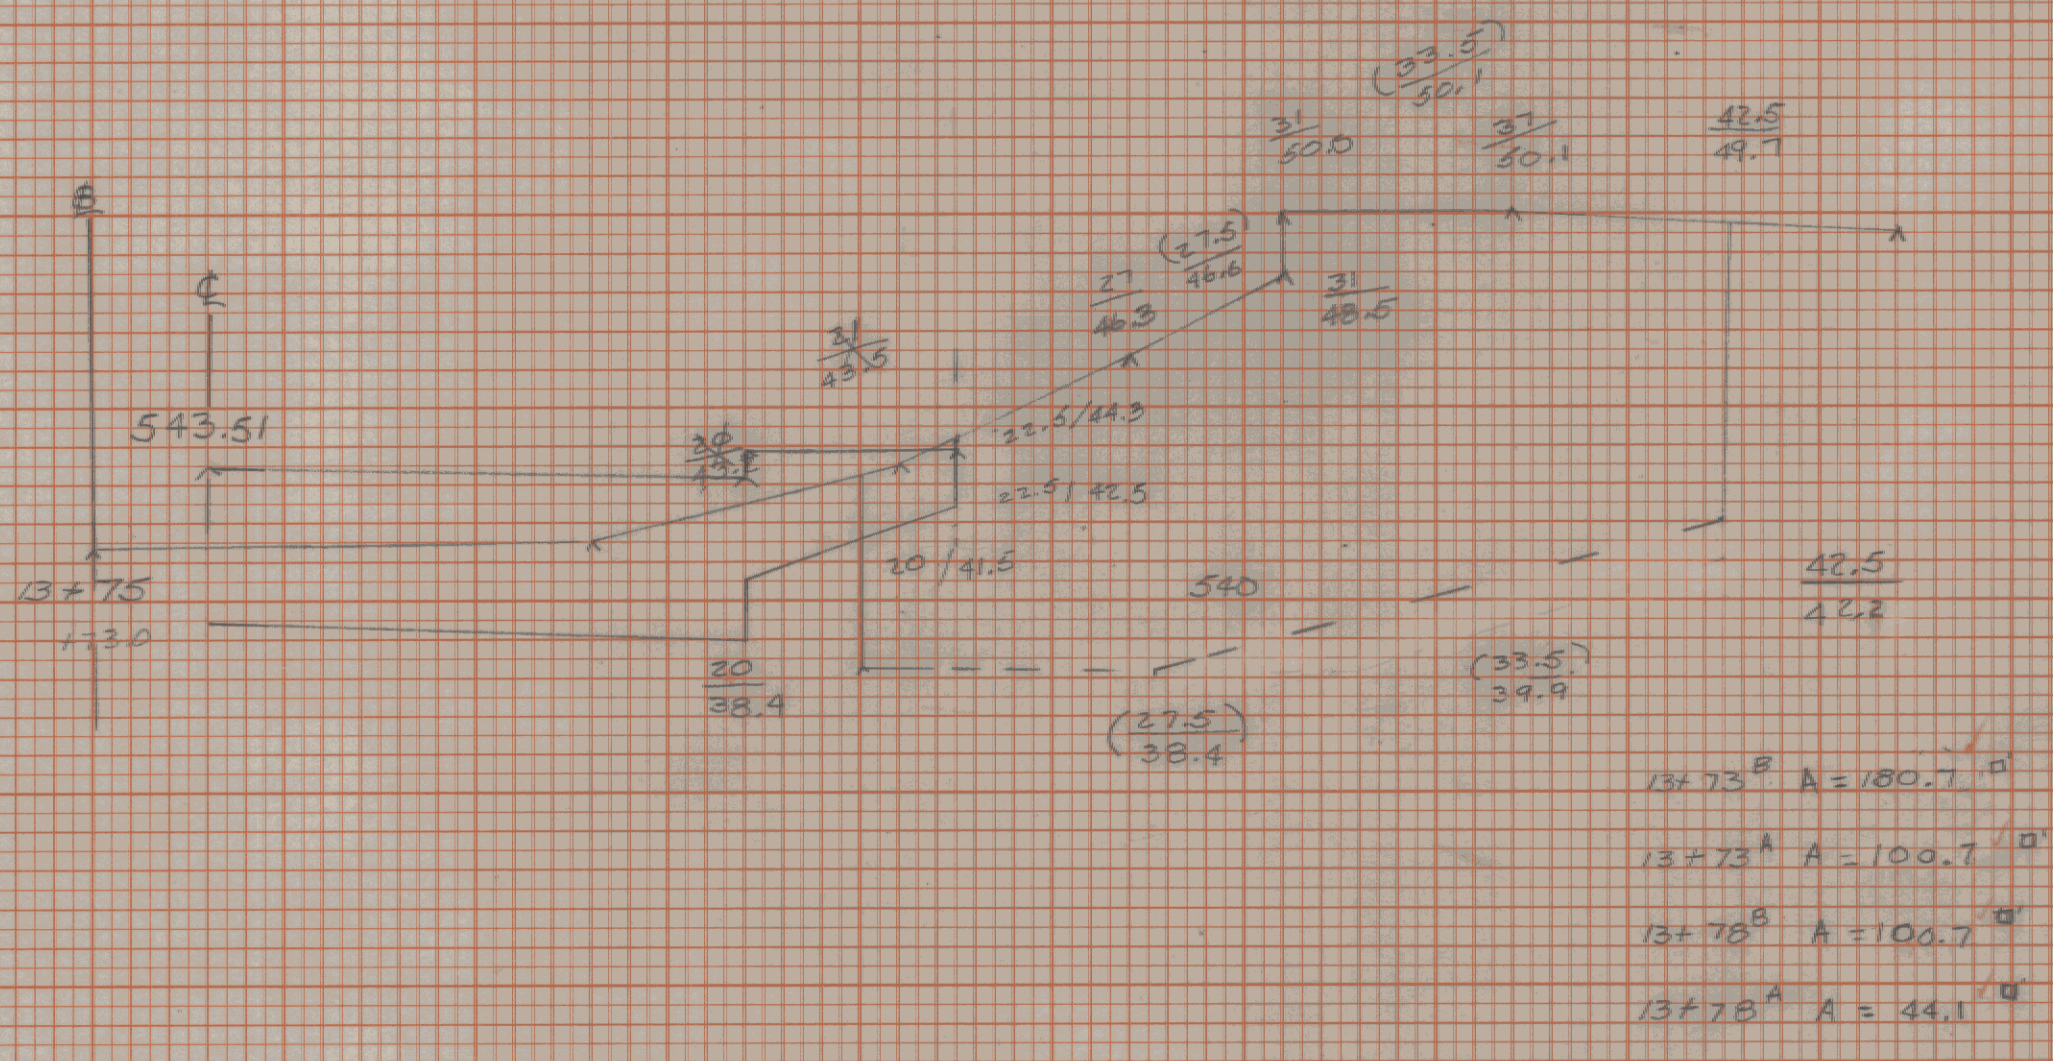
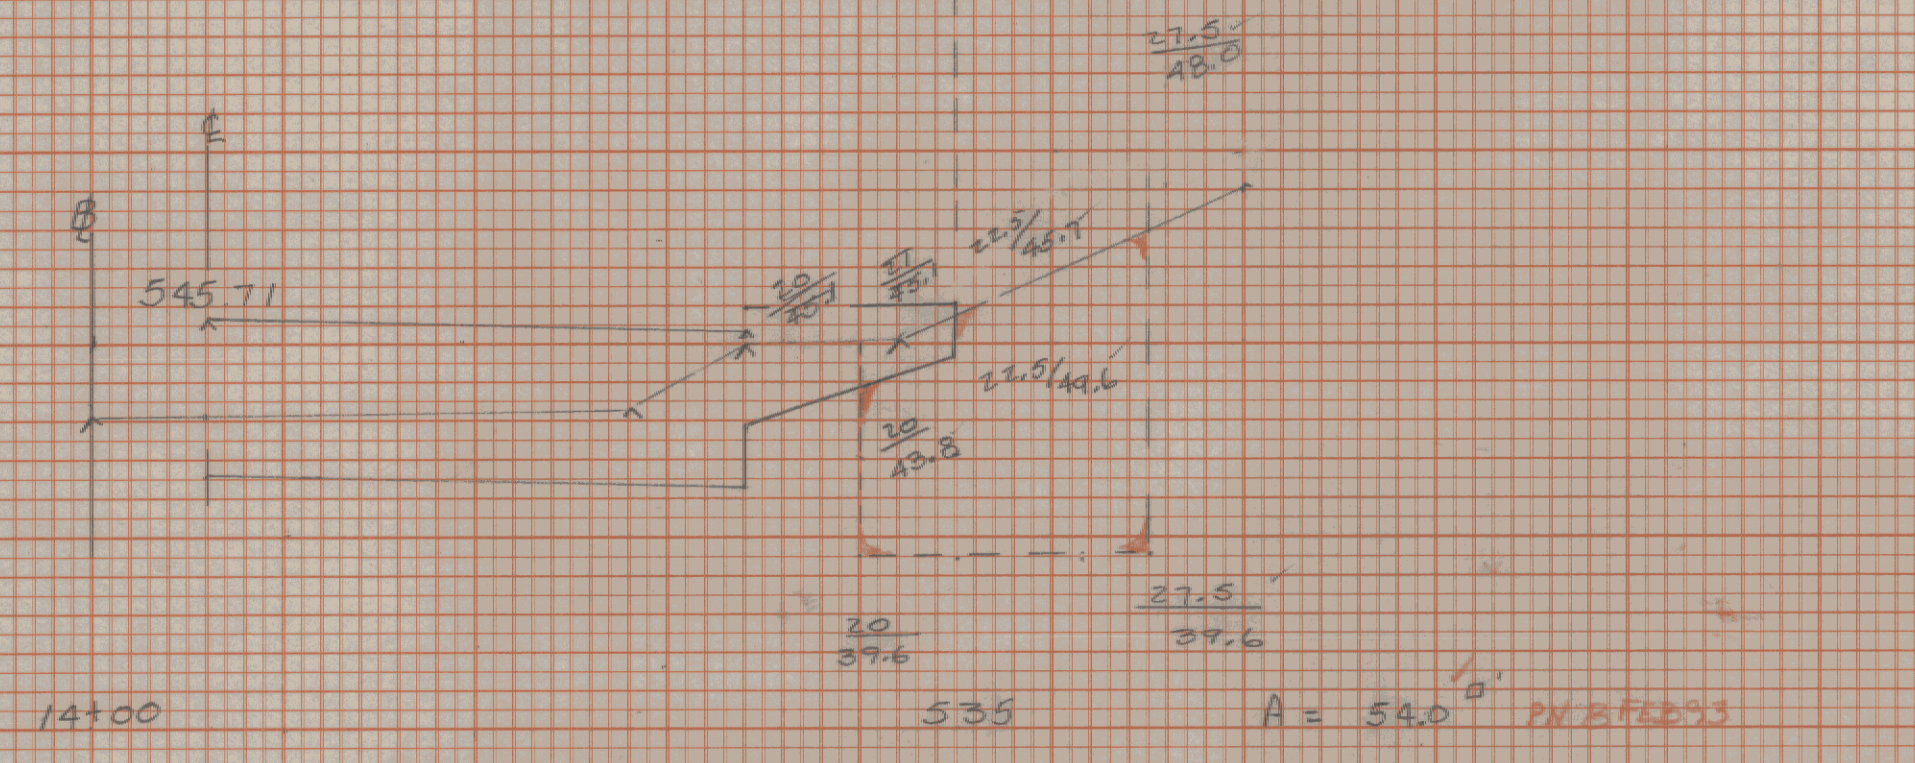


DATE
BY
SURVEYING
ALIGNED
TEMPLATE
NOTE BOOK
NO.

DATE
BY
SURVEYING
ALIGNED
TEMPLATE
NOTE BOOK
NO.

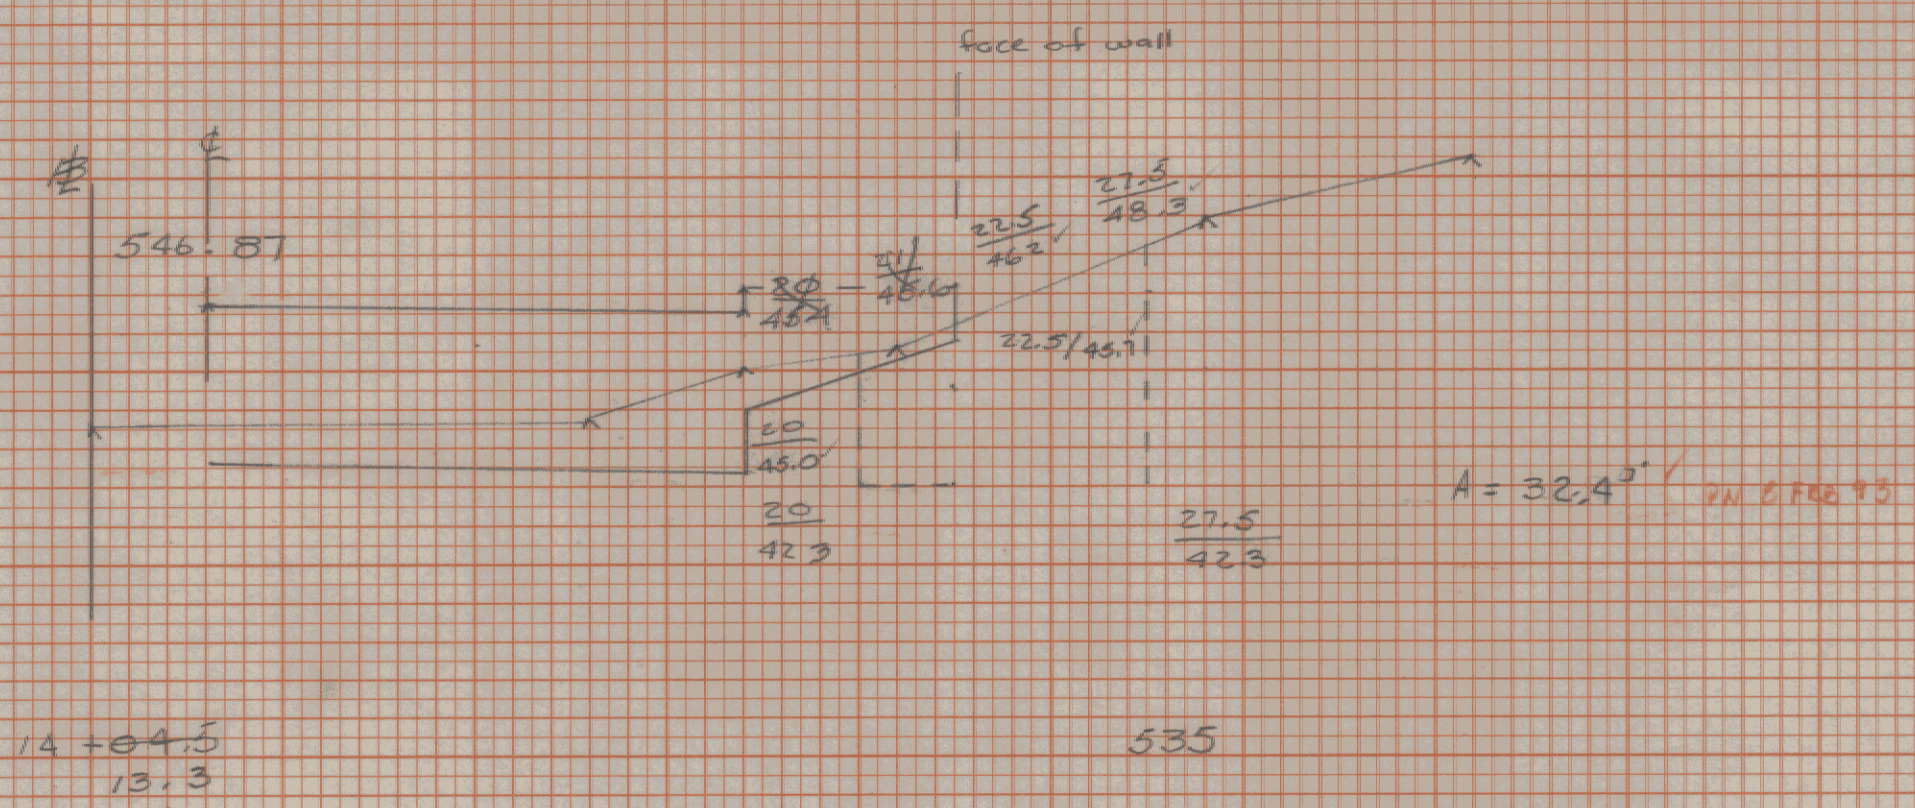

Sta	Structure Area	Excavation Vol.
13+65.5	119.7	41.7
13+73 B	180.7	
13+73 A	100.7	18.6
13+78 B	100.7	
13+78 A	44.1	
14+00	54.0	40.0
14+13.3	32.4	21.5
	47.8	
		121.6 FS 12-14-71

- 13+73^B A = 100.7
- 13+73^A A = 100.7
- 13+78^B A = 100.7
- 13+78^A A = 44.1

Book 3 Page 9

Scale 1" = 5'

Montpelier MEGGM 6400 (7)
Wall # 4 structure sections